


451-N

Henry and Ceceilia Schmitz D-Vol. 272 Pg. 336 Feb. 2, 1935

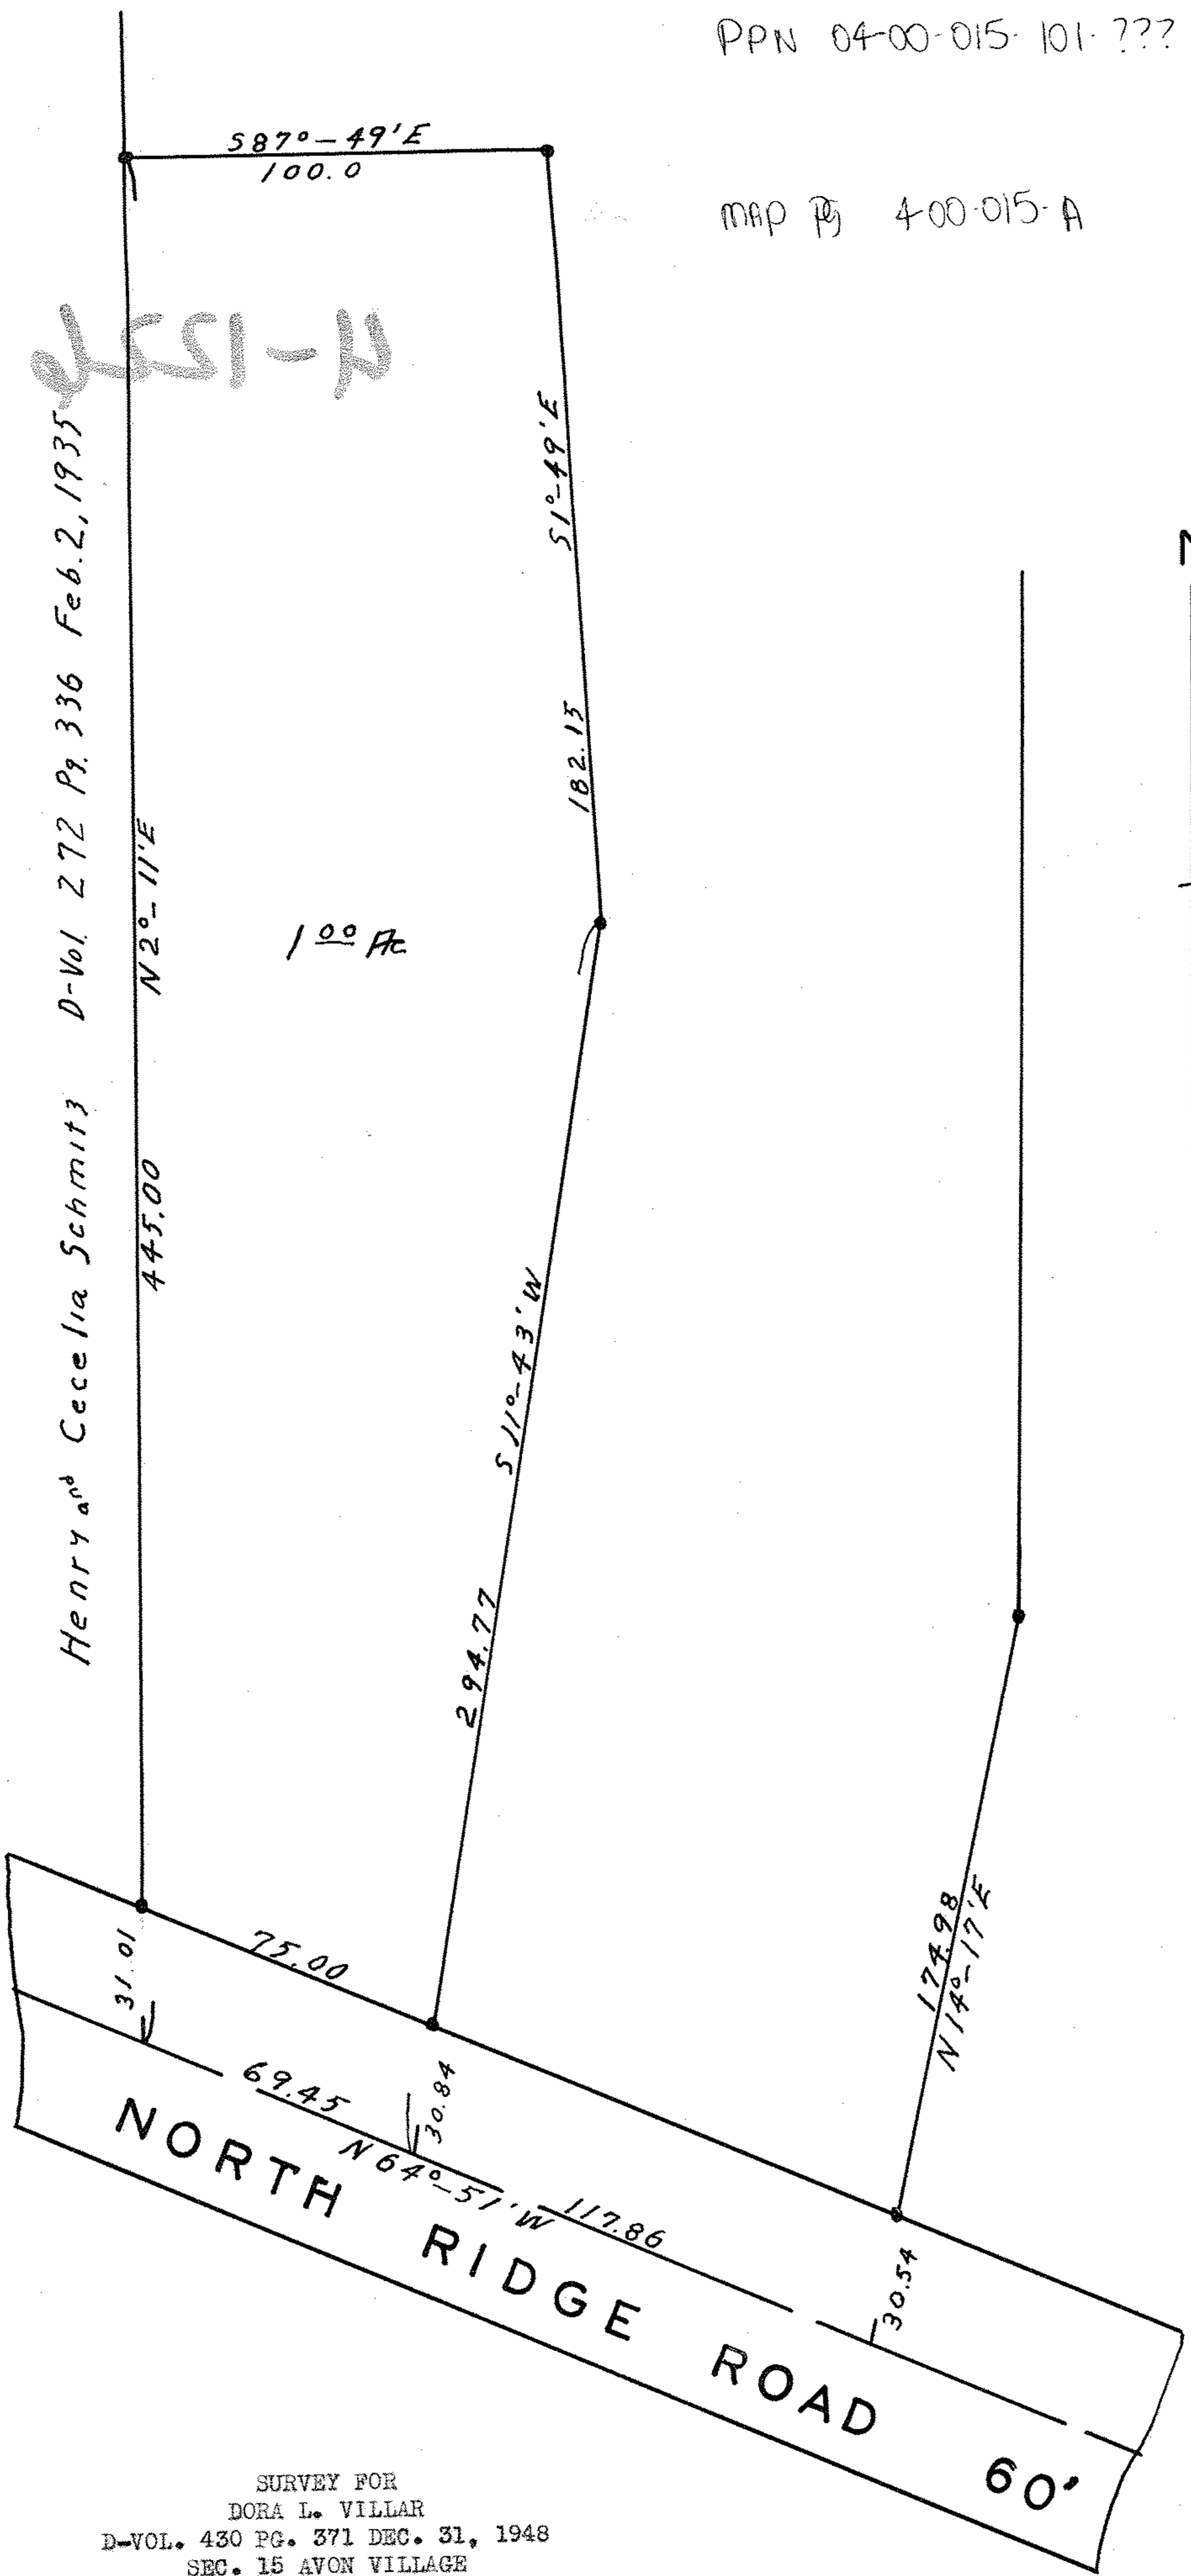

SURVEY FOR
 DORA L. VILLAR
 D-VOL. 430 PG. 371 DEC. 31, 1948
 SEC. 15 AVON VILLAGE
 LORAIN COUNTY, OHIO
 SCALE 1" = 40' AUG. 19, 1955
 J. W. WARDEN AND ASSOCIATES REG. SURVEYORS

Iron Pins found or set at all points indicated thus ●

H-1226