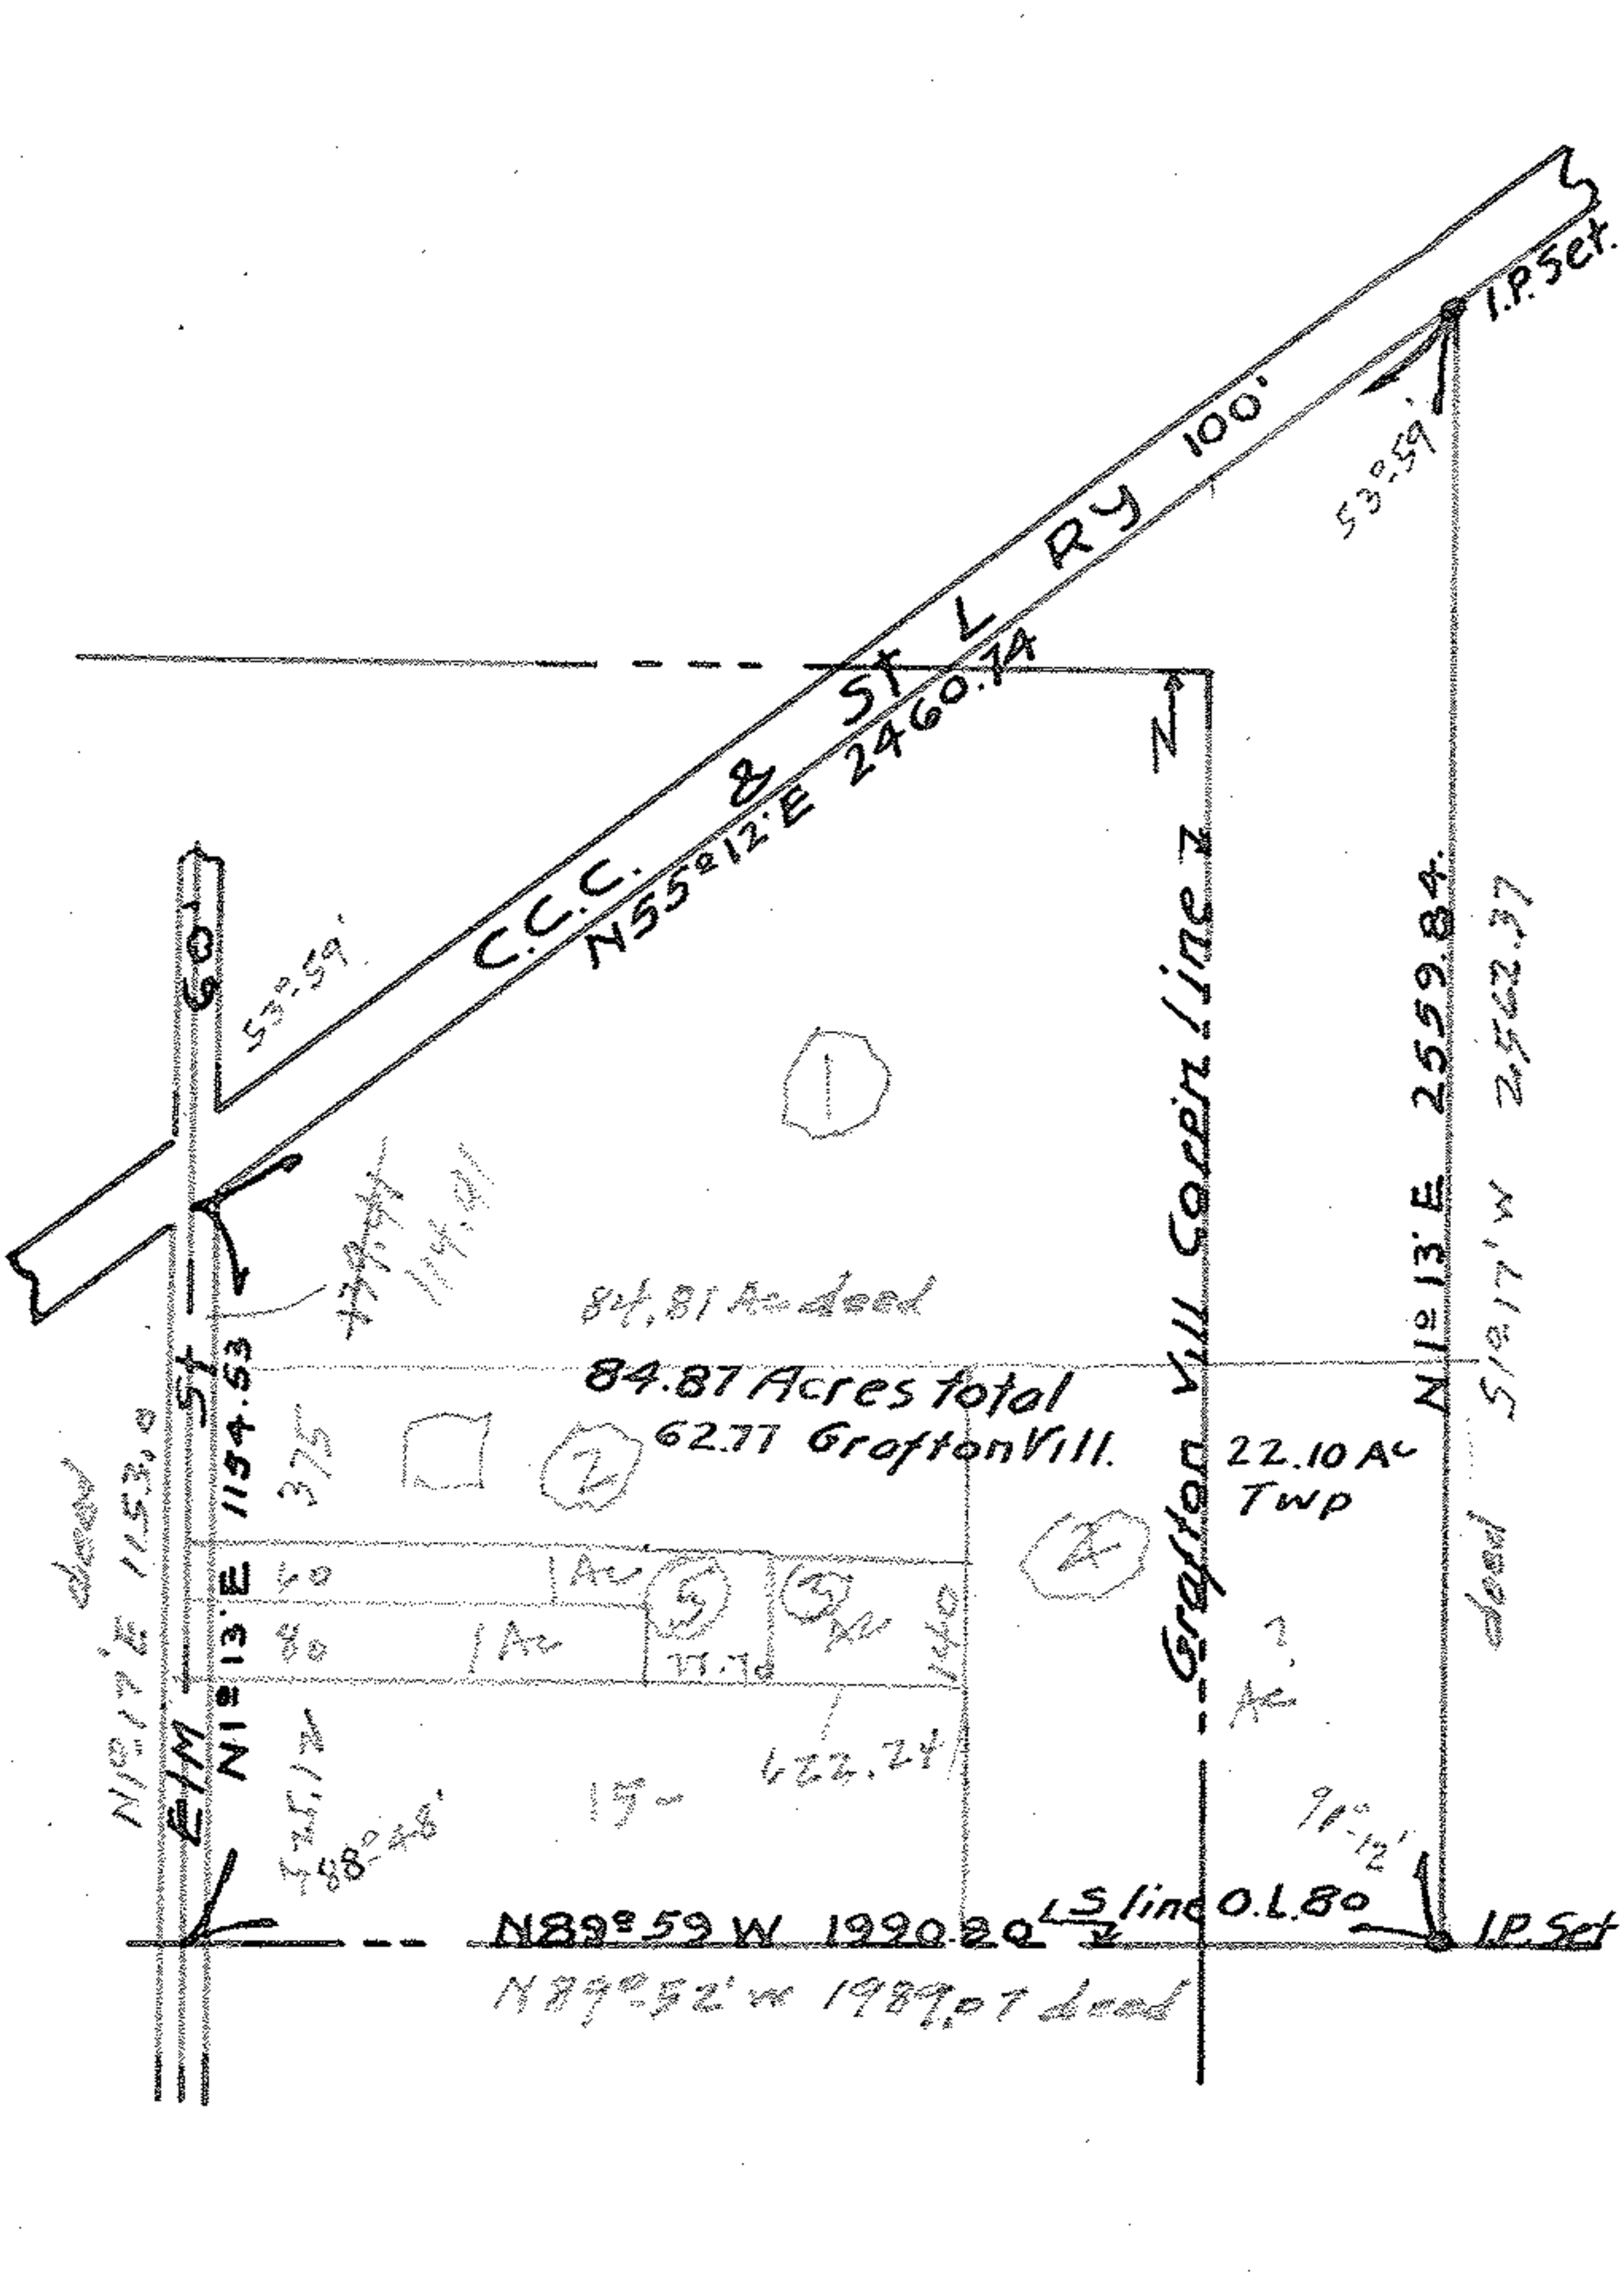

Survey of Bonnie E Rust Farm
Part of Original Lot 80 Eaton Twp. Lorain Co. Ohio
Lying partly within Grafton Village Corporation
Scale 1" = 500' Jan. 2. 1934. T W Laundon Surveyor