279-48 Oct-12-1936

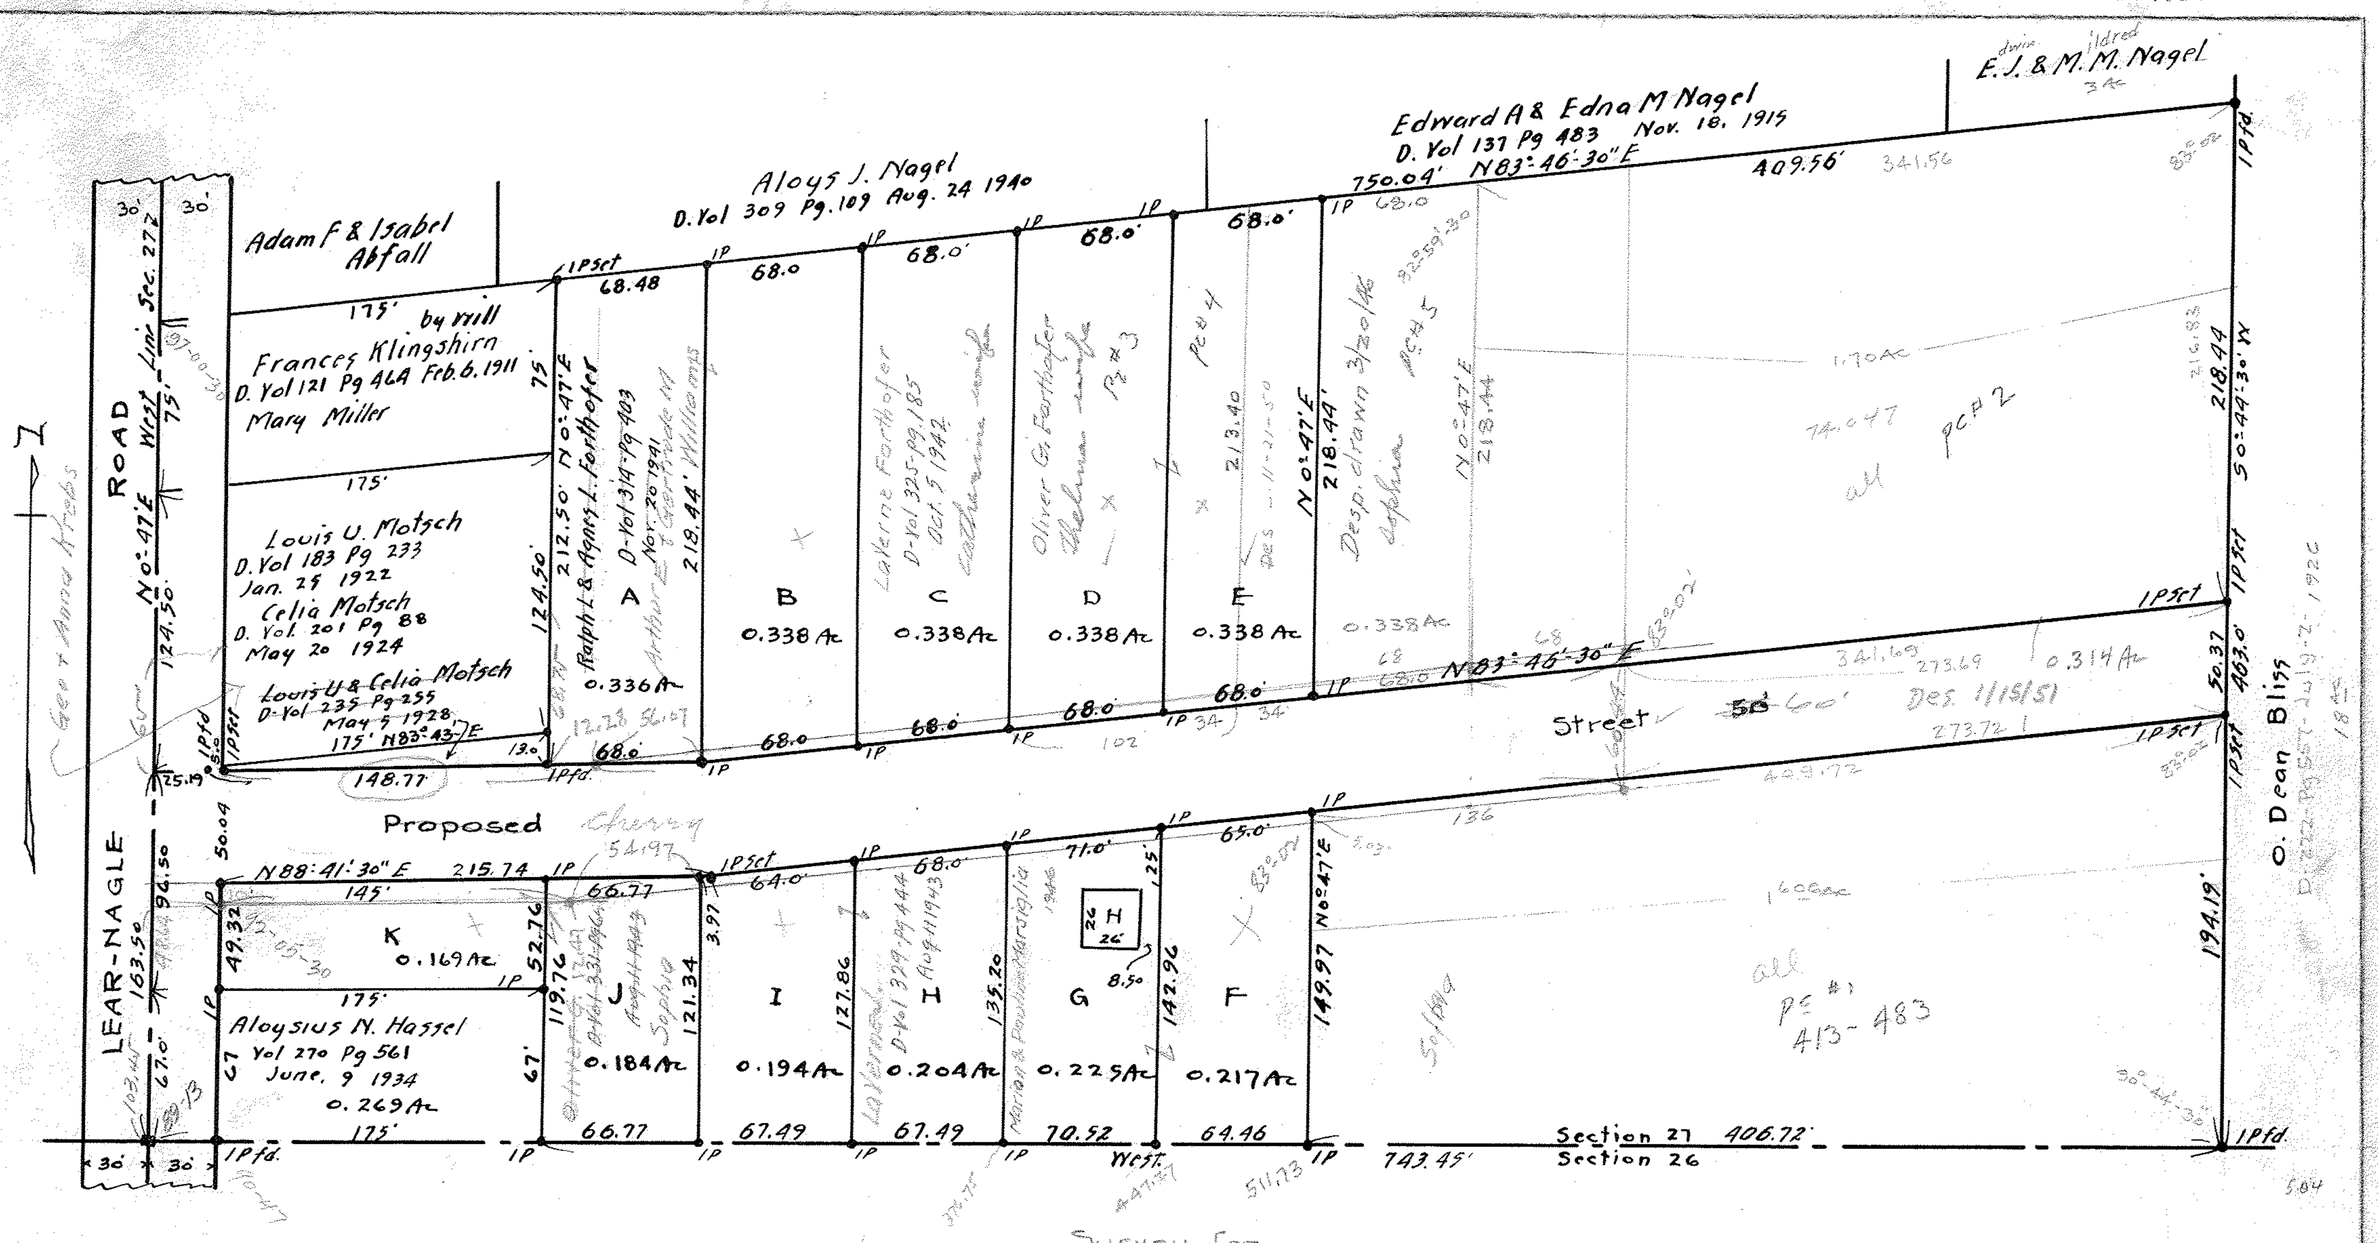

20843 A

Survey for
Jacob Forthofer
Section 27- Avon Village,
formerly Avon Twp.,
Lorain Co., Ohio.
May 7- 1942. Scale 1"= 60.
J.W. Warden Registered Surveyor.

PPN 04-00-027-103-???
-104-???

Map Pg 4-00-027-E