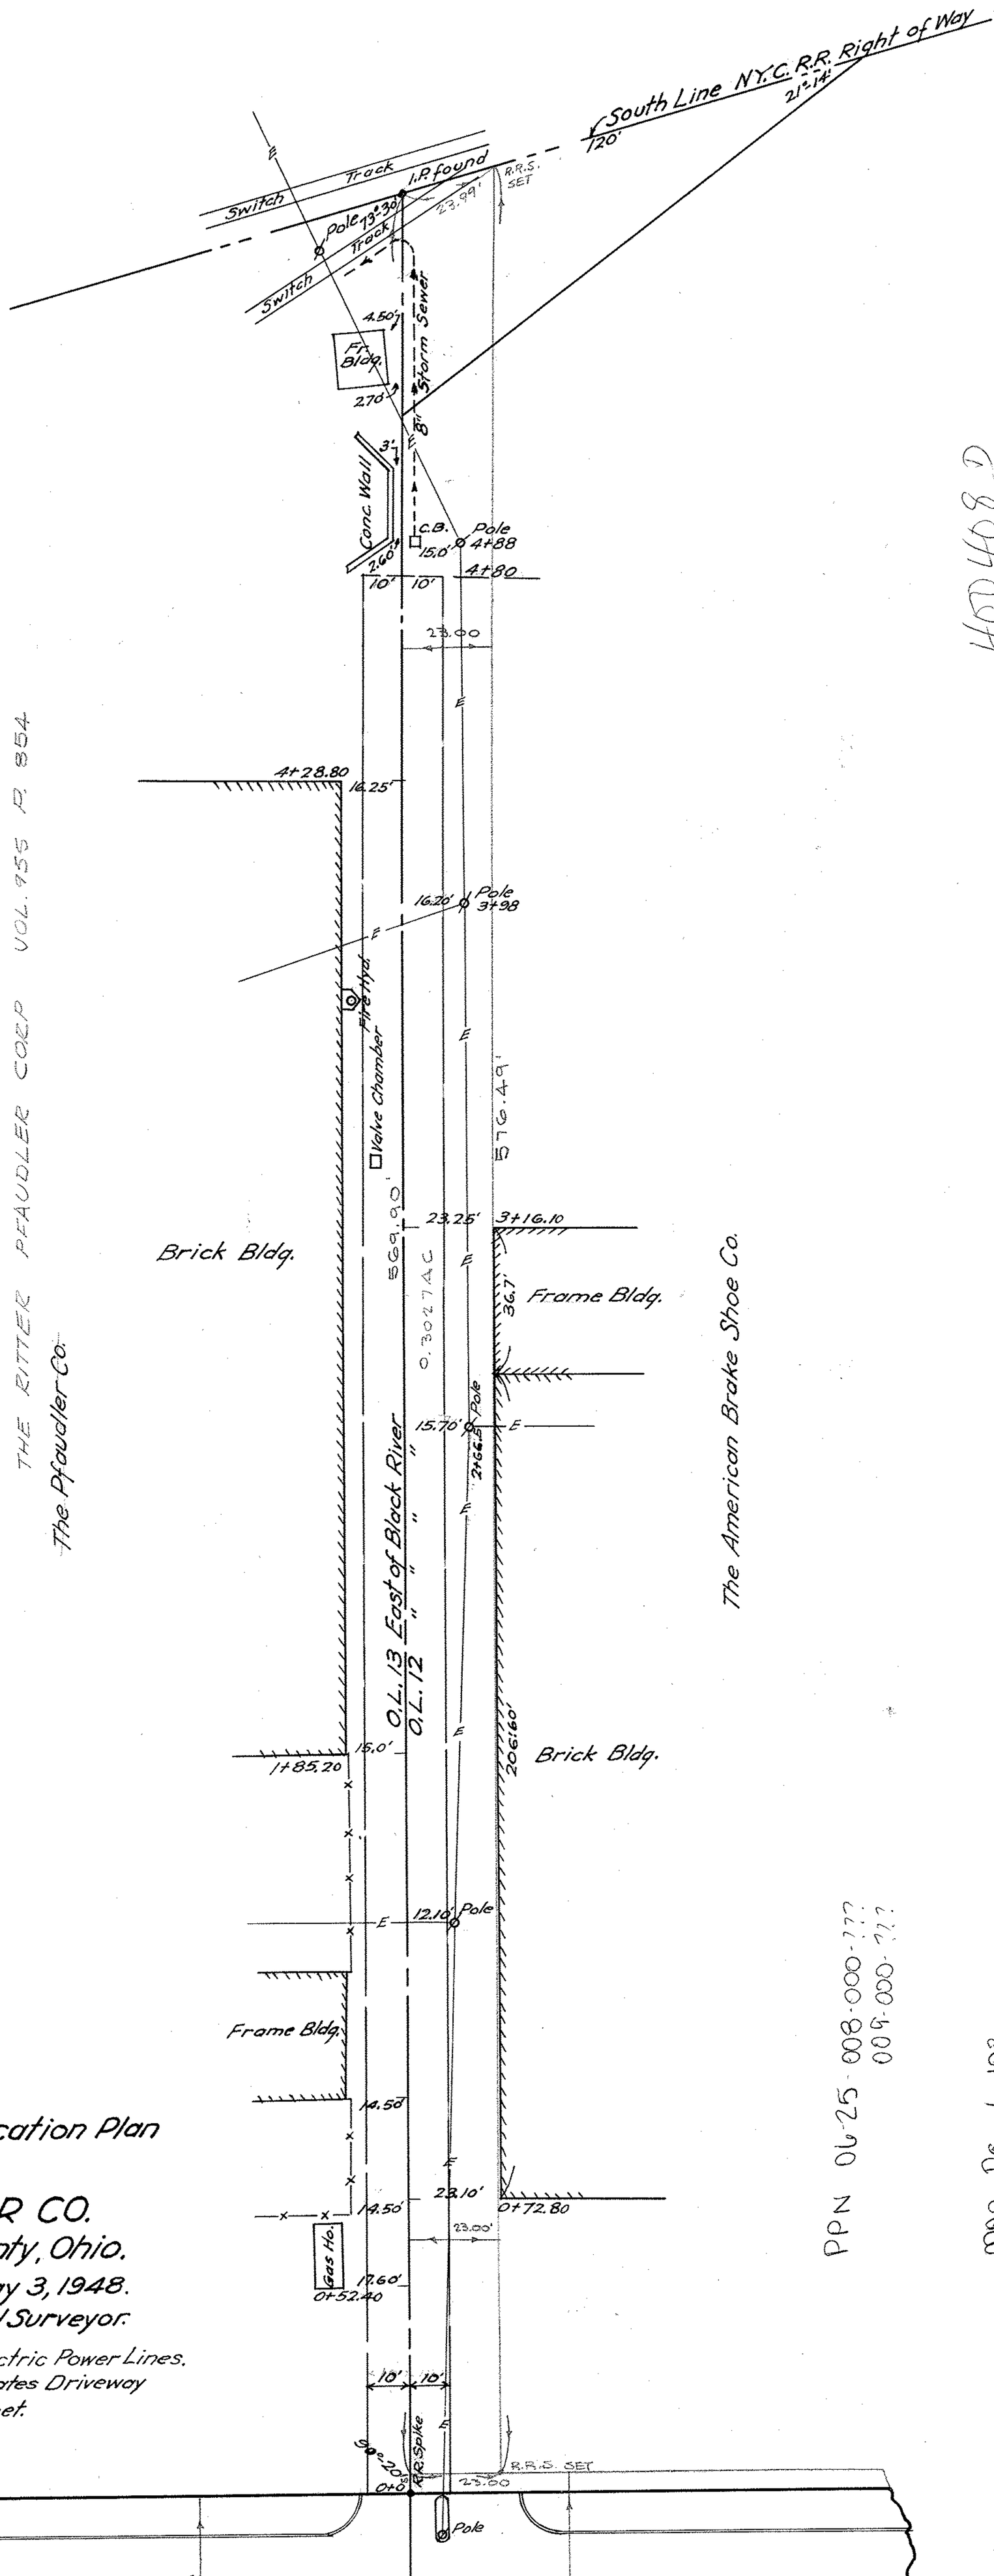

THE RITTER PFAUDLER CORP

The Pfaudler Co.

VOL. 755 P. 854

Brick Bldg.

N

The American Brake Shoe Co.

PPN 06-25-008-000-222
006-000-222

Map pg 6-108

460468 D

Survey & Building Location Plan For THE PFAUDLER CO.

Elyria, Lorain County, Ohio.

Scale - 1" = 30' May 3, 1948.

J. W. Warden, Registered Surveyor.

—— E —— Indicates Electric Power Lines.

Outline shown in Red indicates Driveway Agreement 20 feet by 480 feet.

REVISED MAY 3, 1971
REV. JULY 9, 1973