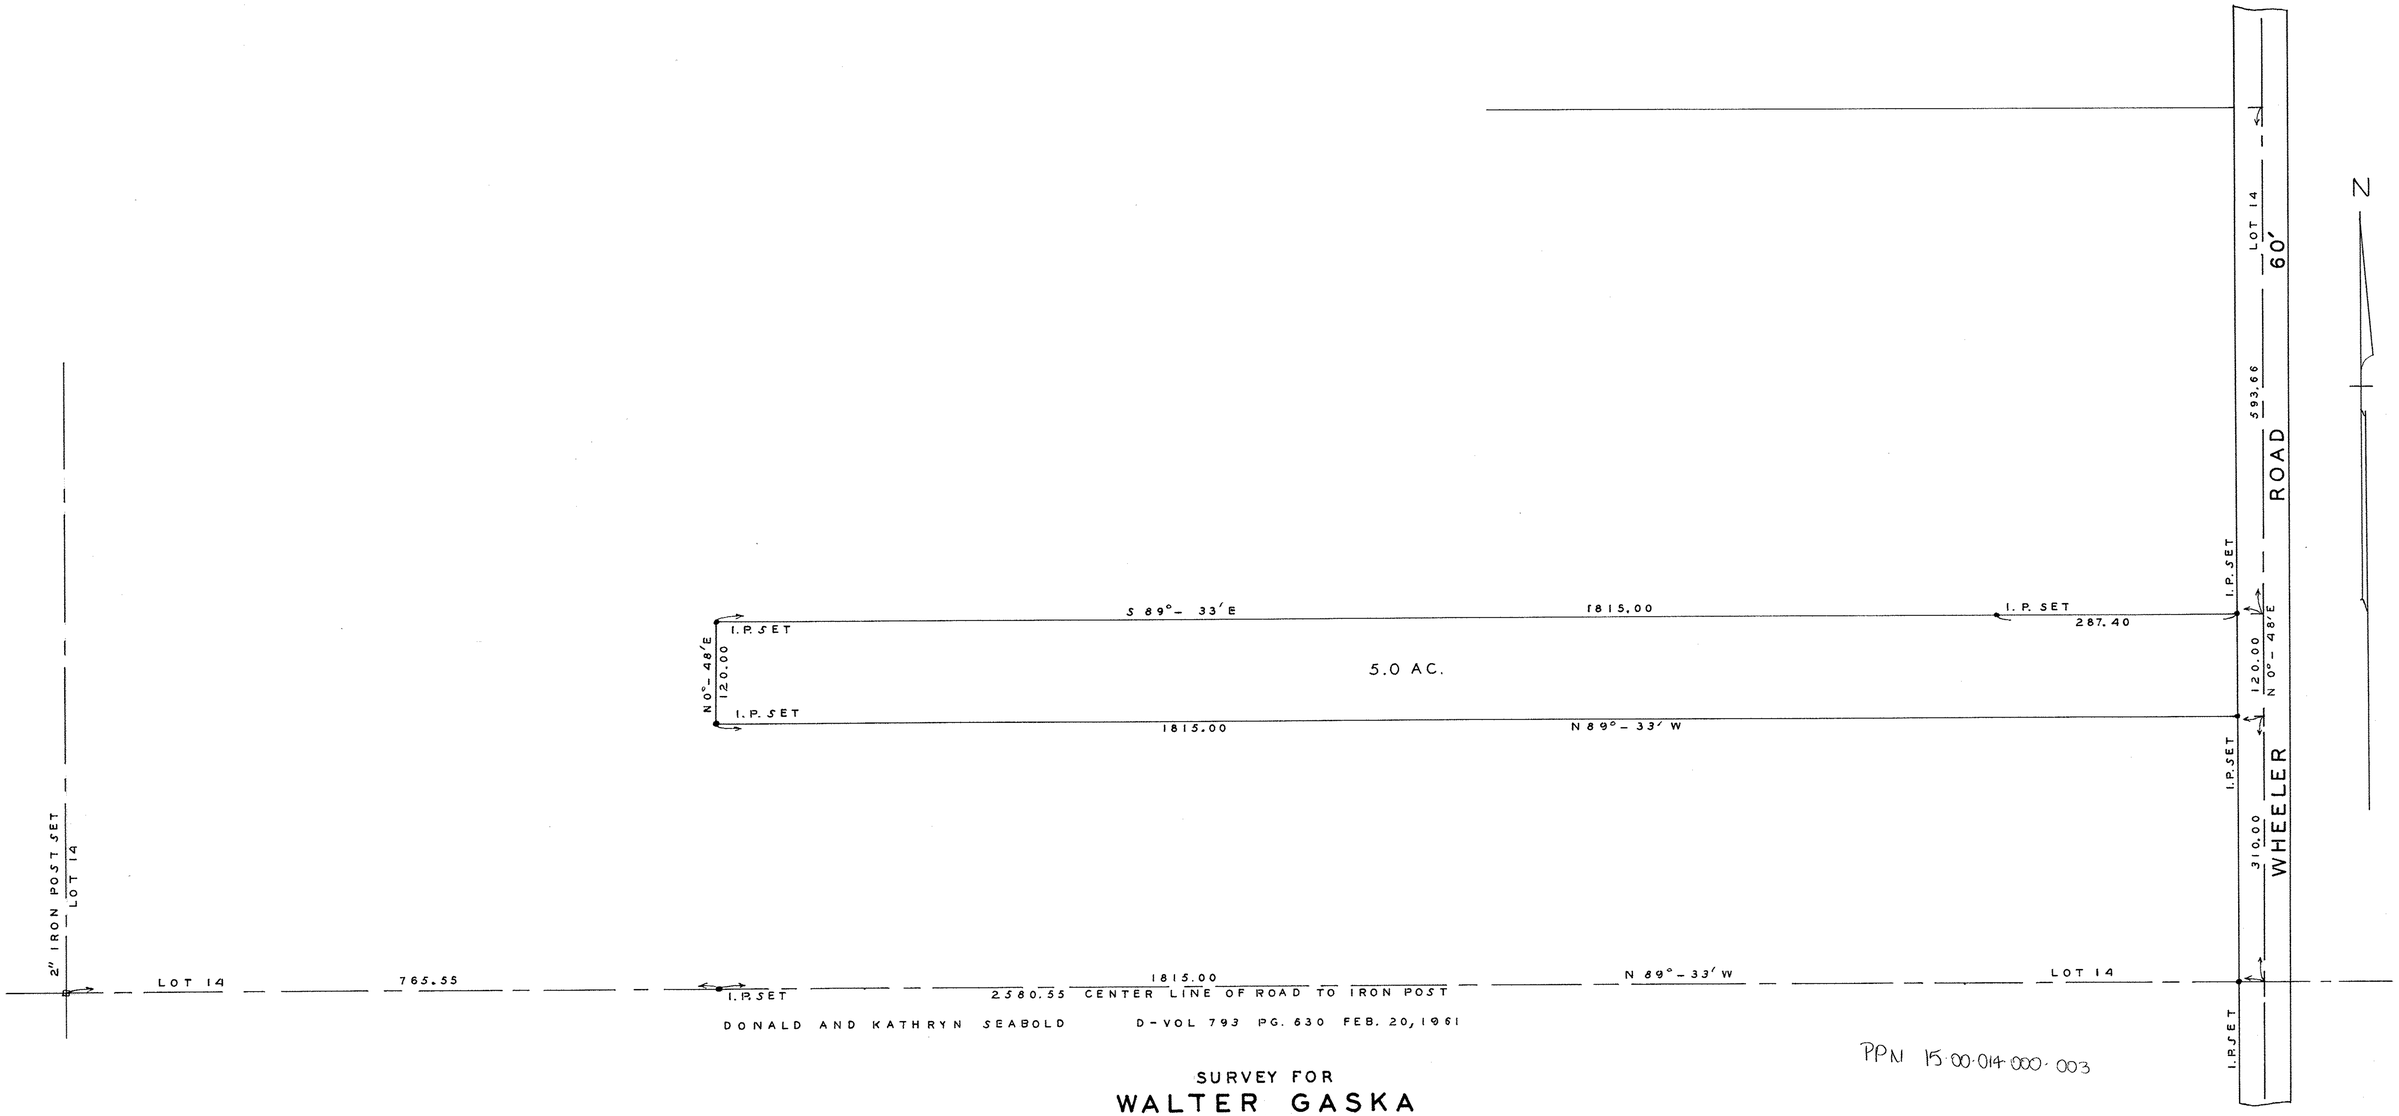

PPN 15-00-014-000-003

SURVEY FOR

WALTER GASKA

D-VOL 592 PG. 390 DEC. 11, 1953
O. L. 14 LAGRANGE TOWNSHIP
LORAIN COUNTY, OHIO
SCALE 1" = 100' JUNE 13, 1963
J. W. WARDEN AND ASSOCIATES
REG. SURVEYORS

MAP PG 15-C

STATE OF OHIO
O.B. ANDRUS
928
REGISTERED
SURVEYOR

401406