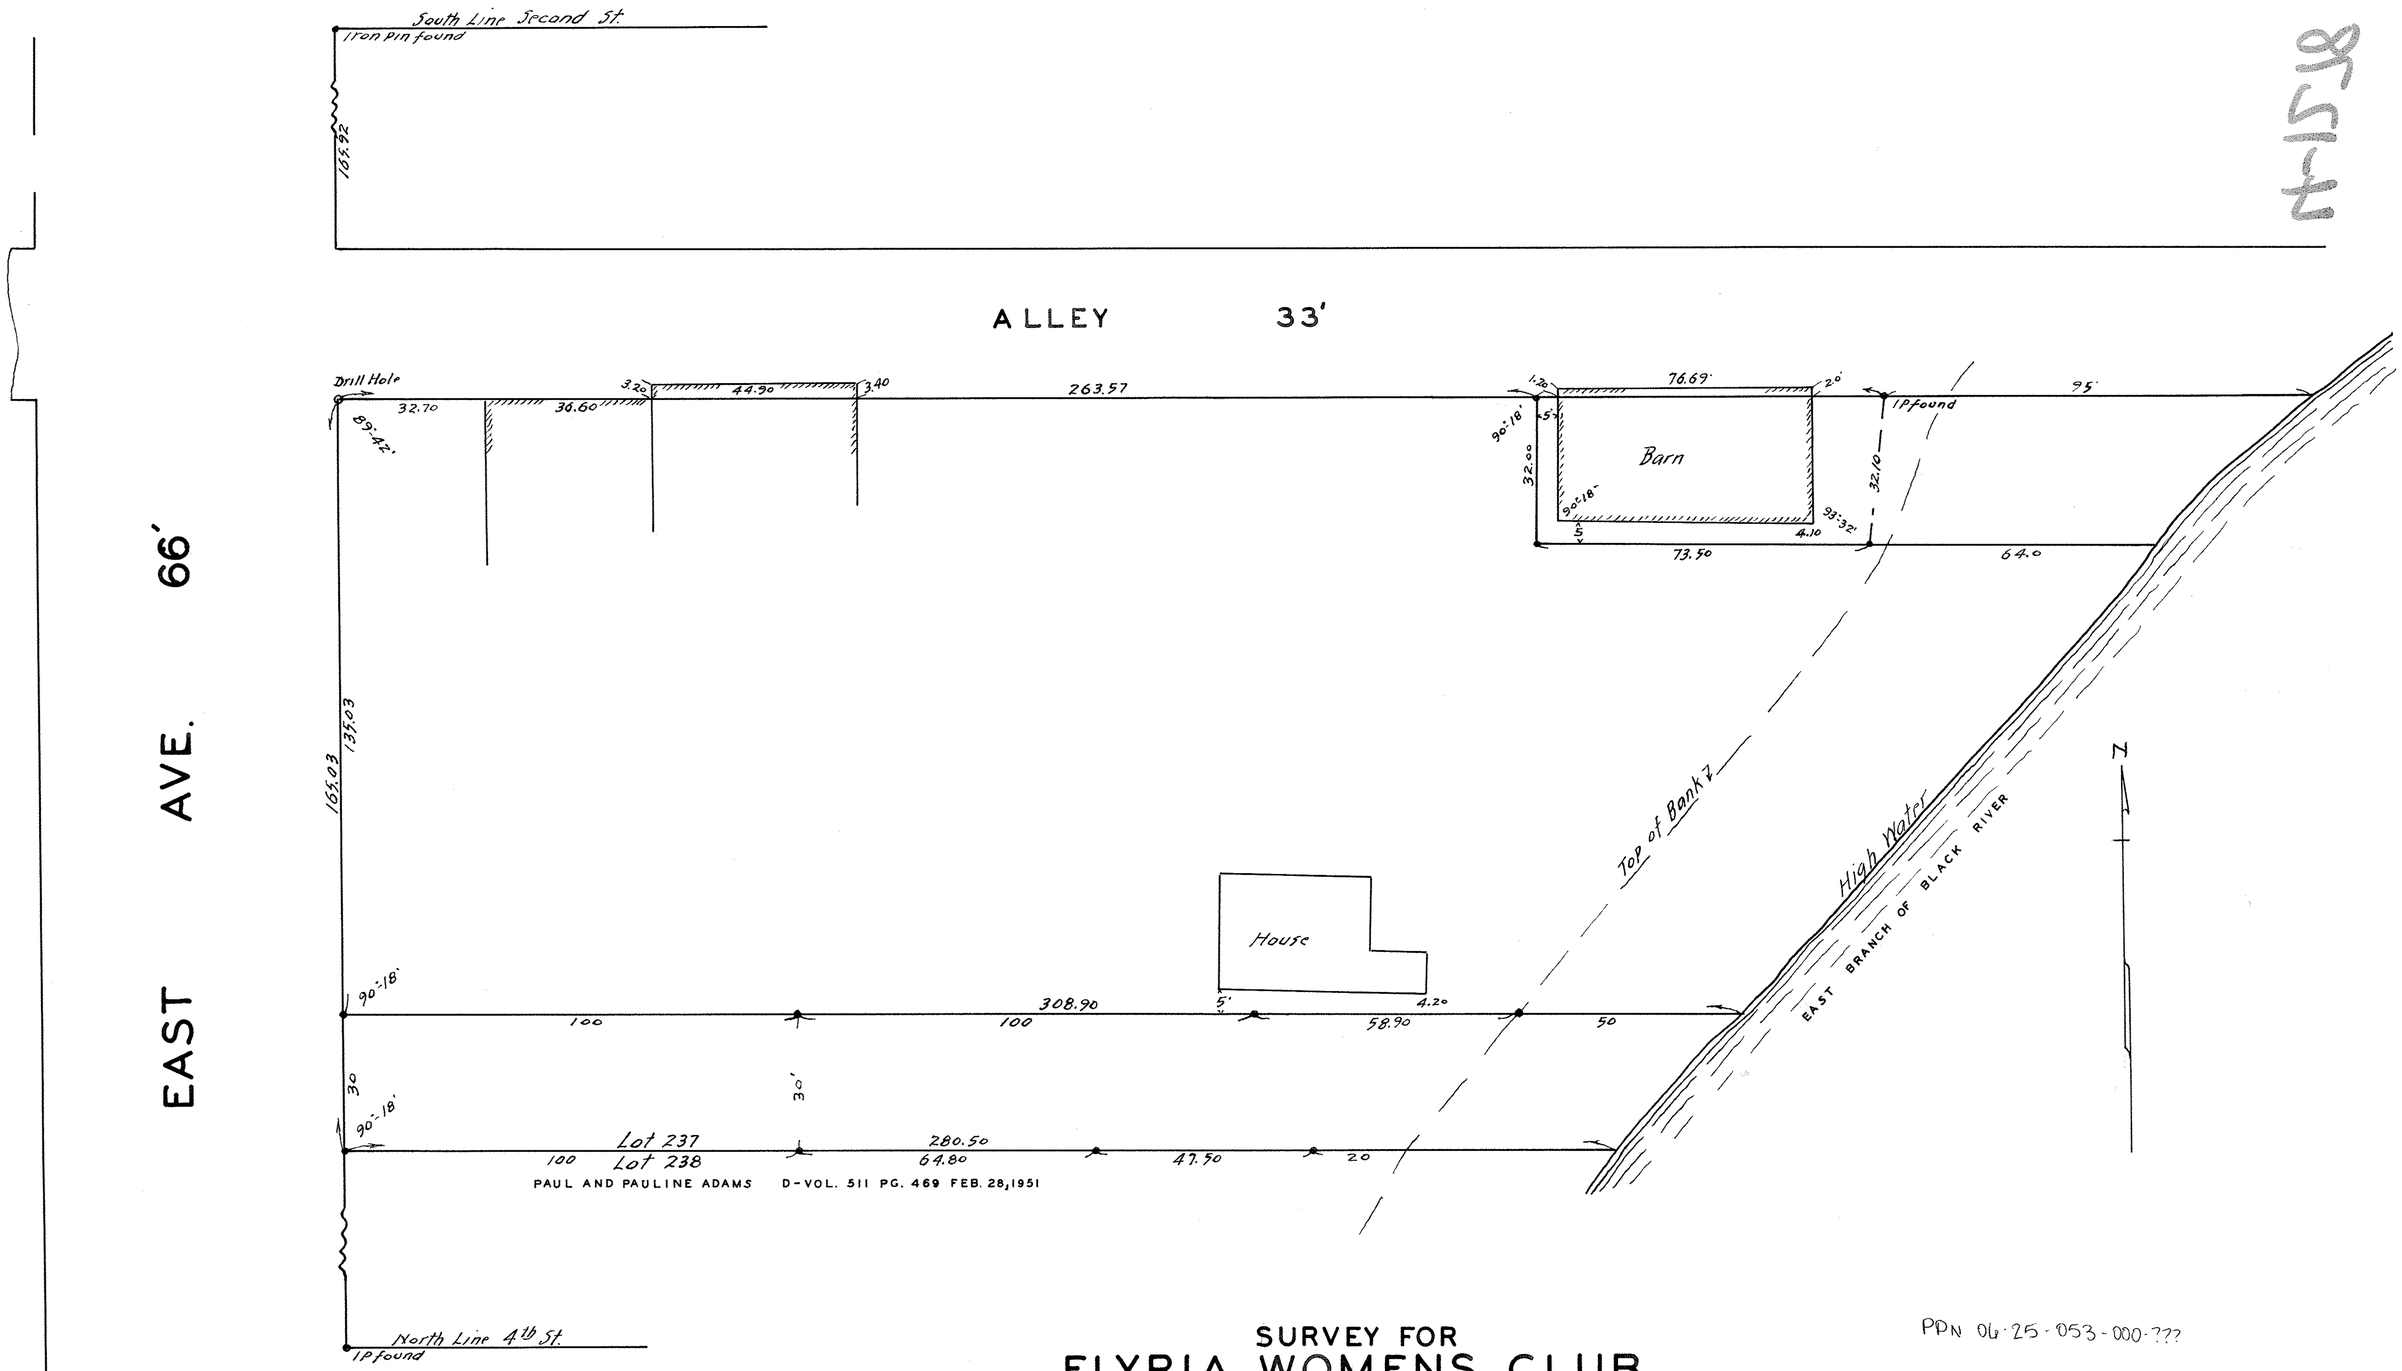

SURVEY FOR

ELYRIA WOMENS CLUB

D-VOL. 617 PG. 466-468 DEC. 31, 1954
BLOCK 53 LOT 237 H. ELY ORIGINAL TOWN PLAT
MAP VOL. 3 PAGE 14
ELYRIA CITY, LORAIN COUNTY, OHIO
SCALE 1" = 20' MARCH 12, 1957
J. W. WARDEN AND ASSOCIATES REG. SURVEYORS

D.D. Andrus
BY D.D. ANDRUS

PPN 06-25-053-000-???

MAP PG 6-120

401278