


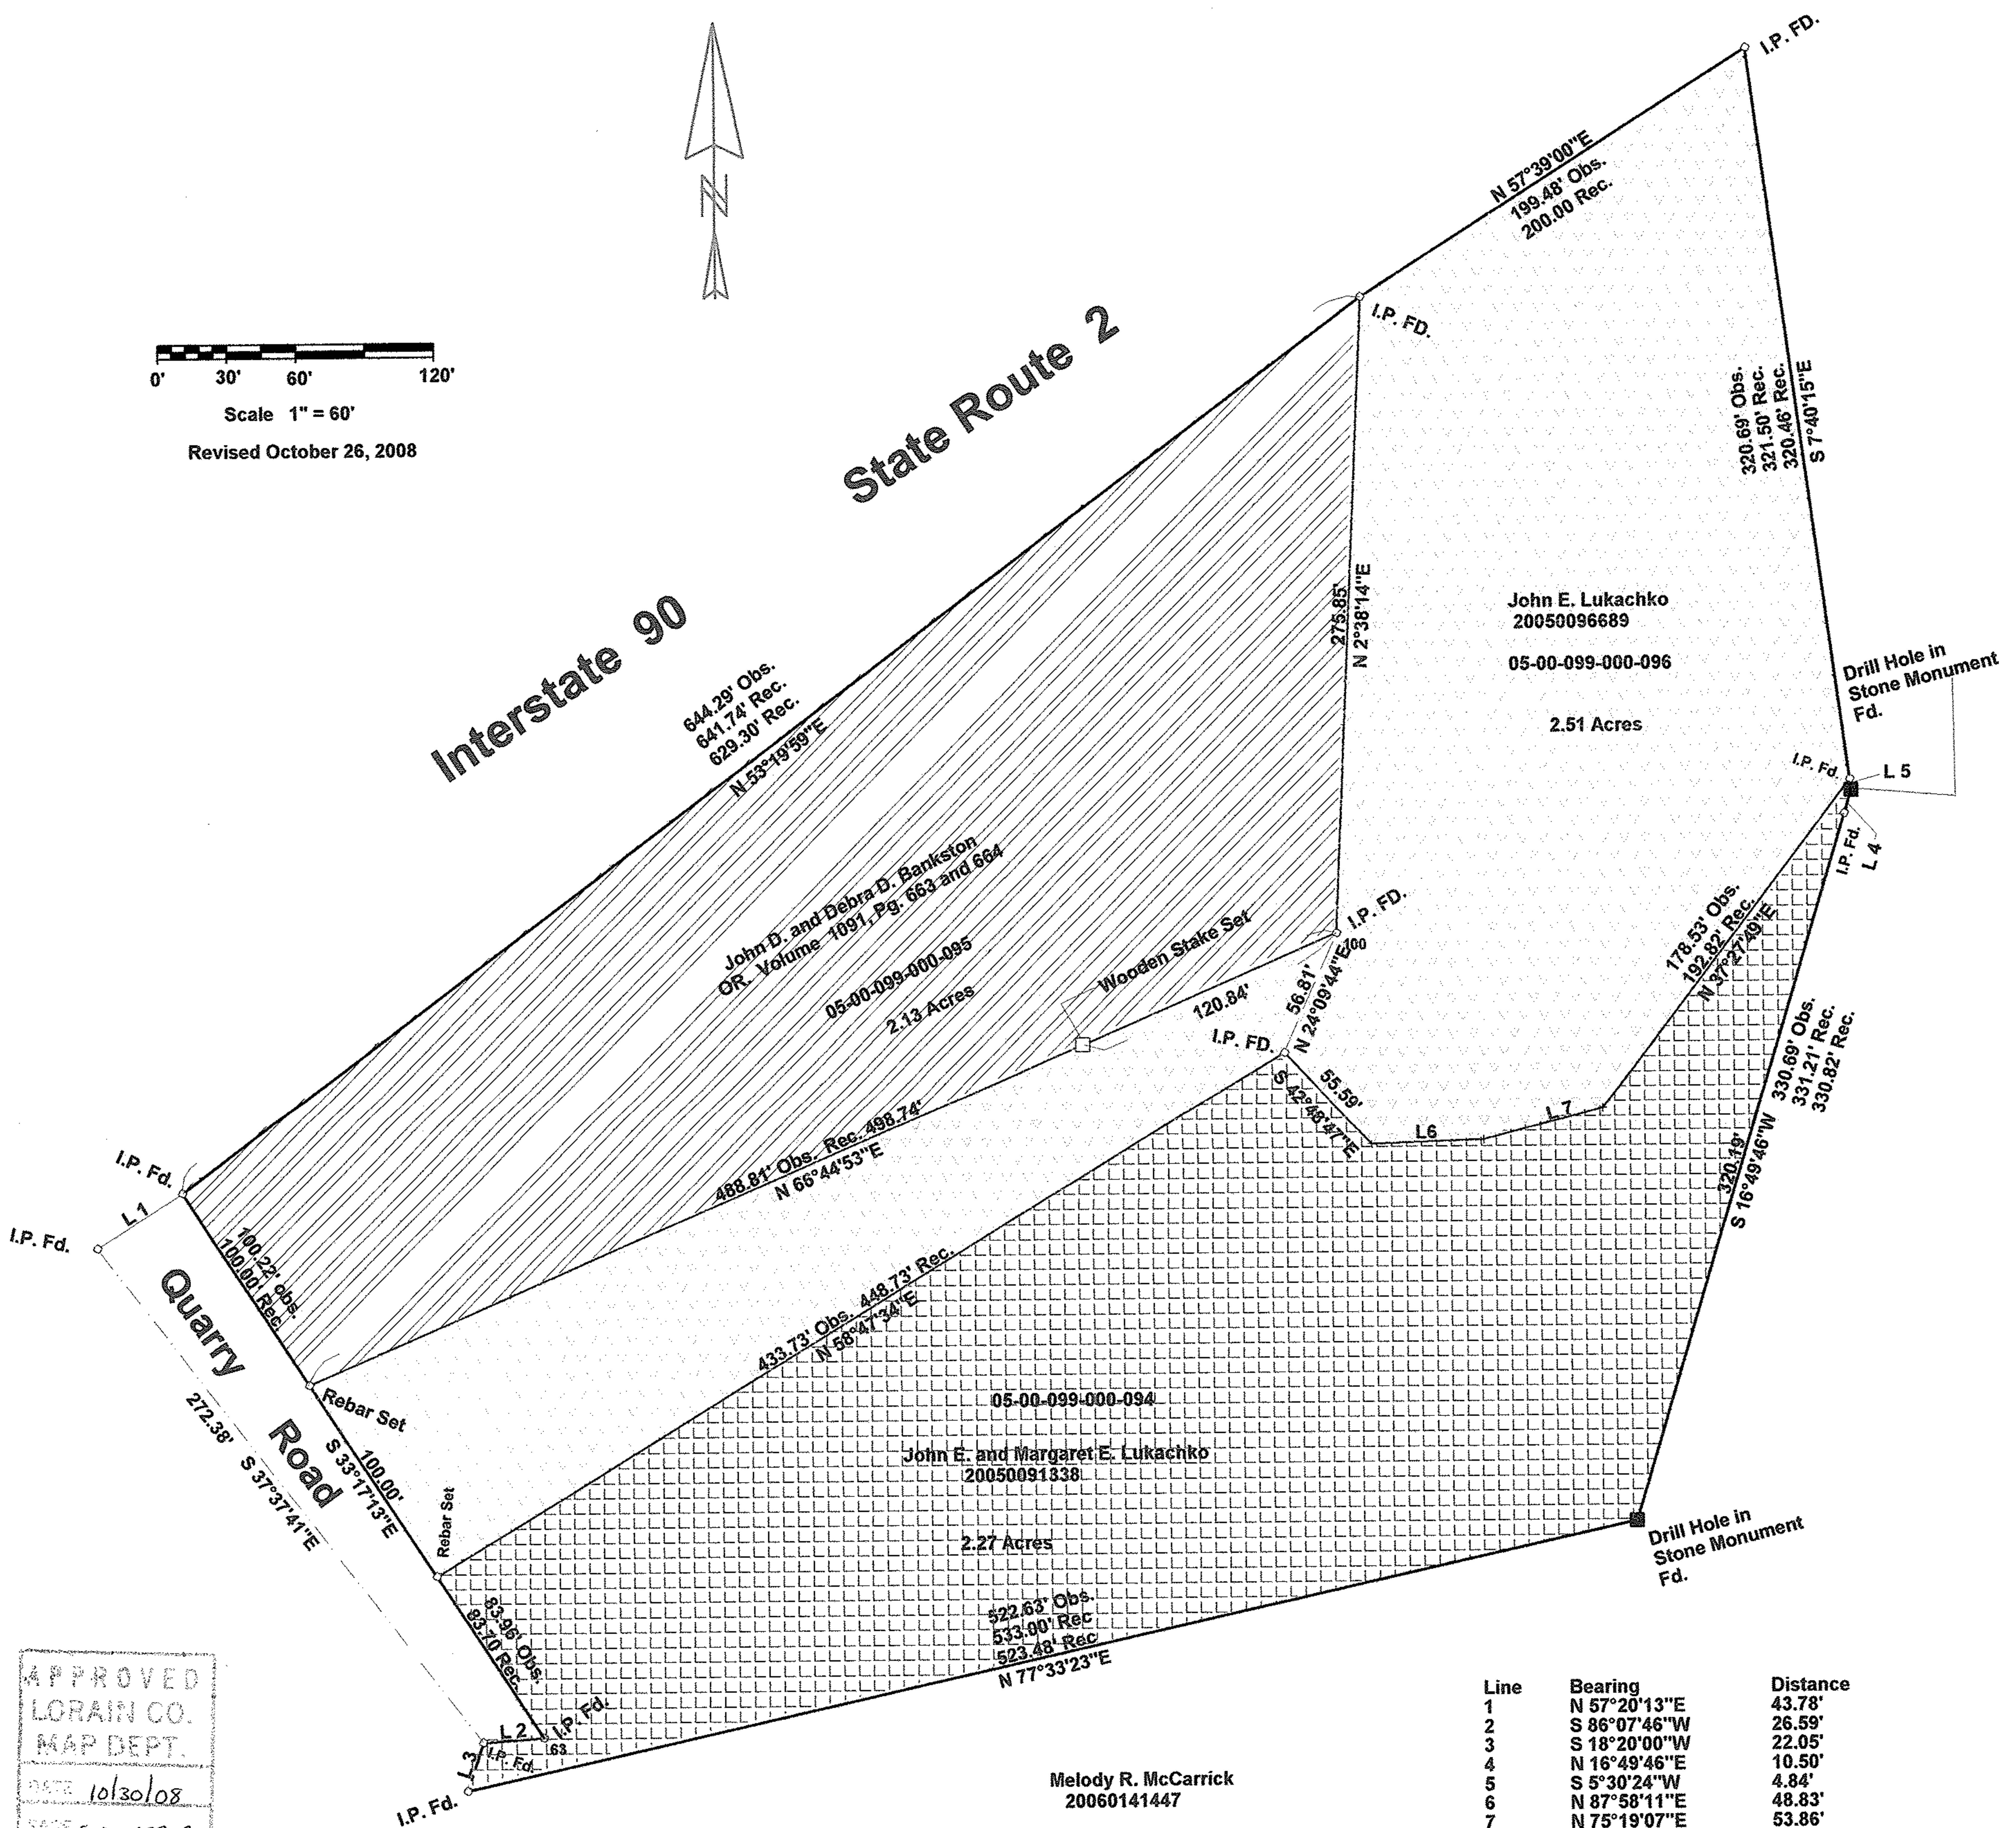

Scale 1" = 60'  
Revised October 26, 2008



Interstate 90  
State Route 2



APPROVED  
LORAIN CO.  
MAP DEPT.  
DATE 10/30/08  
CASE S-00-099-C  
BY T. SPILLMAN  
#08-01703-C

Note: Only copies signed with Red Ink shall be considered Valid.

*Patrick A. McGannon*  
Patrick A. McGannon P.S. 7154

Being known as part of Original Amherst Township Lot 99, now in the City of, Amherst, County of Lorain, in the State of Ohio.

Prepared for Vickie Farais of 1606 West 28th Street Lorain, Ohio, 44053.

Melody R. McCarrick  
20060141447

05-00-099-000-126

Line	Bearing	Distance
1	N 57°20'13"E	43.78'
2	S 86°07'46"W	26.59'
3	S 18°20'00"W	22.05'
4	N 16°49'46"E	10.50'
5	S 5°30'24"W	4.84'
6	N 87°58'11"E	48.83'
7	N 75°19'07"E	53.86'
8	S 18°14'12"W	10.42'
9	S 35°45'22"W	6.40'

Note: I certify that there are no Building encroachments on properties as shown hereon as of October 26, 2008.

Revised survey and descriptions based on original survey monumentation found and accepted.

Note: Bearings shown are to an assumed meridian and are used to describe angles only.

**Boundary Survey**  
**Patrick A. McGannon**  
Registered Professional Surveyor

1731 Gettysburg Drive, Lorain, Ohio 44053

(440)-2822712



Orchard Glen Number 1