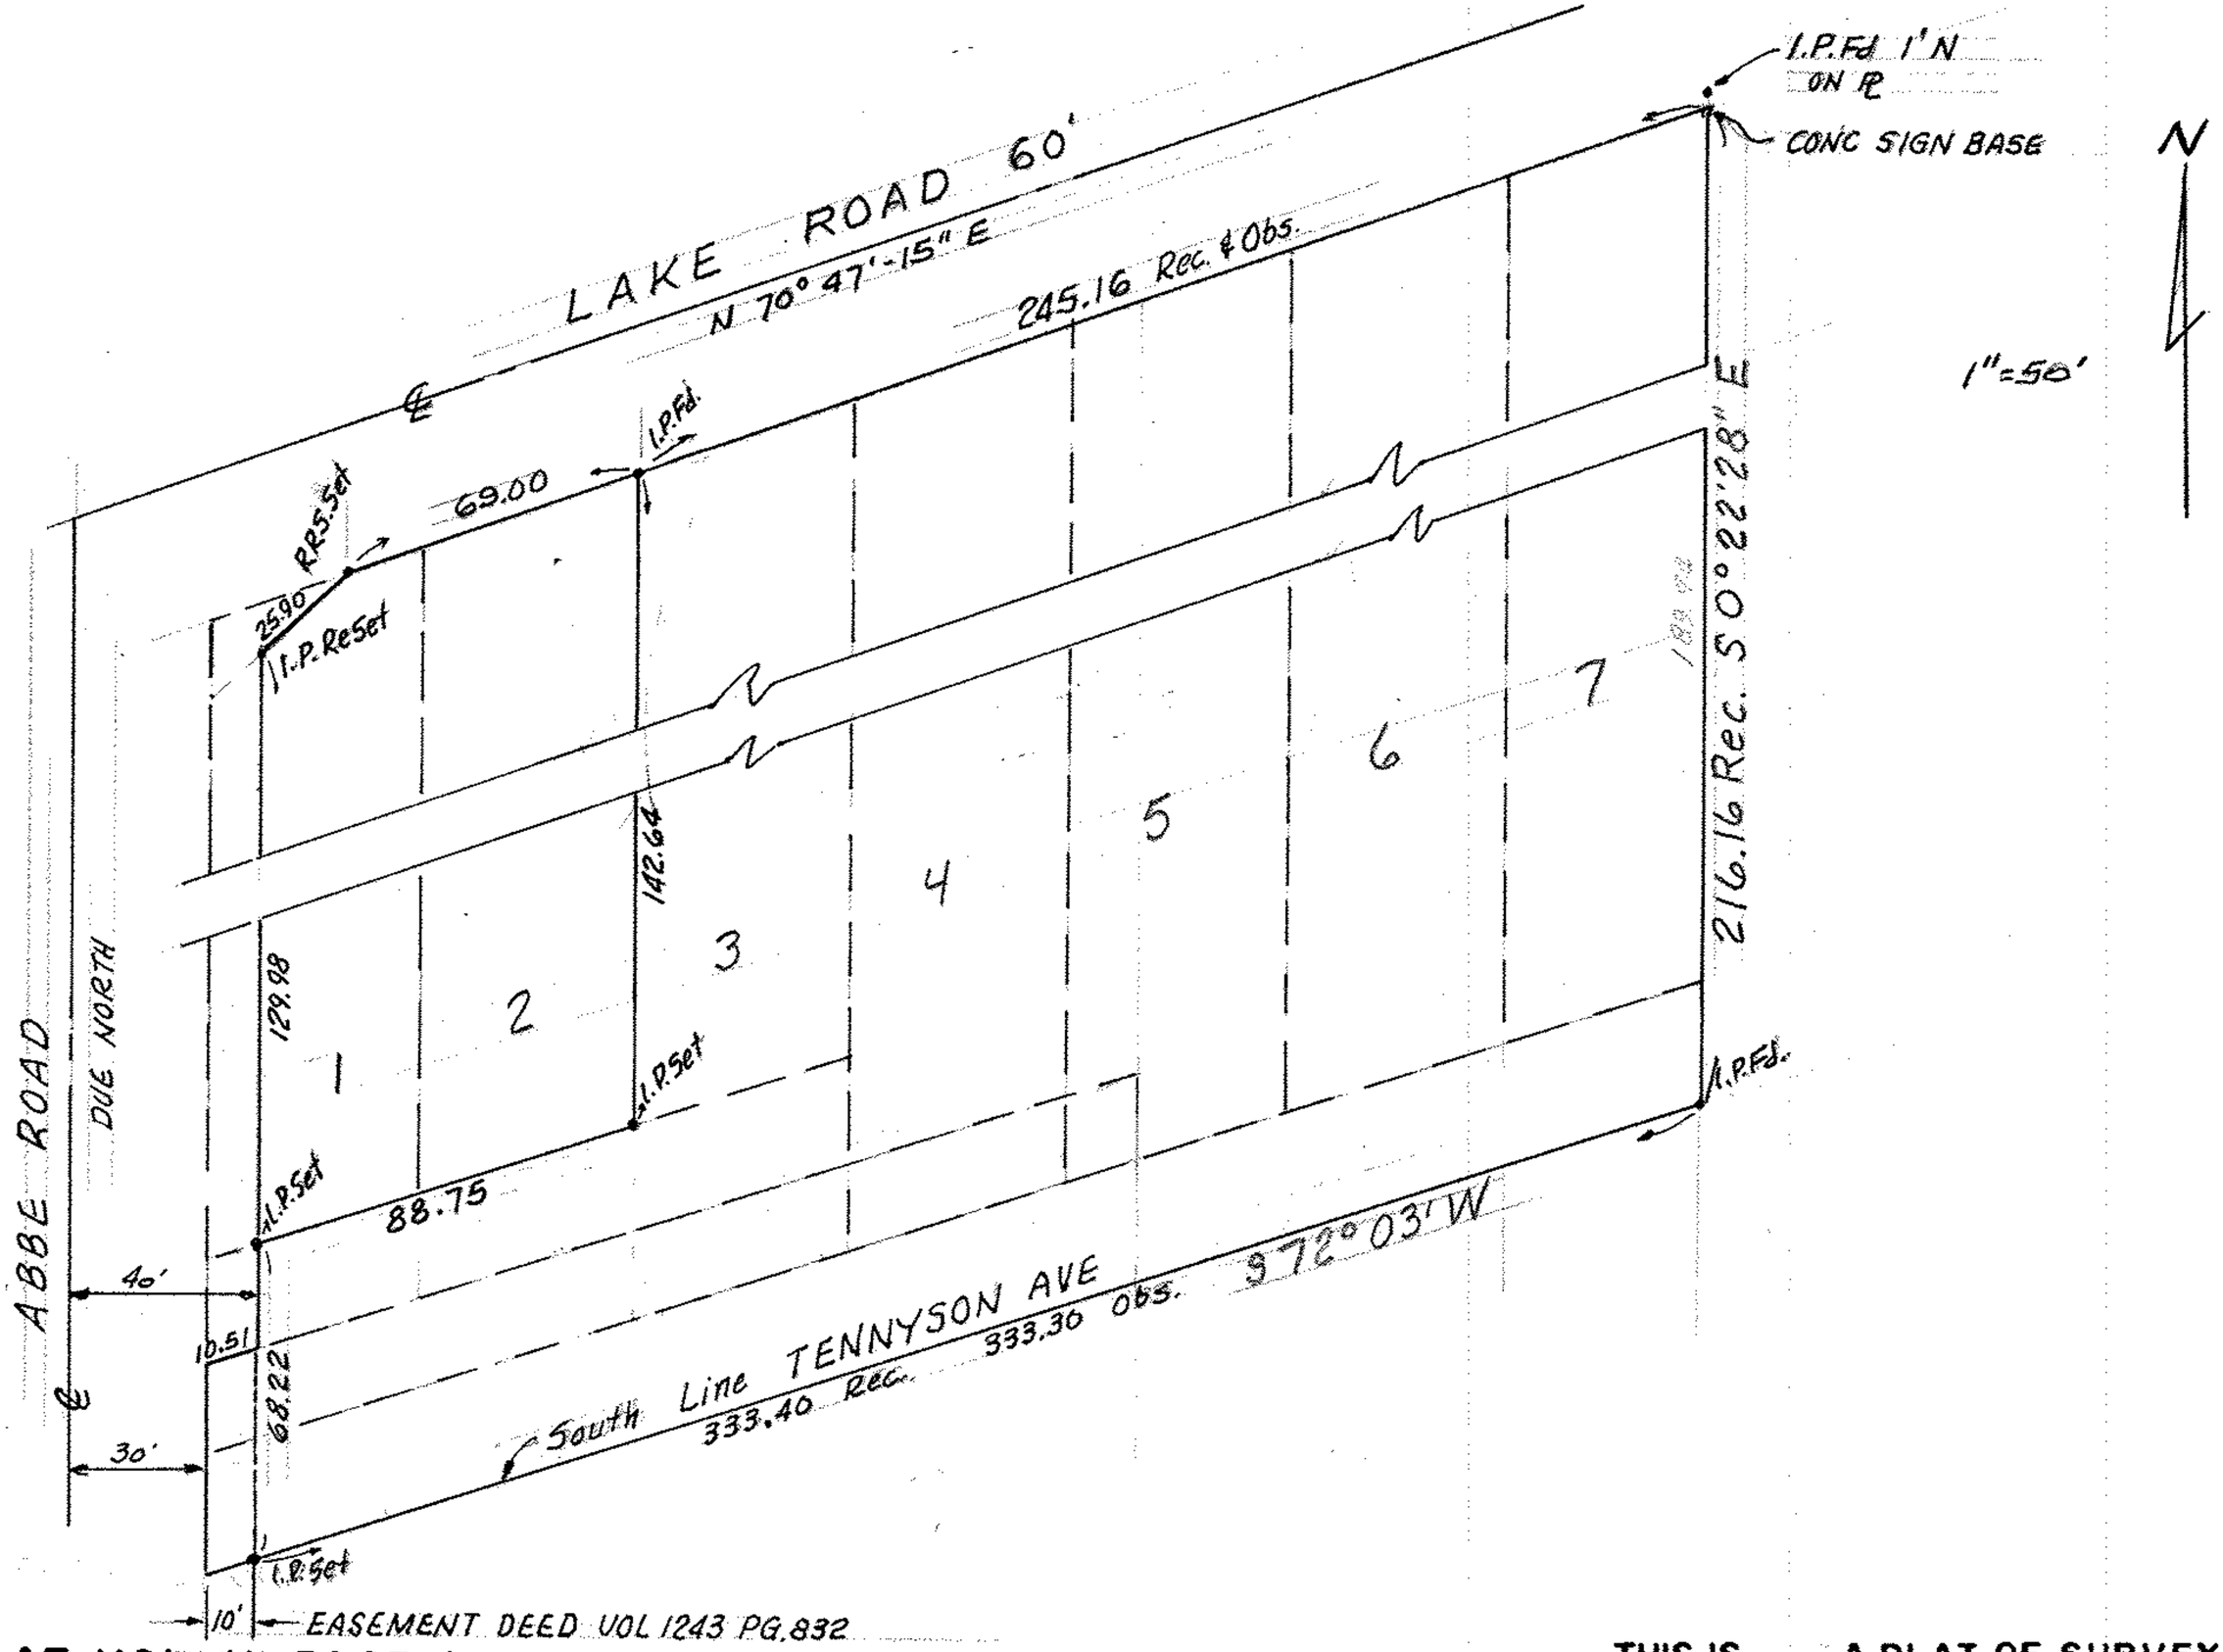

PLAT VOL. 11 PAGE 6 SUNSET COUNTRY CLUB ALL'T
PART of ORIG. SHEFFIELD **TWP. LOT** 33
NOW in CITY of SHEFFIELD LAKE **, OHIO**

THIS IS A PLAT OF SURVEY:

McGLINCHY & ASSOCIATES INC.

APRIL **1982** **#8** 27/76