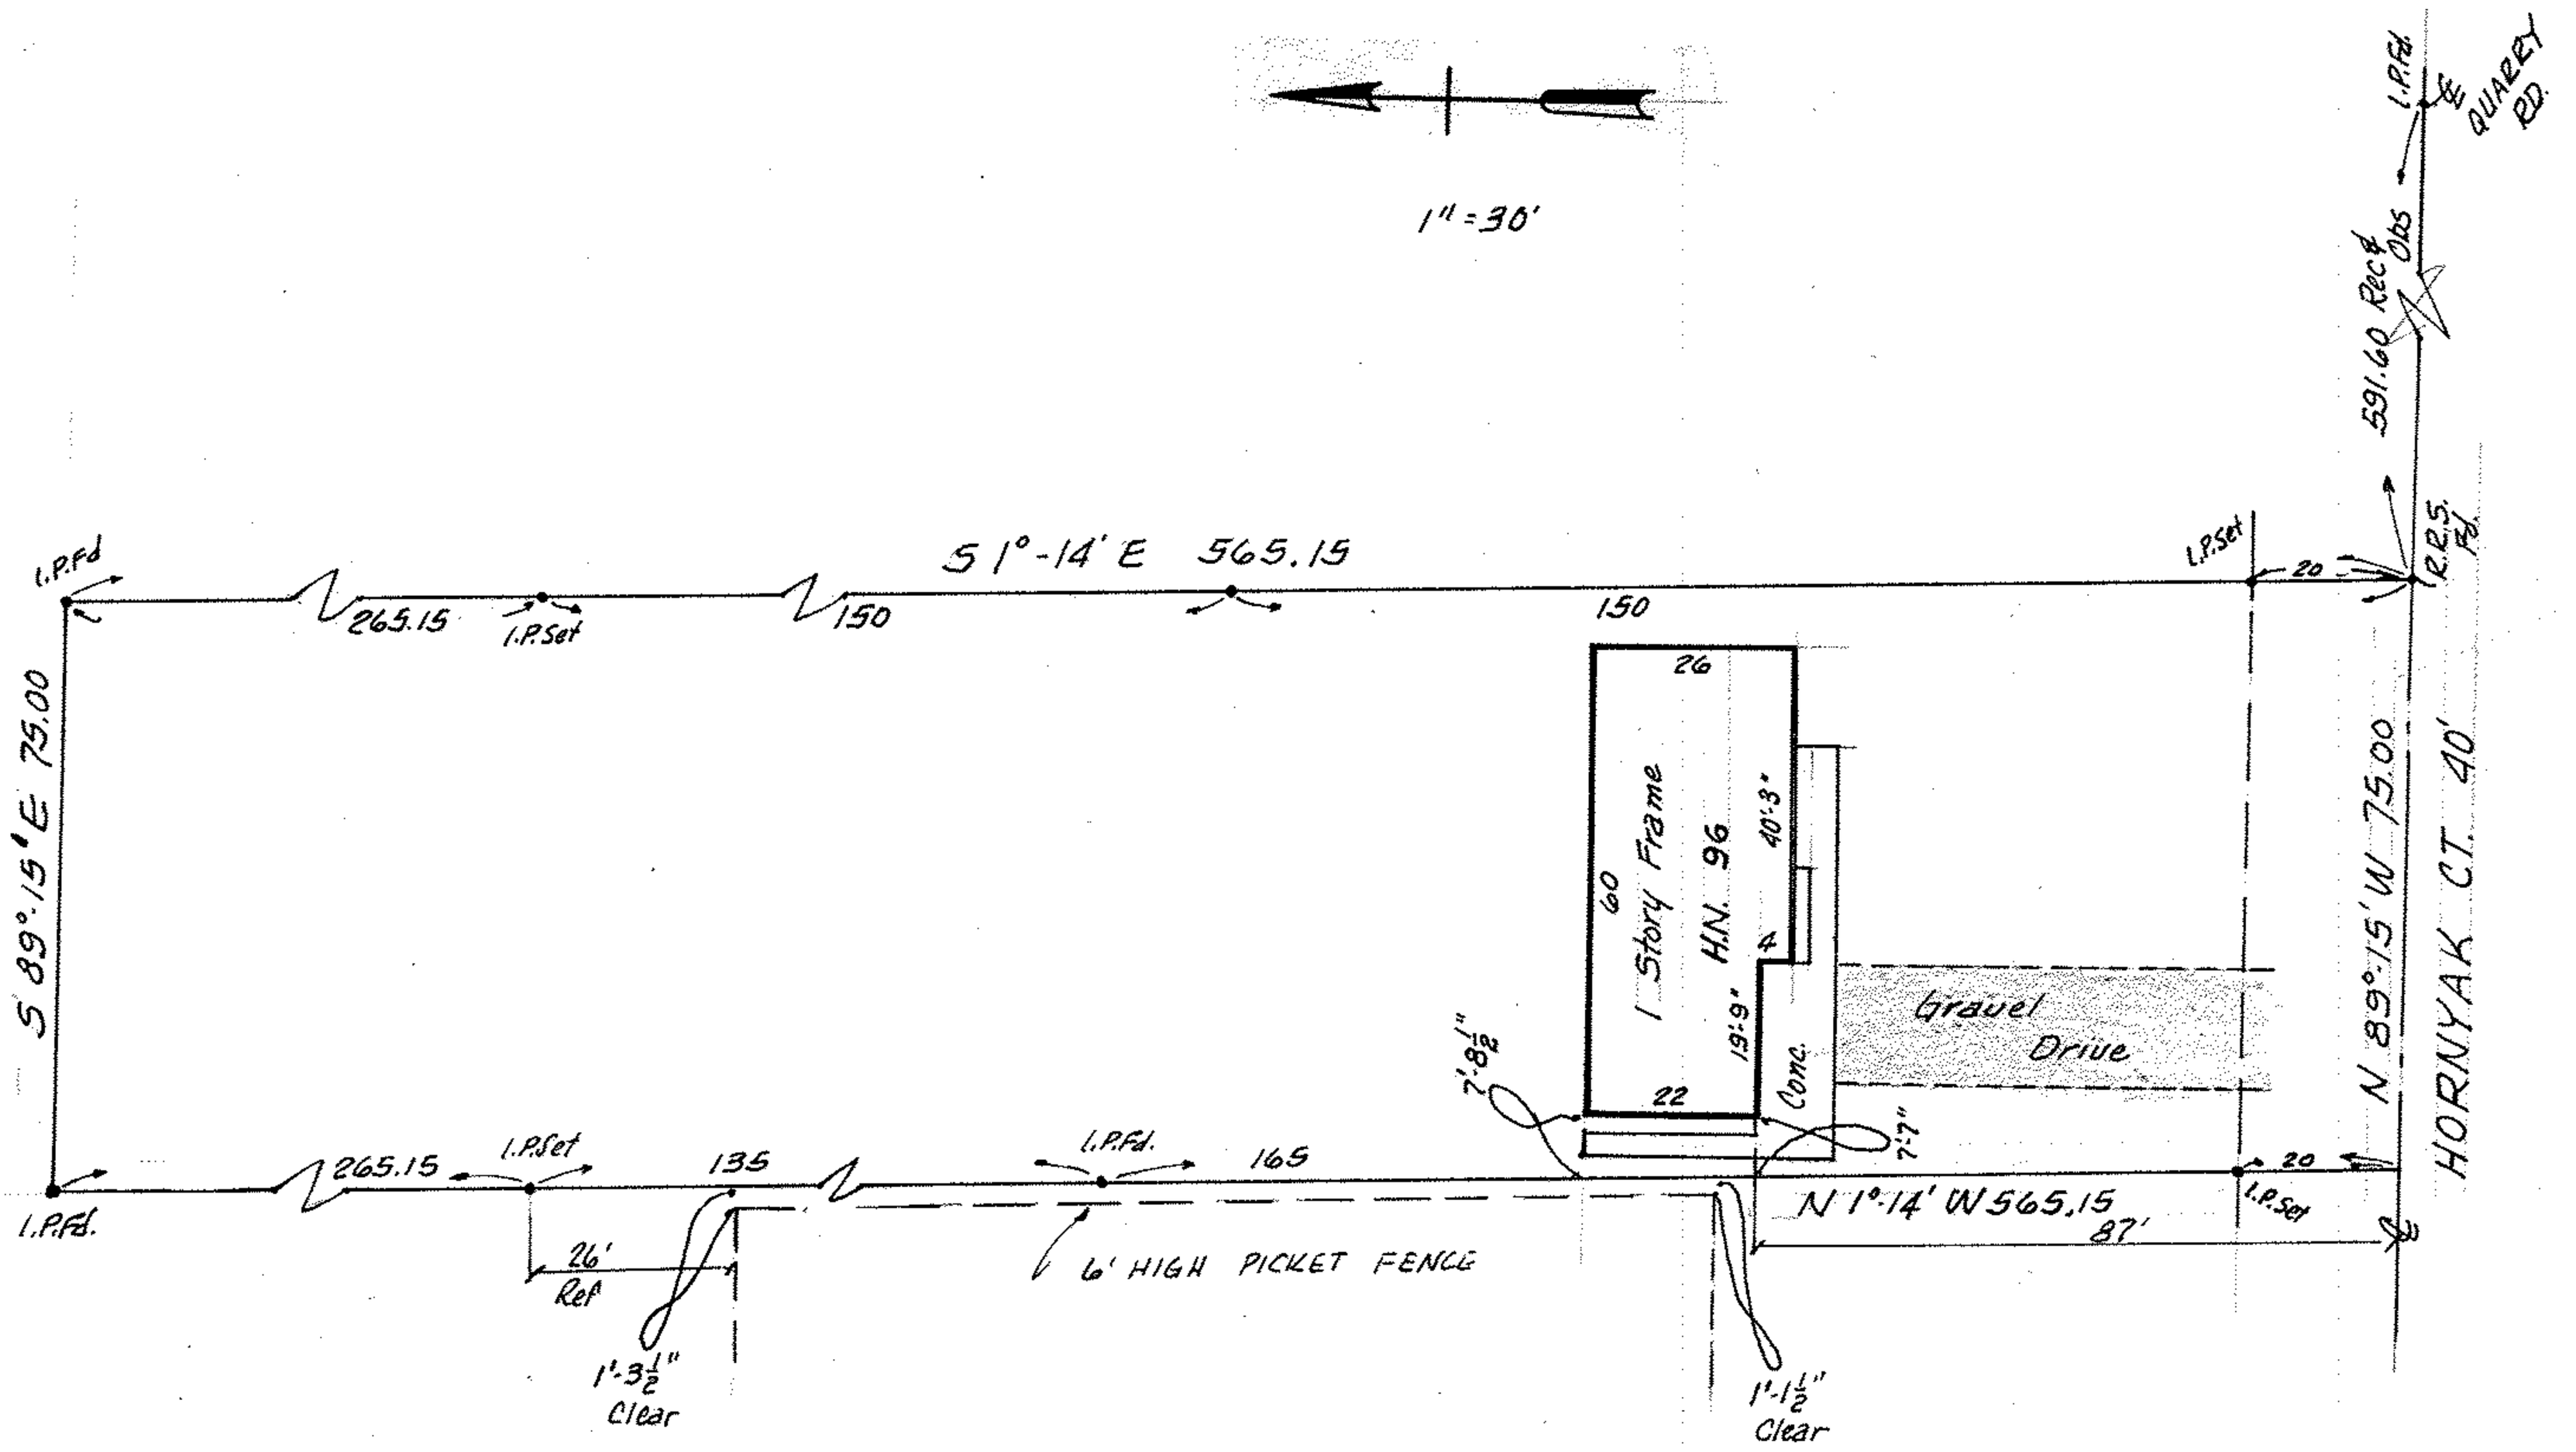

P.P.# 05-00-094-103-049 0.97 Ac.

PART of ORIG. AMHERST **TWP. LOT** 94
NOW in CITY of LORAIN **,OHIO**
LORAIN COUNTY, OHIO

THIS IS A PLAT OF SURVEY:
PREPARED FOR ATTORNEY JIM ANADEL
BY **McGLINCHY & ASSOCIATES INC.**
MARCH 19, **1982** **#8** 27155