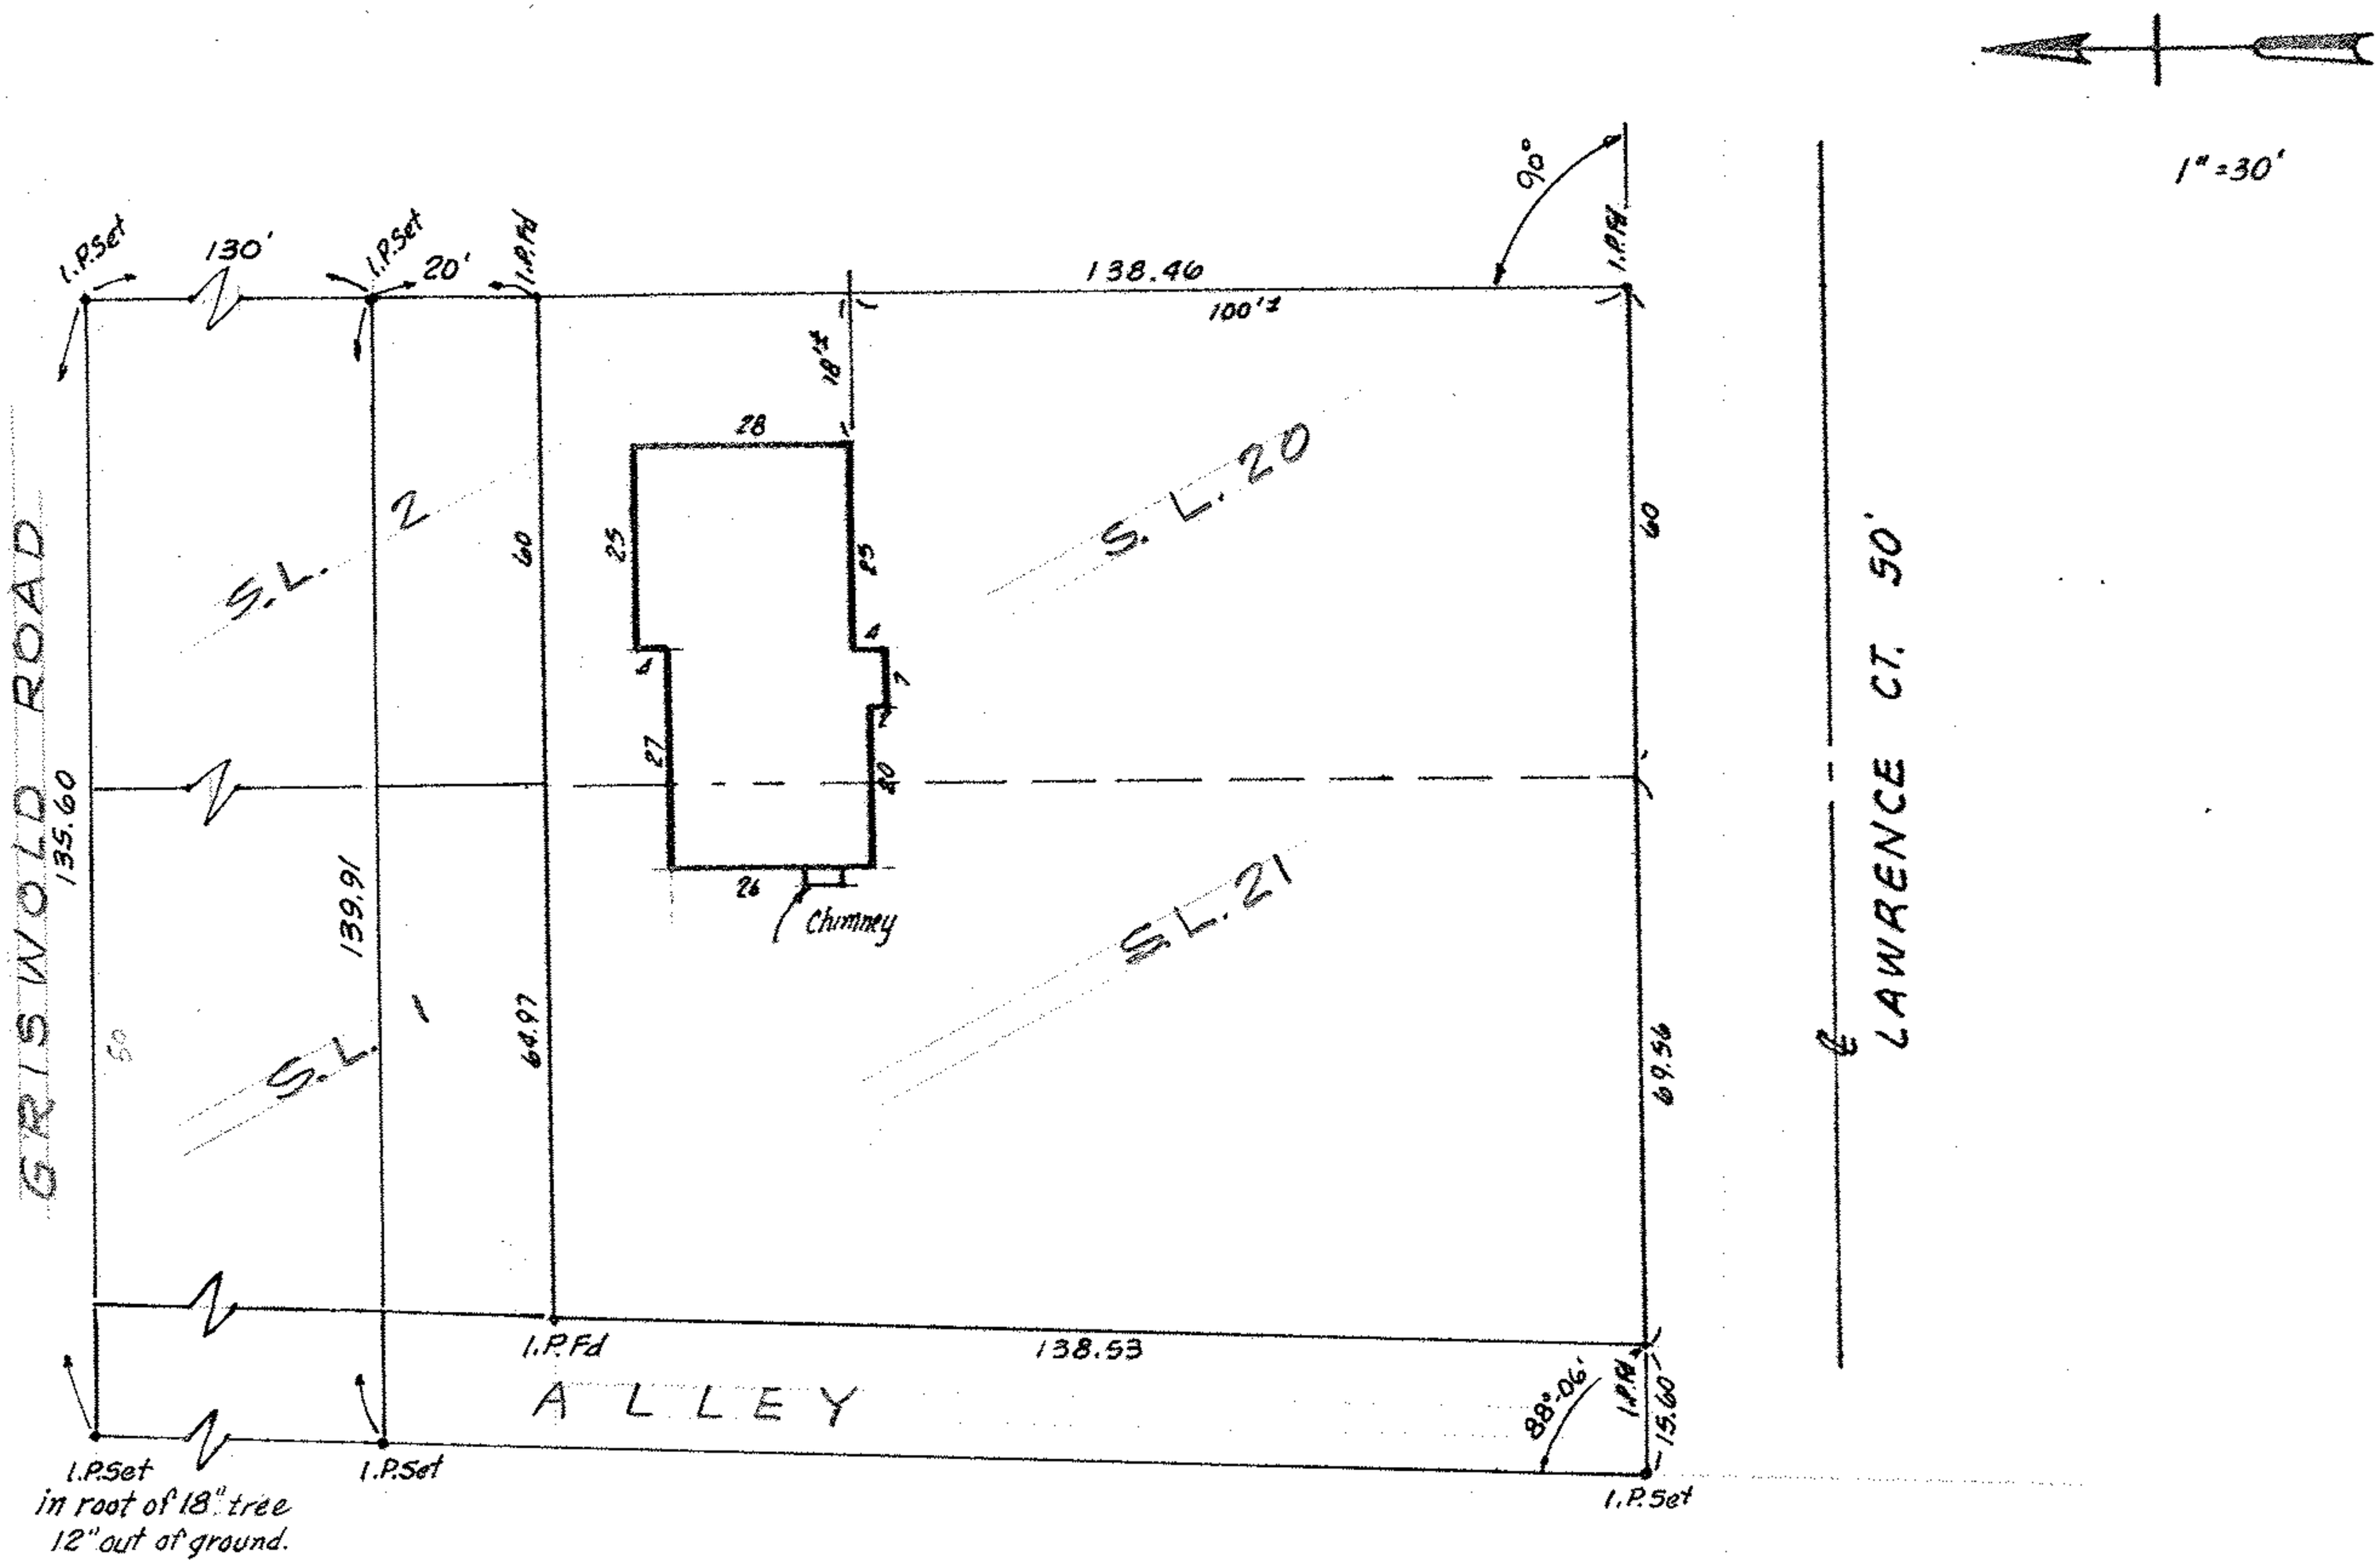

SUBLOTS #1, 2, 20 & 21 of ELYRIA HEIGHTS ALLOTMENT
PLUS PLATTED ALLEY

PLAT VOL. 6 PAGE 48
PART of ORIG. ELYRIA TWP. LOT 38 WEST of BLACK RIVER
LORAIN COUNTY ,OHIO

THIS IS A PLAT OF SURVEY:
FOR WALT GODLES
McGLINCHY & ASSOCIATES
APR. 2 1982 # 827166