


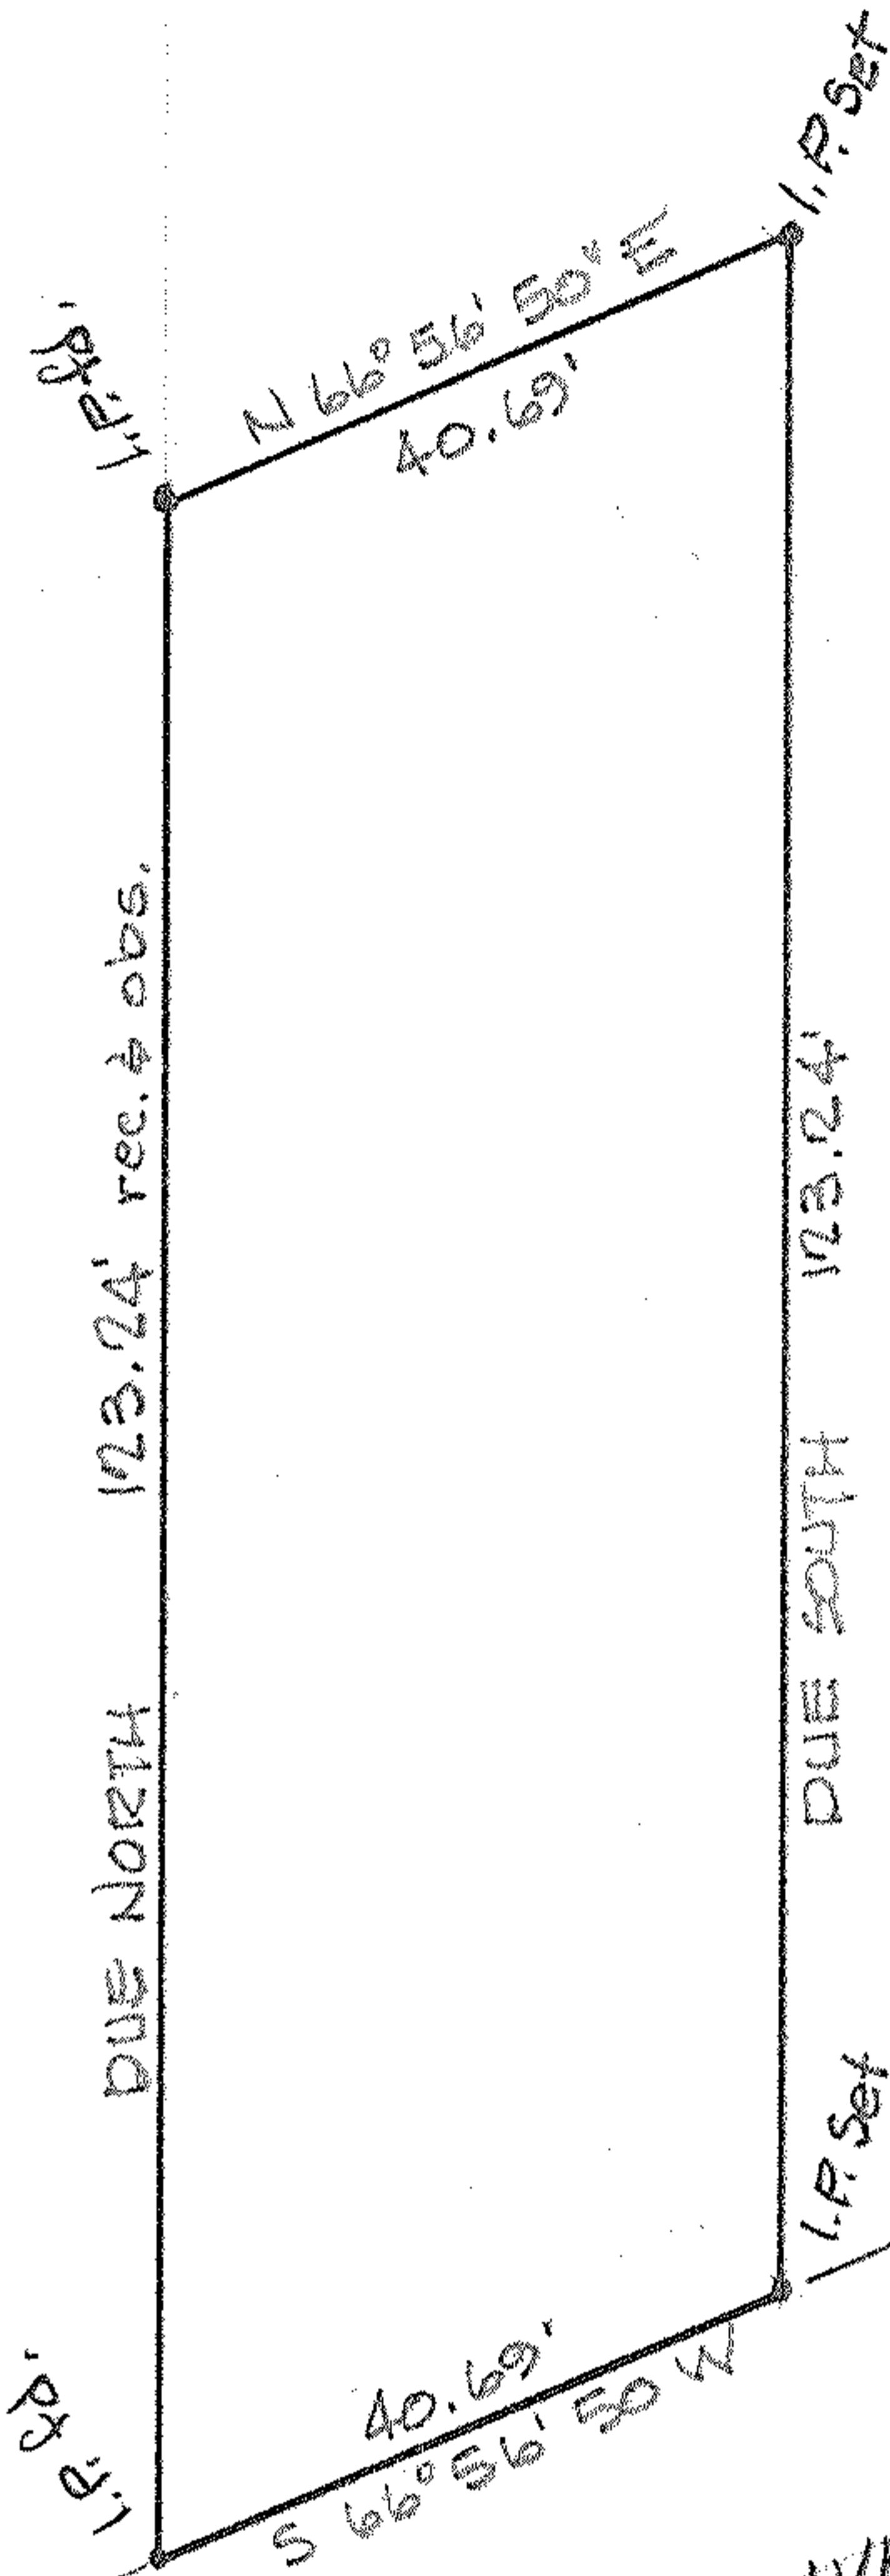

SCALE: 1" = 20'



MAP of SURVEY

PREPARED FOR FRANK SNEZEK

SUBLOT 673 of LAKE BREEZE ALLOTMENT

PART of ORIG. SHEFFIELD TWP. LOT No. 42

CITY of SHEFFIELD LAKE, LOZAIN CO., OHIO

McGLINCHY & ASSOC. INC

OHIO

MAY, 1977 #795290