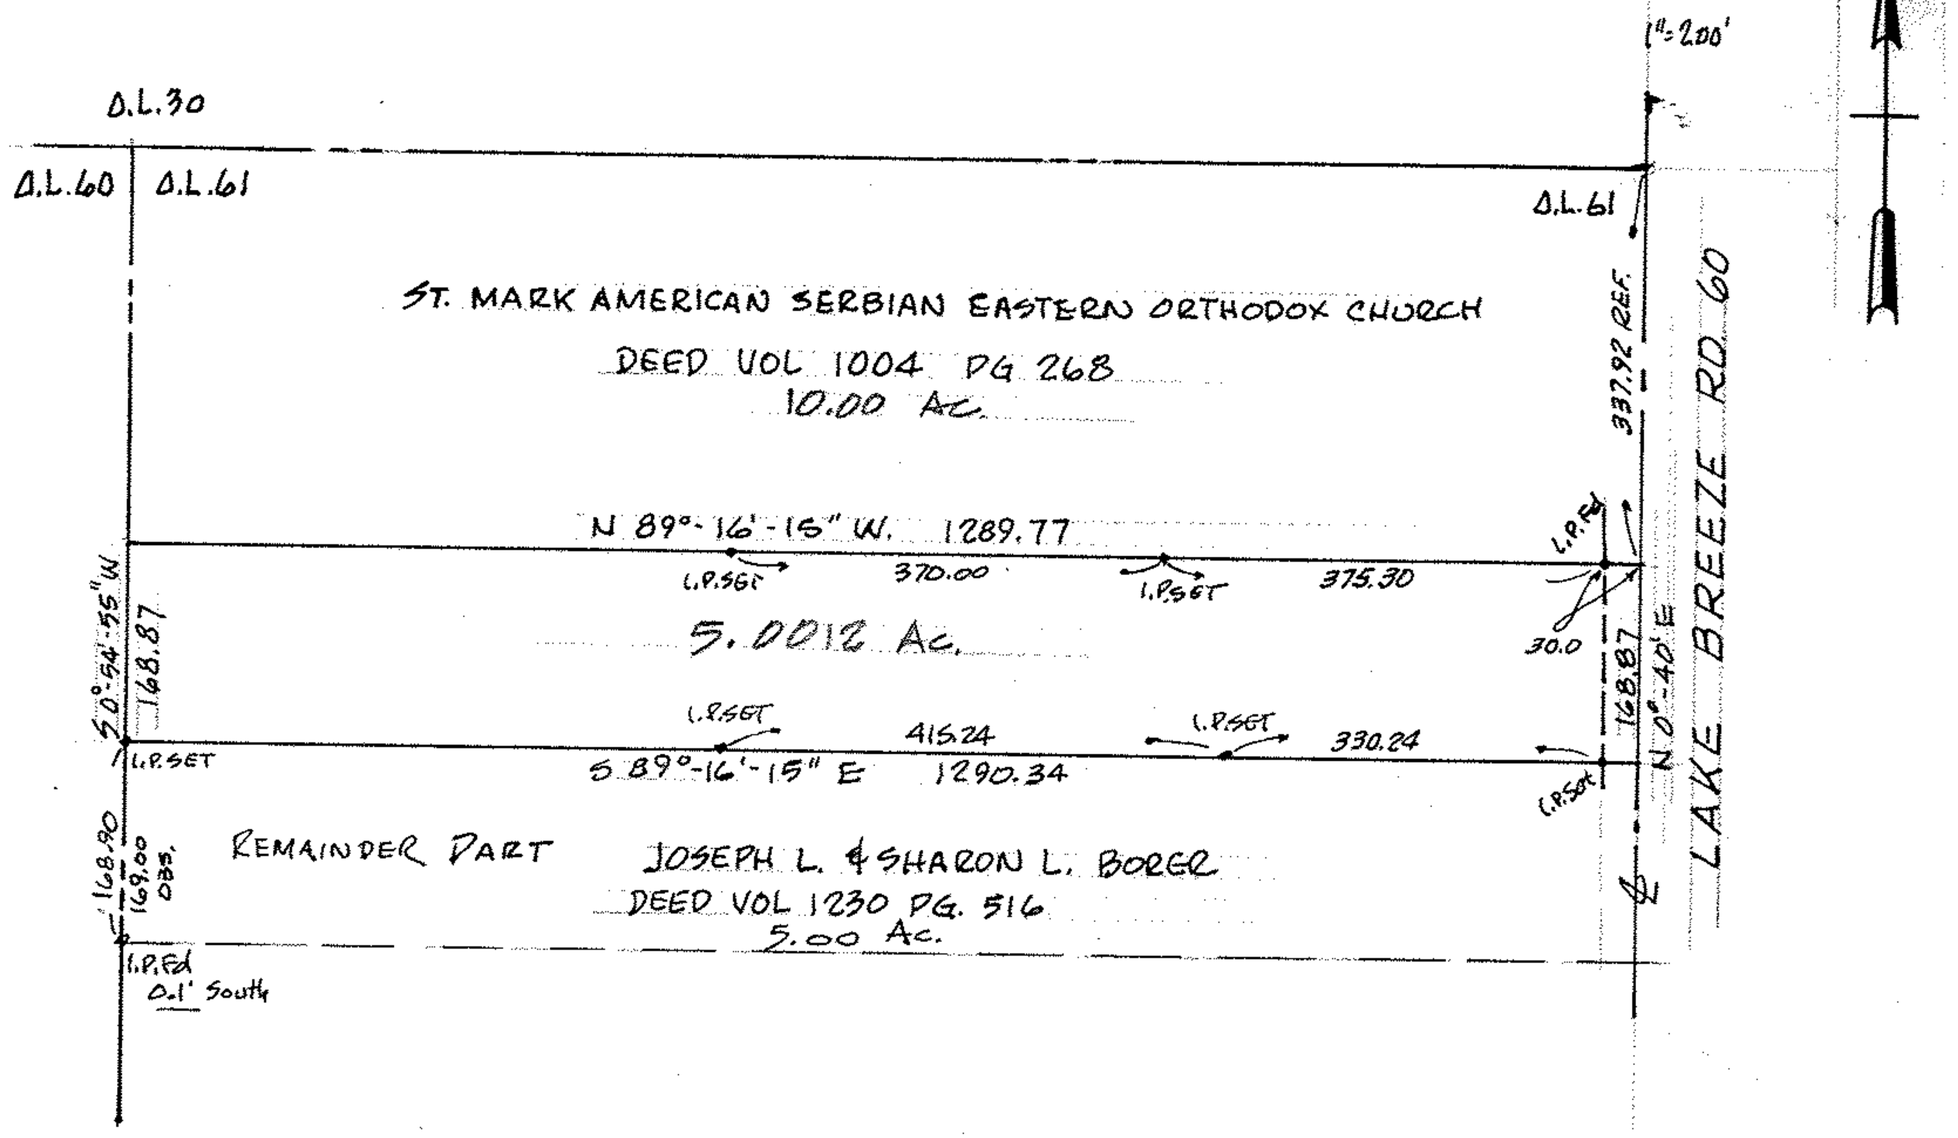

PART of ORIG. P.P.# 03-00-061-000-002
TAX MAP PAGE 03-00-061 A

SUBLOT of

PLAT VOL. PAGE
PART of ORIG. SHEFFIELD **TWP. LOT** 61
NOW in CITY of **, OHIO**
SHEFFIELD VILLAGE - LORAIN COUNTY, OHIO

THIS IS A PLAT OF SURVEY:

Mc GLINCHY & ASSOCIATES INC.

FEB **1982** **#827115**