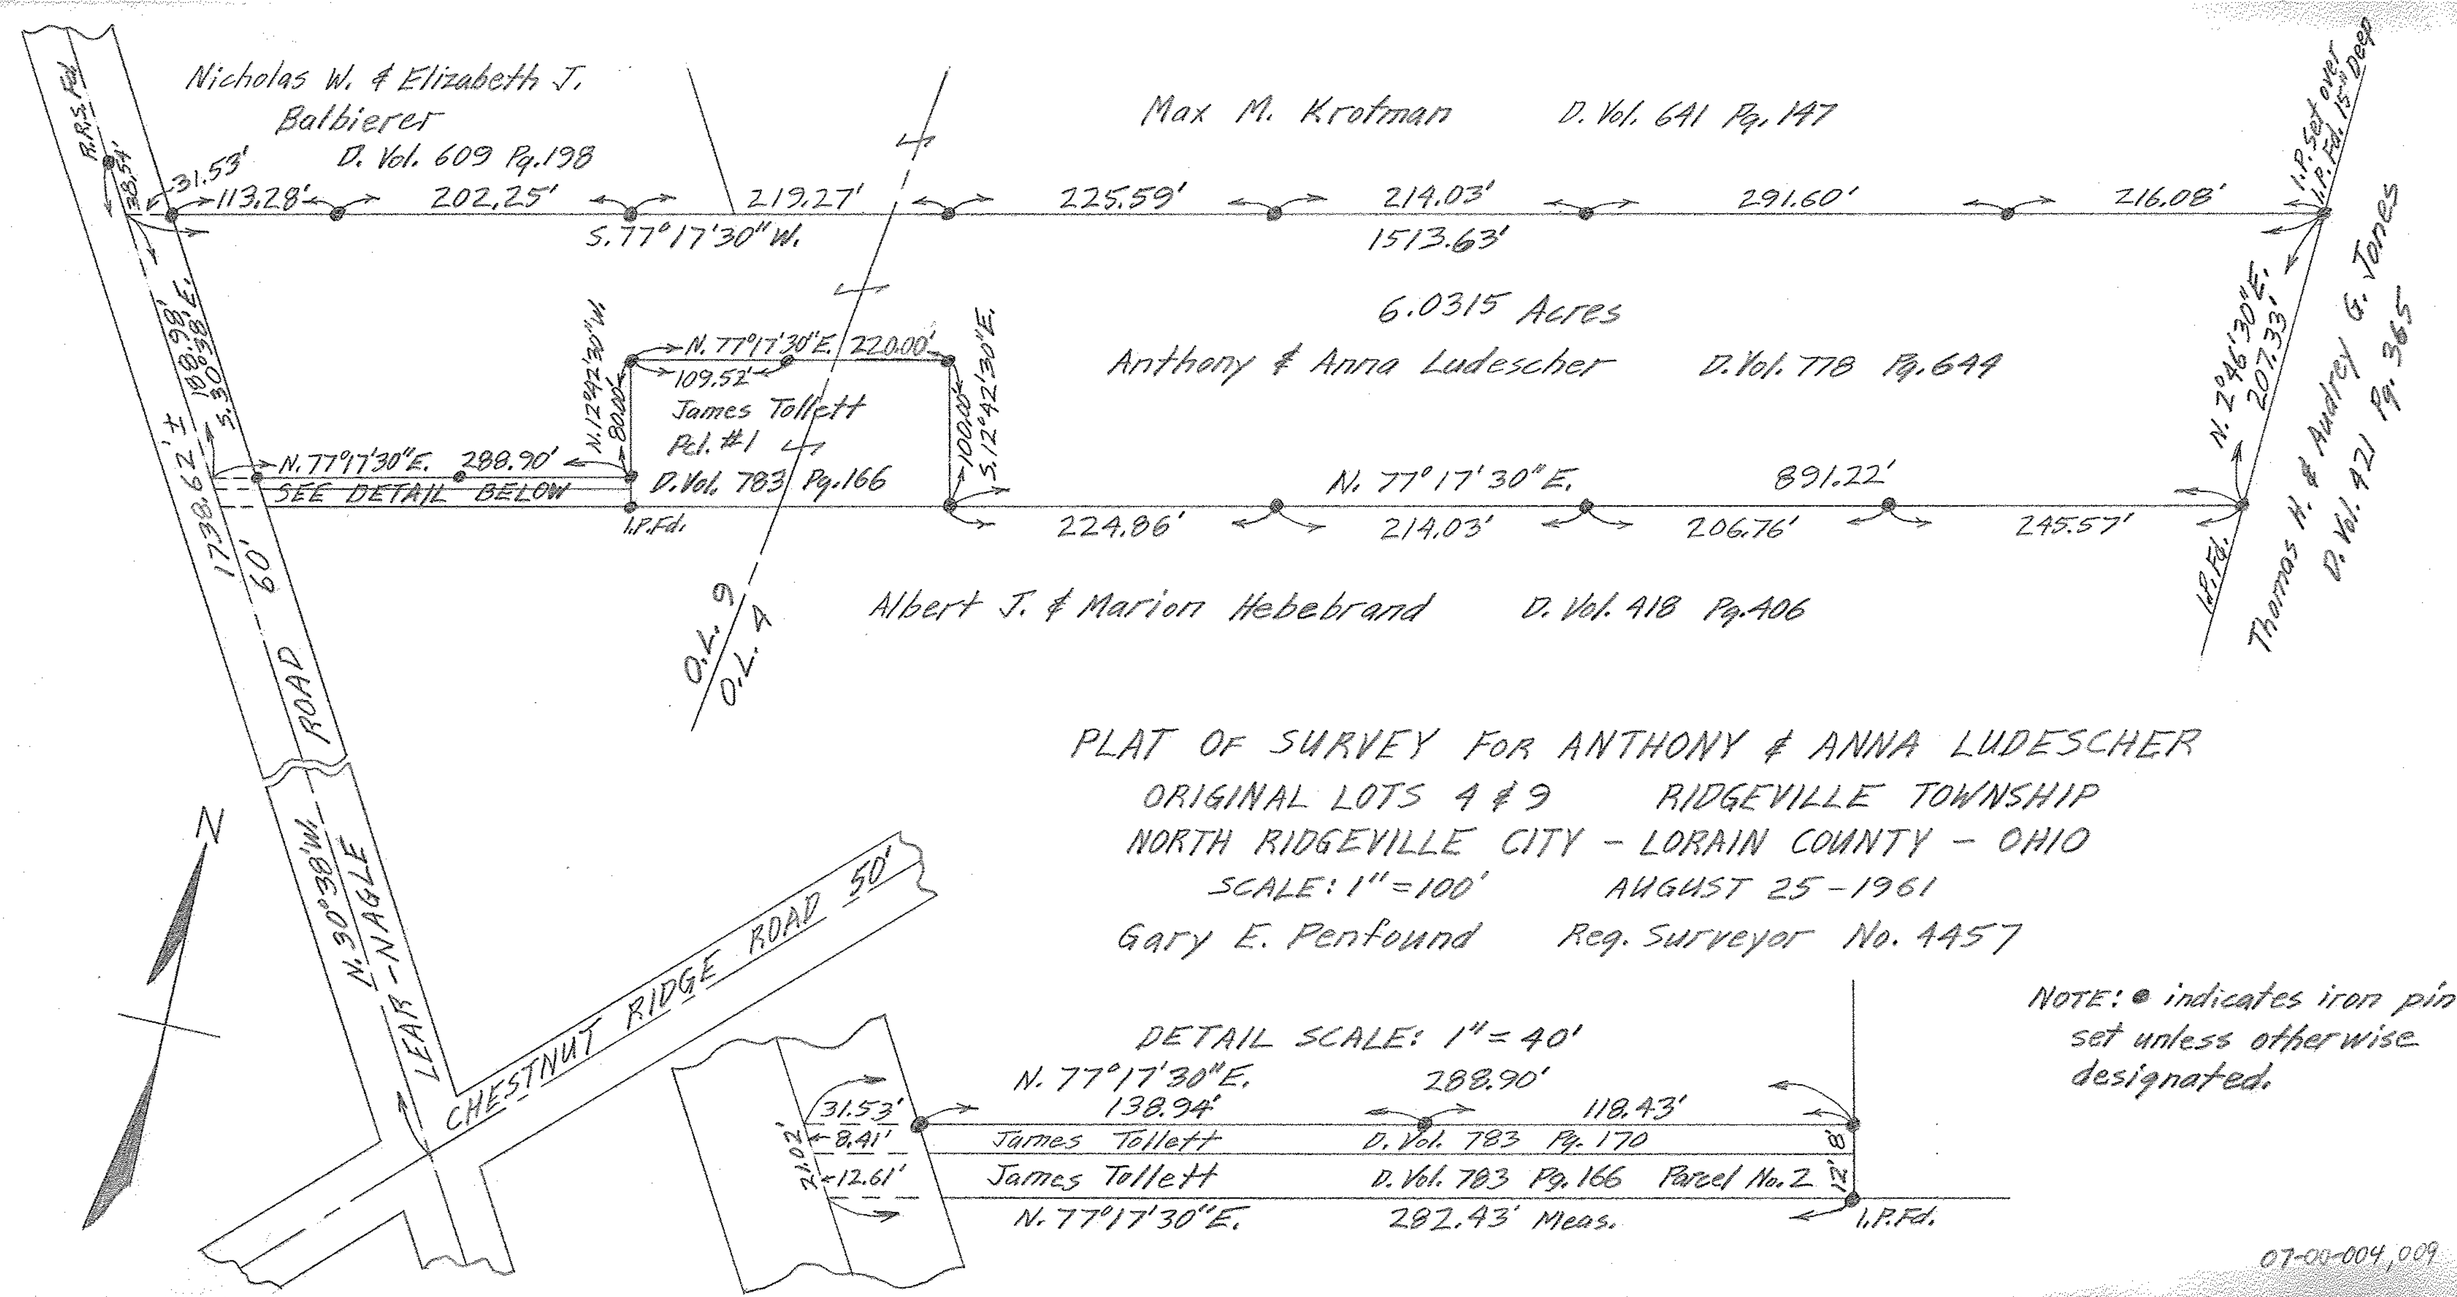

PLAT OF SURVEY FOR ANTHONY & ANNA LUDESCHER

ORIGINAL LOTS 4 & 9 RIDGEVILLE TOWNSHIP

NORTH RIDGEVILLE CITY - LORAIN COUNTY - OHIO

SCALE: 1" = 100' AUGUST 25 - 1961

Gary E. Penfound Reg. Surveyor No. 4457

NOTE: ● indicates iron pin set unless otherwise designated.

07-00-004,009