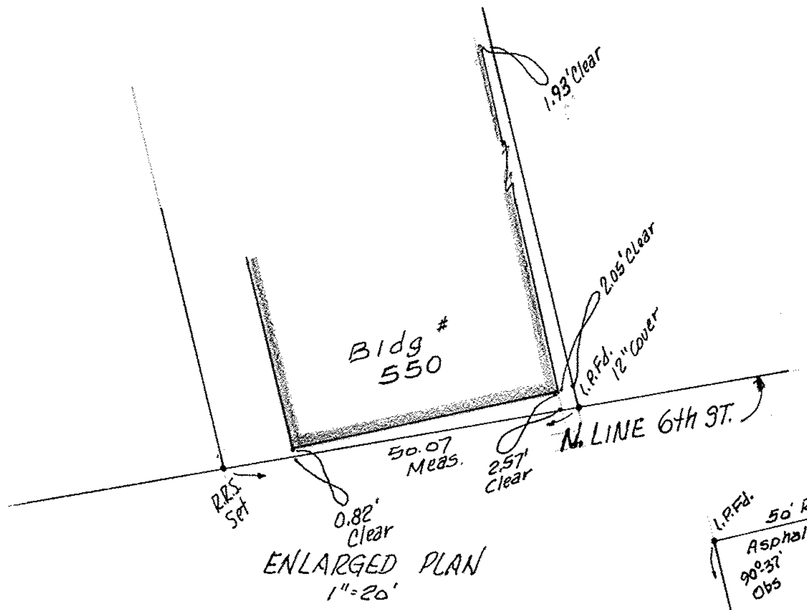

ENLARGED PLAN
1"=20'

1" = 40'

MISC. SURVEY DATA FOR THIS AREA OBTAINED FROM LORAIN CITY ENGINEERING DEPT.

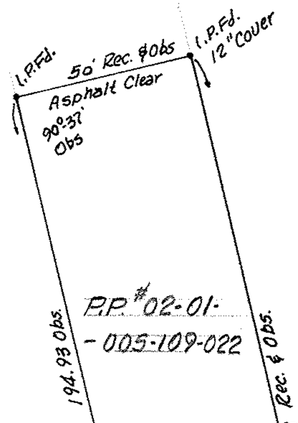

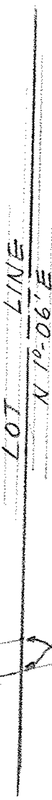

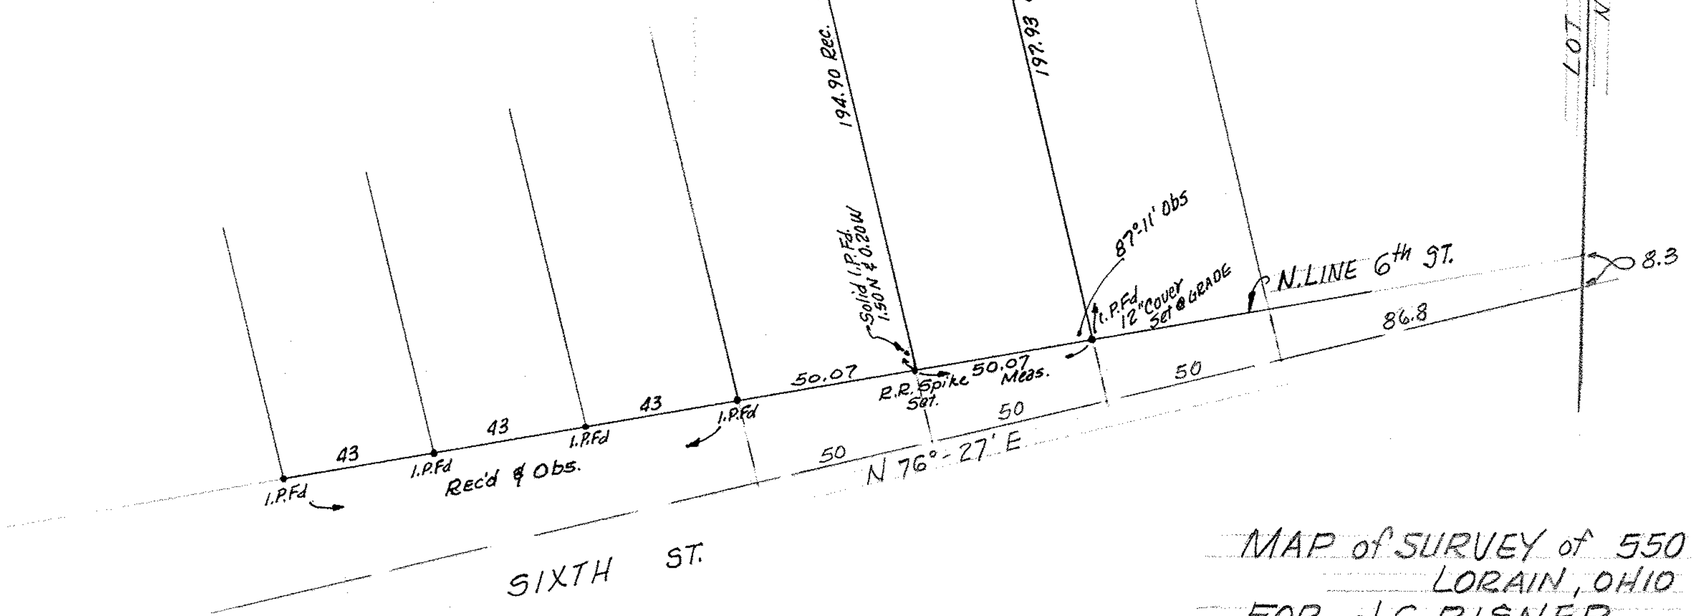

MAP of SURVEY of 550 6th ST.
LORAIN, OHIO
FOR J.C. RISNER

McGLINCHY & ASSOCIATES INC.
REGISTERED SURVEYORS
MAY 1983 837731s
MINN. T. E21-684