PLAT OF SURVEY FOR
FRED H. STOBE

ORIGINAL LOT NO. 23 RIDGEVILLE TWP.
NORTH RIDGEVILLE CITY -- LORAIN COUNTY - OHIO
SCALE: 1" = 60' MAY 1970
Gary E. Pentfound Reg. Surveyor No. 4457

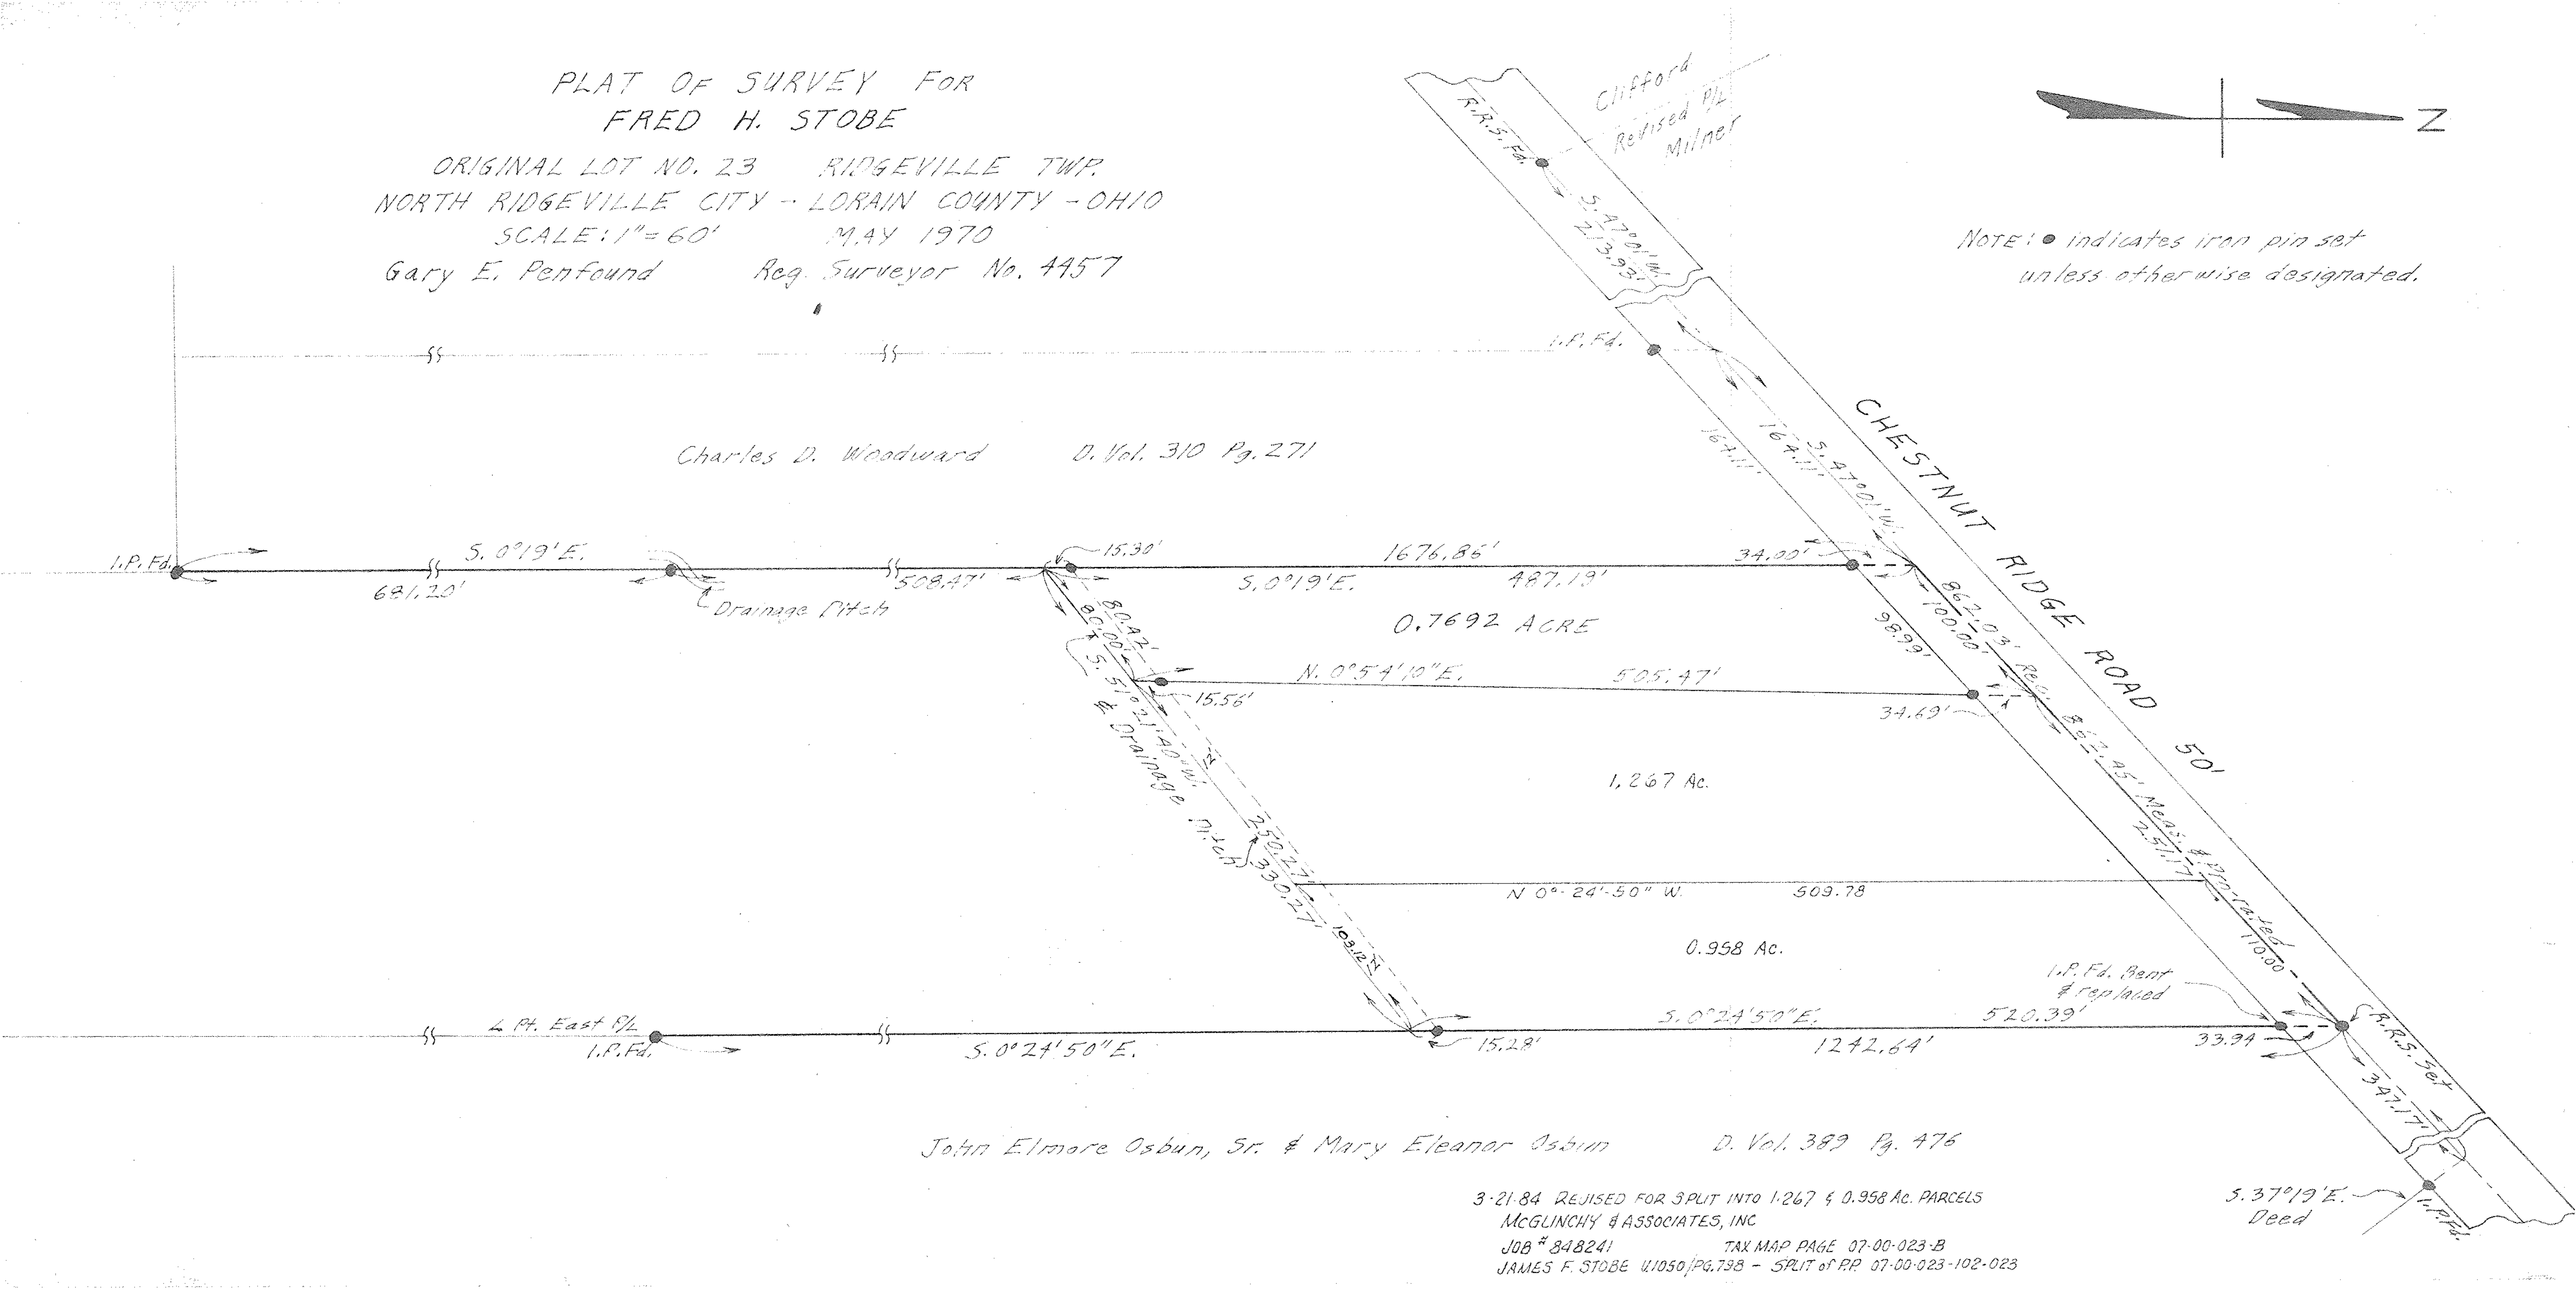

NOTE: ● indicates iron pin set unless otherwise designated.

3-21-84 REVISED FOR SPLIT INTO 1.267 & 0.958 Ac. PARCELS
McGLINCHY & ASSOCIATES, INC
JOB # 848241 TAX MAP PAGE 07-00-023-B
JAMES F. STOBE V.1050/PG.738 - SPLIT of P.P. 07-00-023-102-023