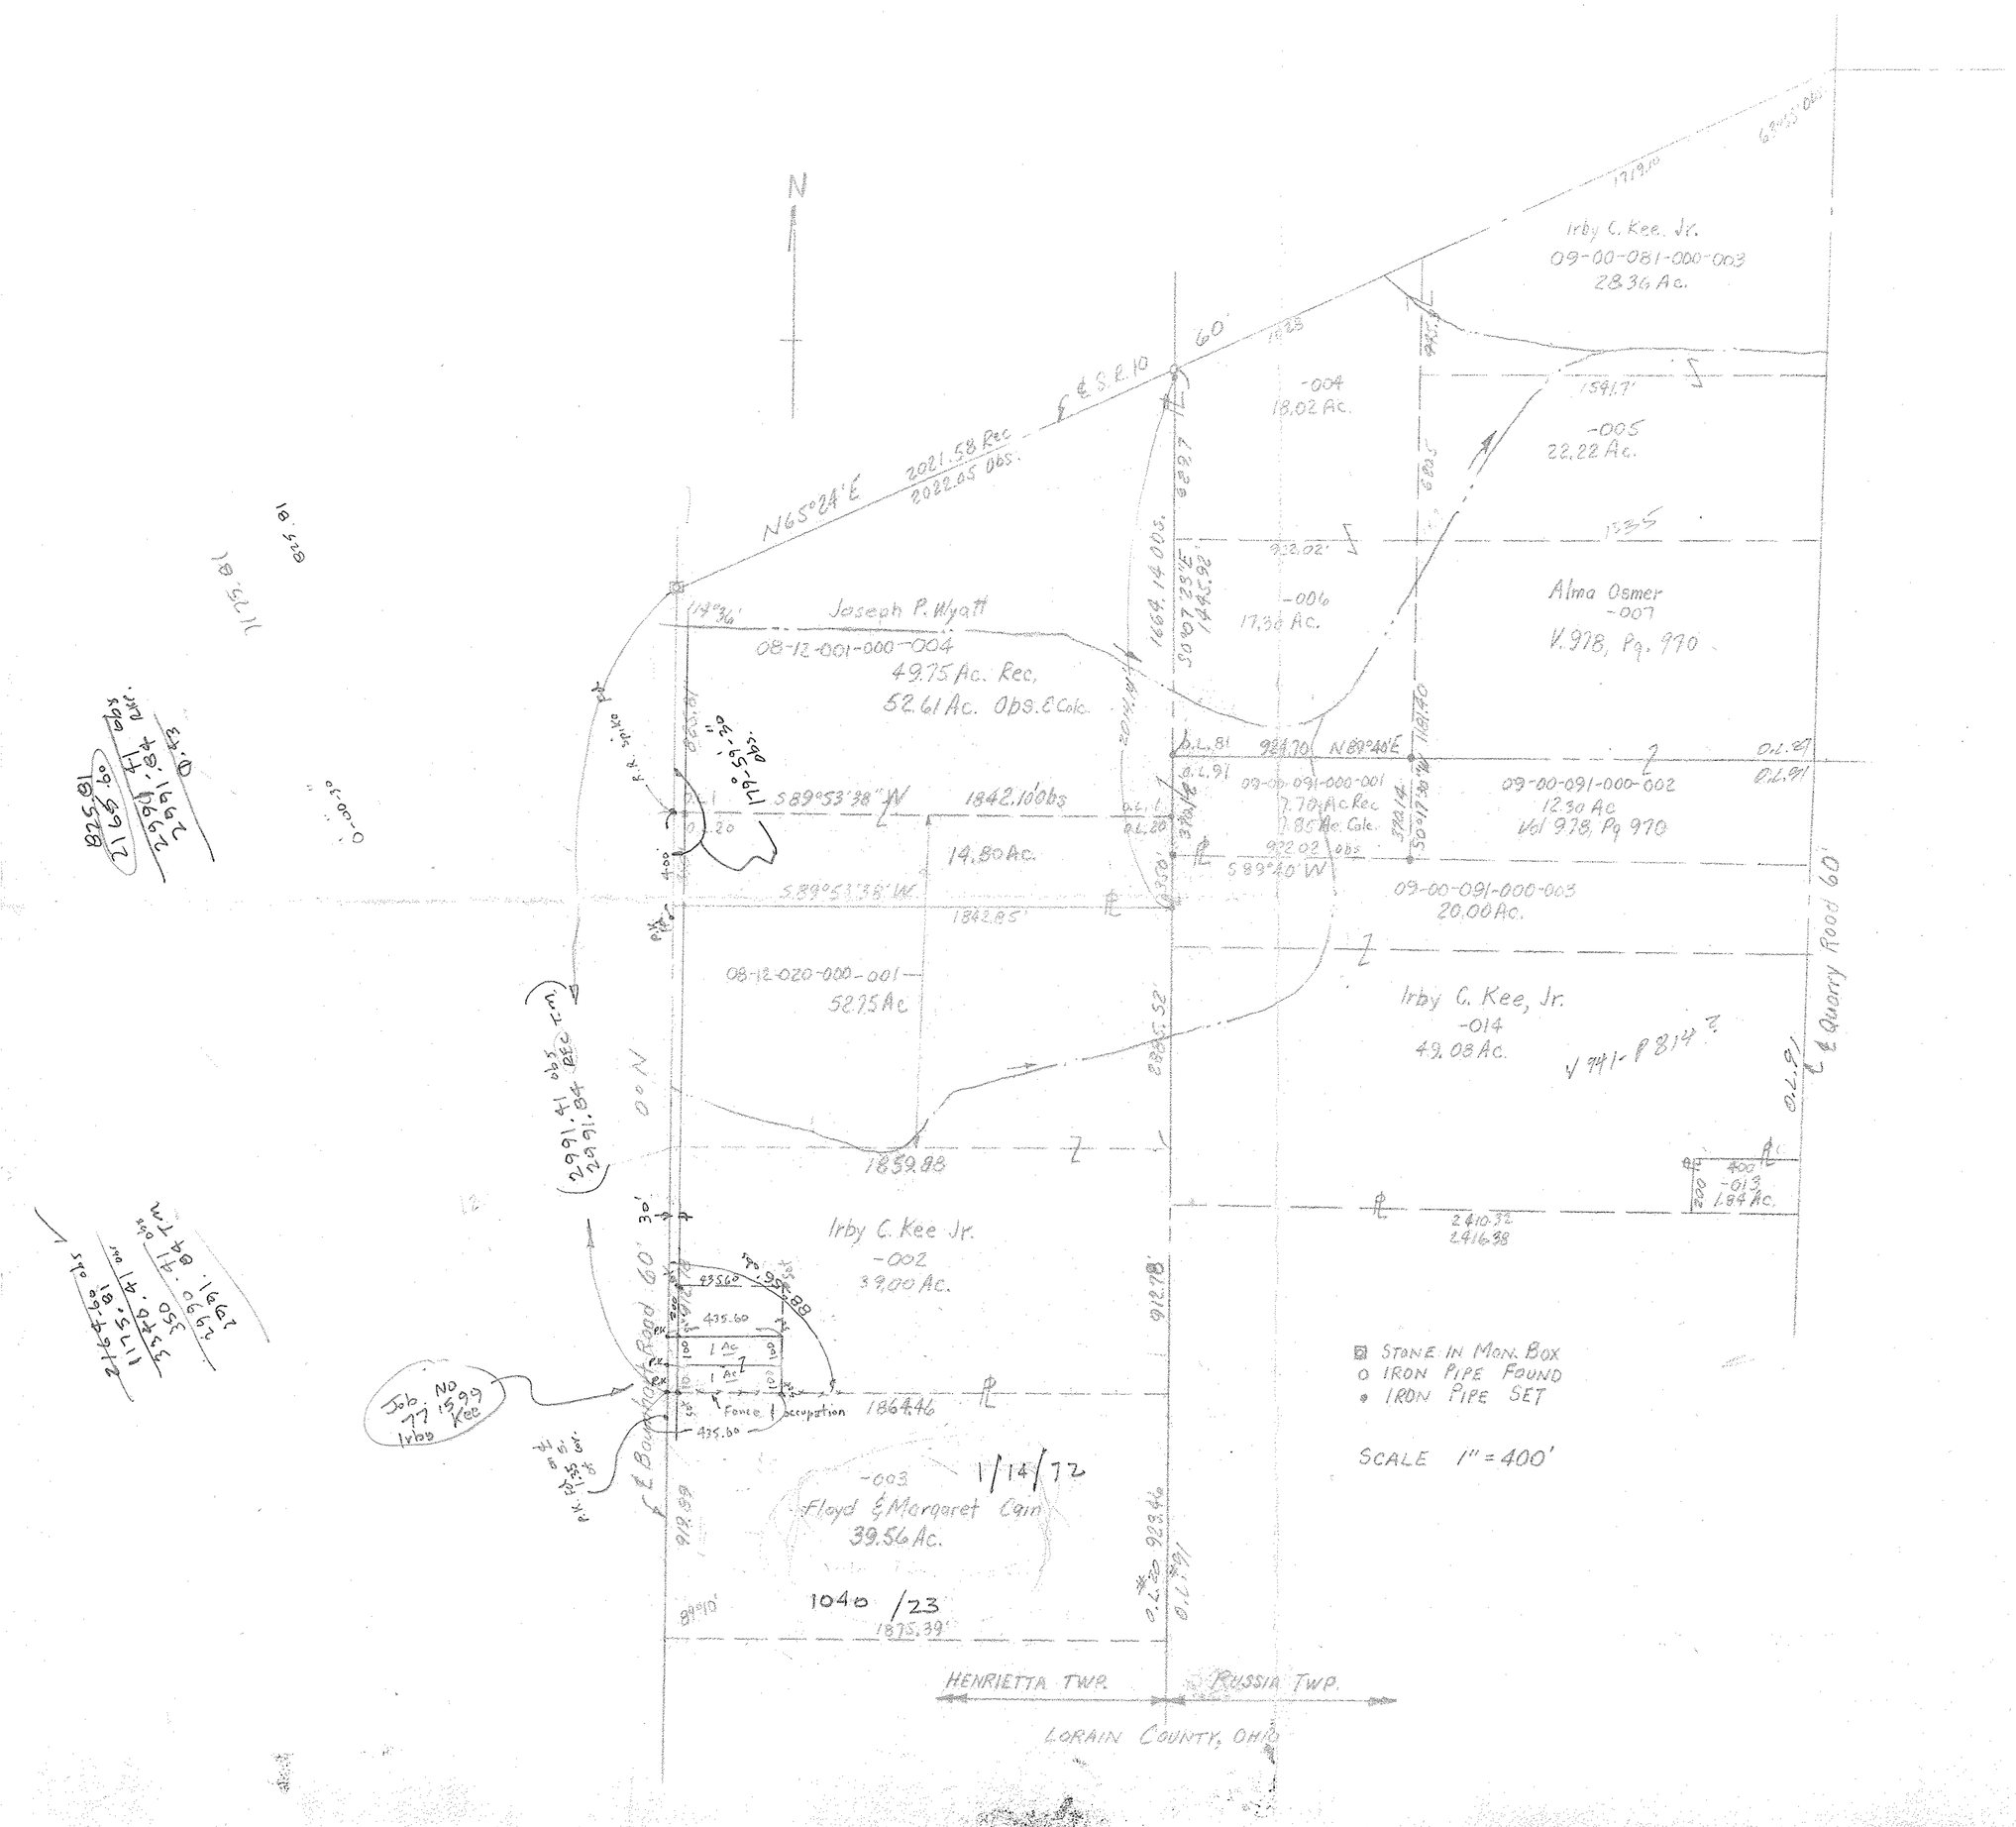

JOB No. 771599

PLAT OF LANDS OWNED BY
JOSEPH P. WYATT & IRBY C. KEE JR.
HENRIETTA & RUSSIA TWP.
LORAIN COUNTY, OHIO

McGLINCHY & ASSOCIATES
PROFESSIONAL ENGR'S & SURVEYORS
538 W. BROAD ST. ELYRIA, OHIO
APRIL, 1975 JOB No. 7533