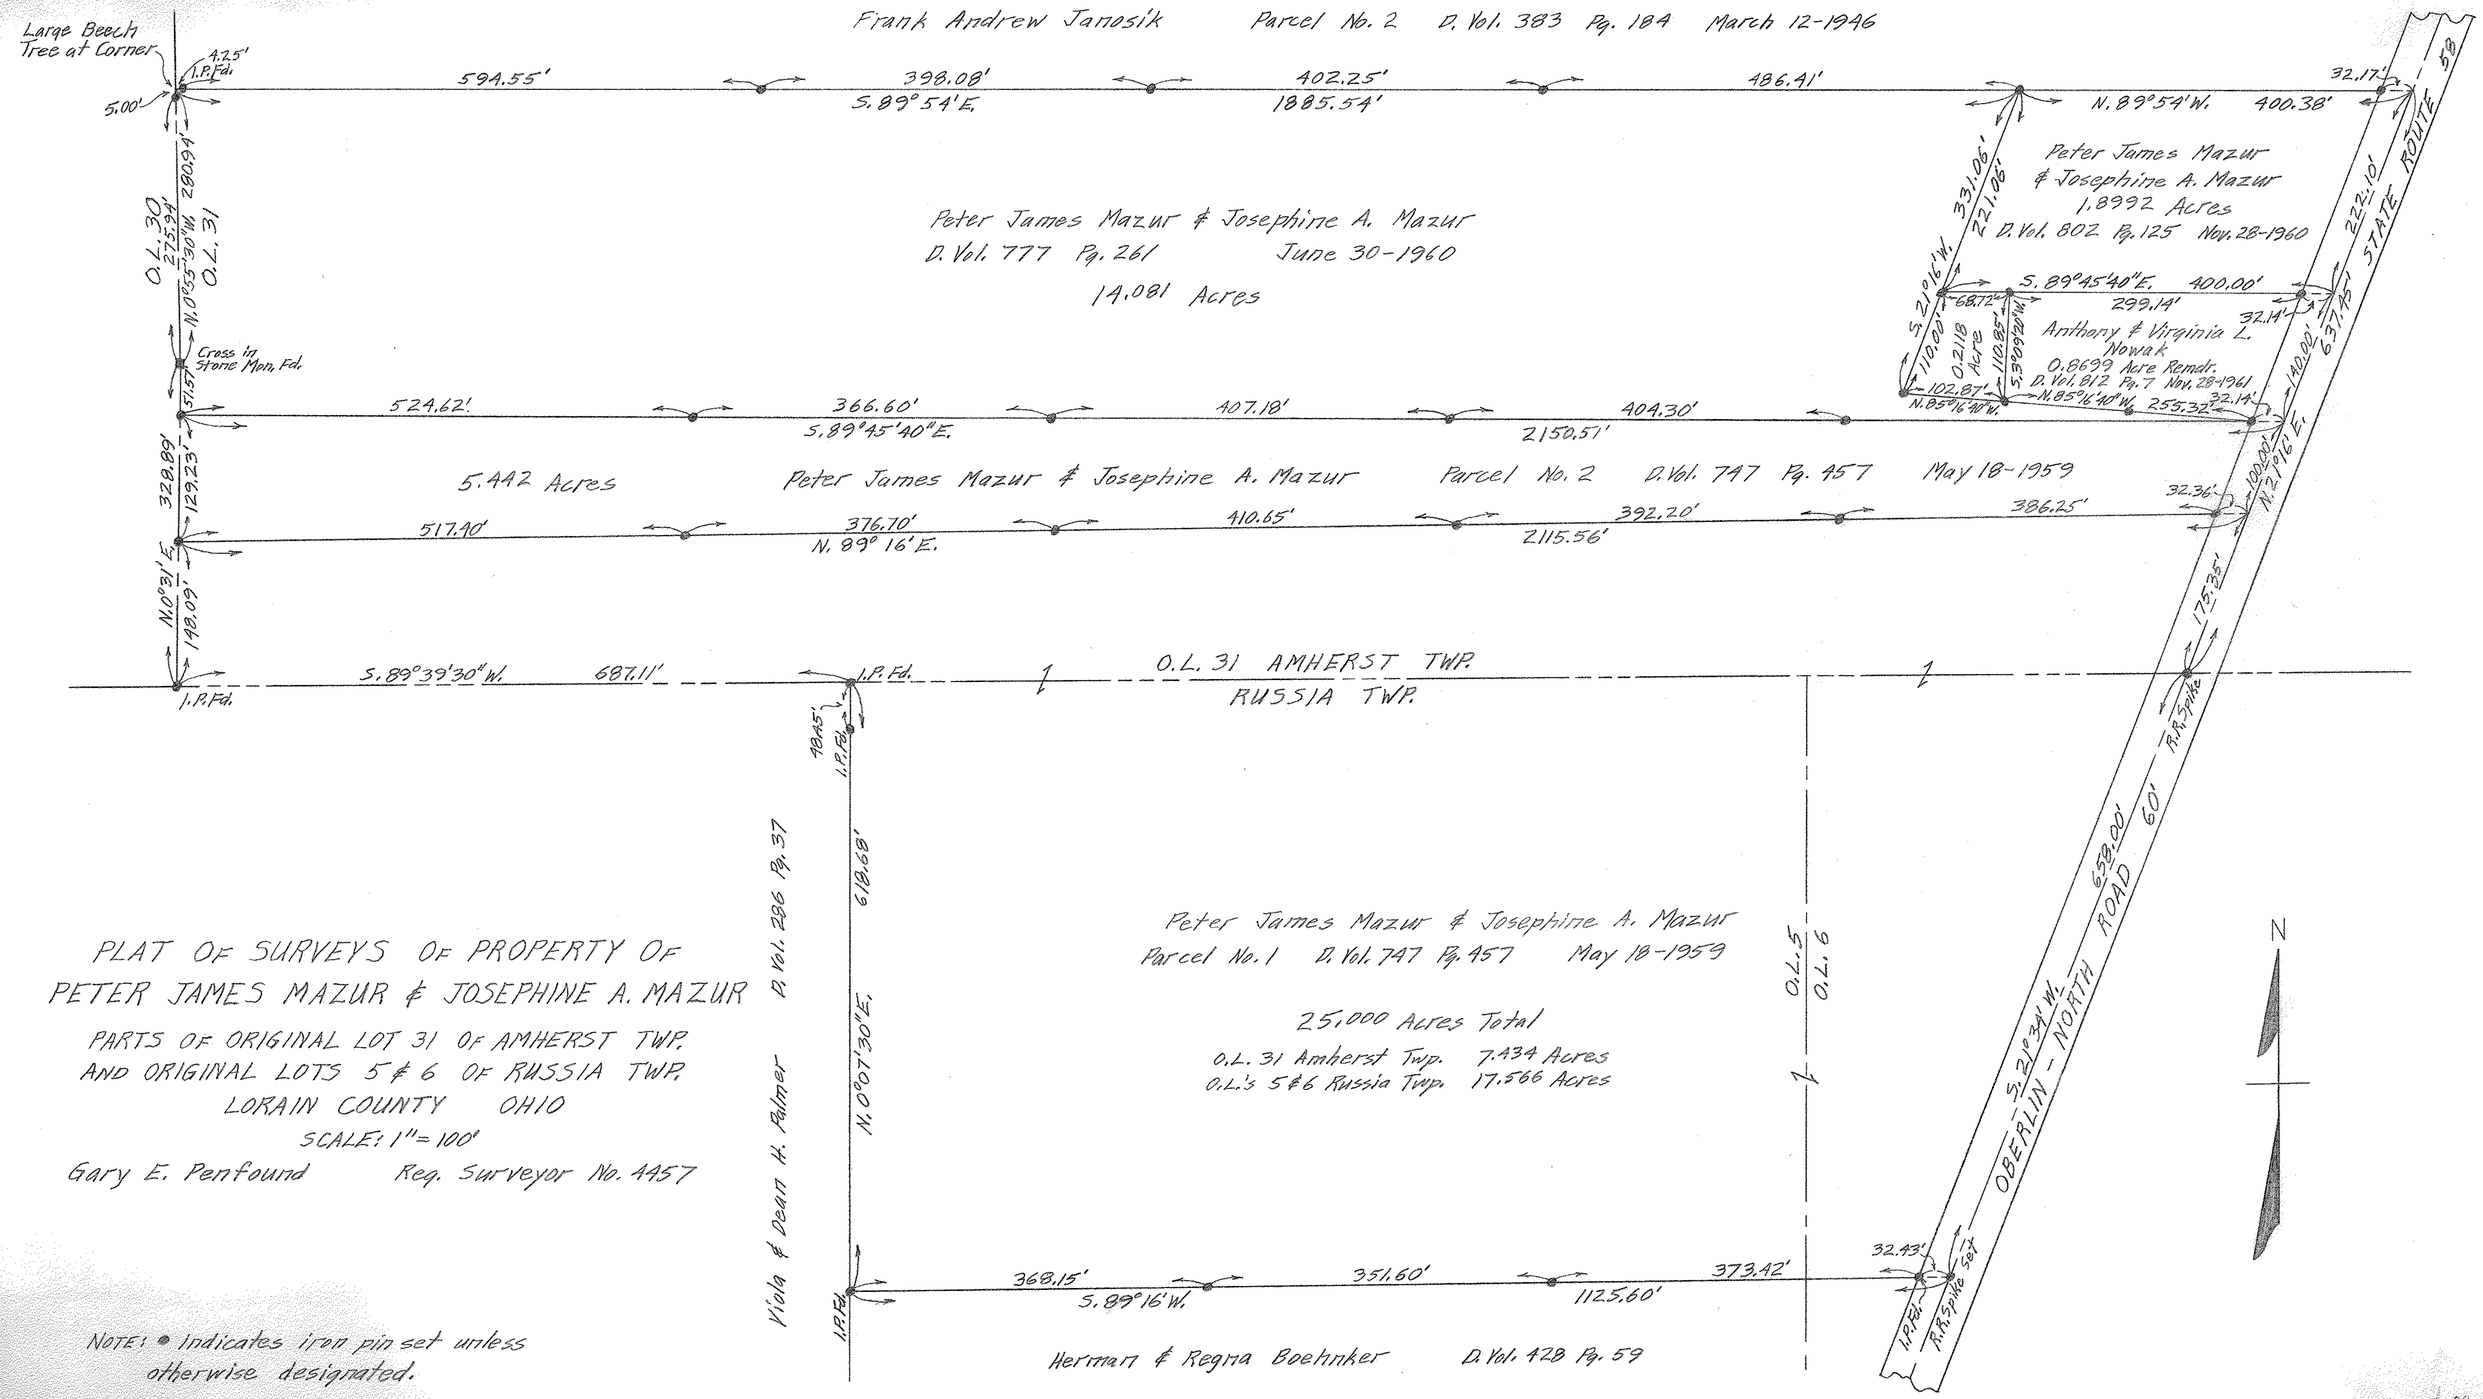

PLAT OF SURVEYS OF PROPERTY OF
PETER JAMES MAZUR & JOSEPHINE A. MAZUR

PARTS OF ORIGINAL LOT 31 OF AMHERST TWP.
AND ORIGINAL LOTS 5 & 6 OF RUSSIA TWP.
LORAIN COUNTY OHIO

SCALE: 1" = 100'

Gary E. Penfound Reg. Surveyor No. 4457

NOTE: ● Indicates iron pin set unless otherwise designated.

05-00-031
09-00-005,6