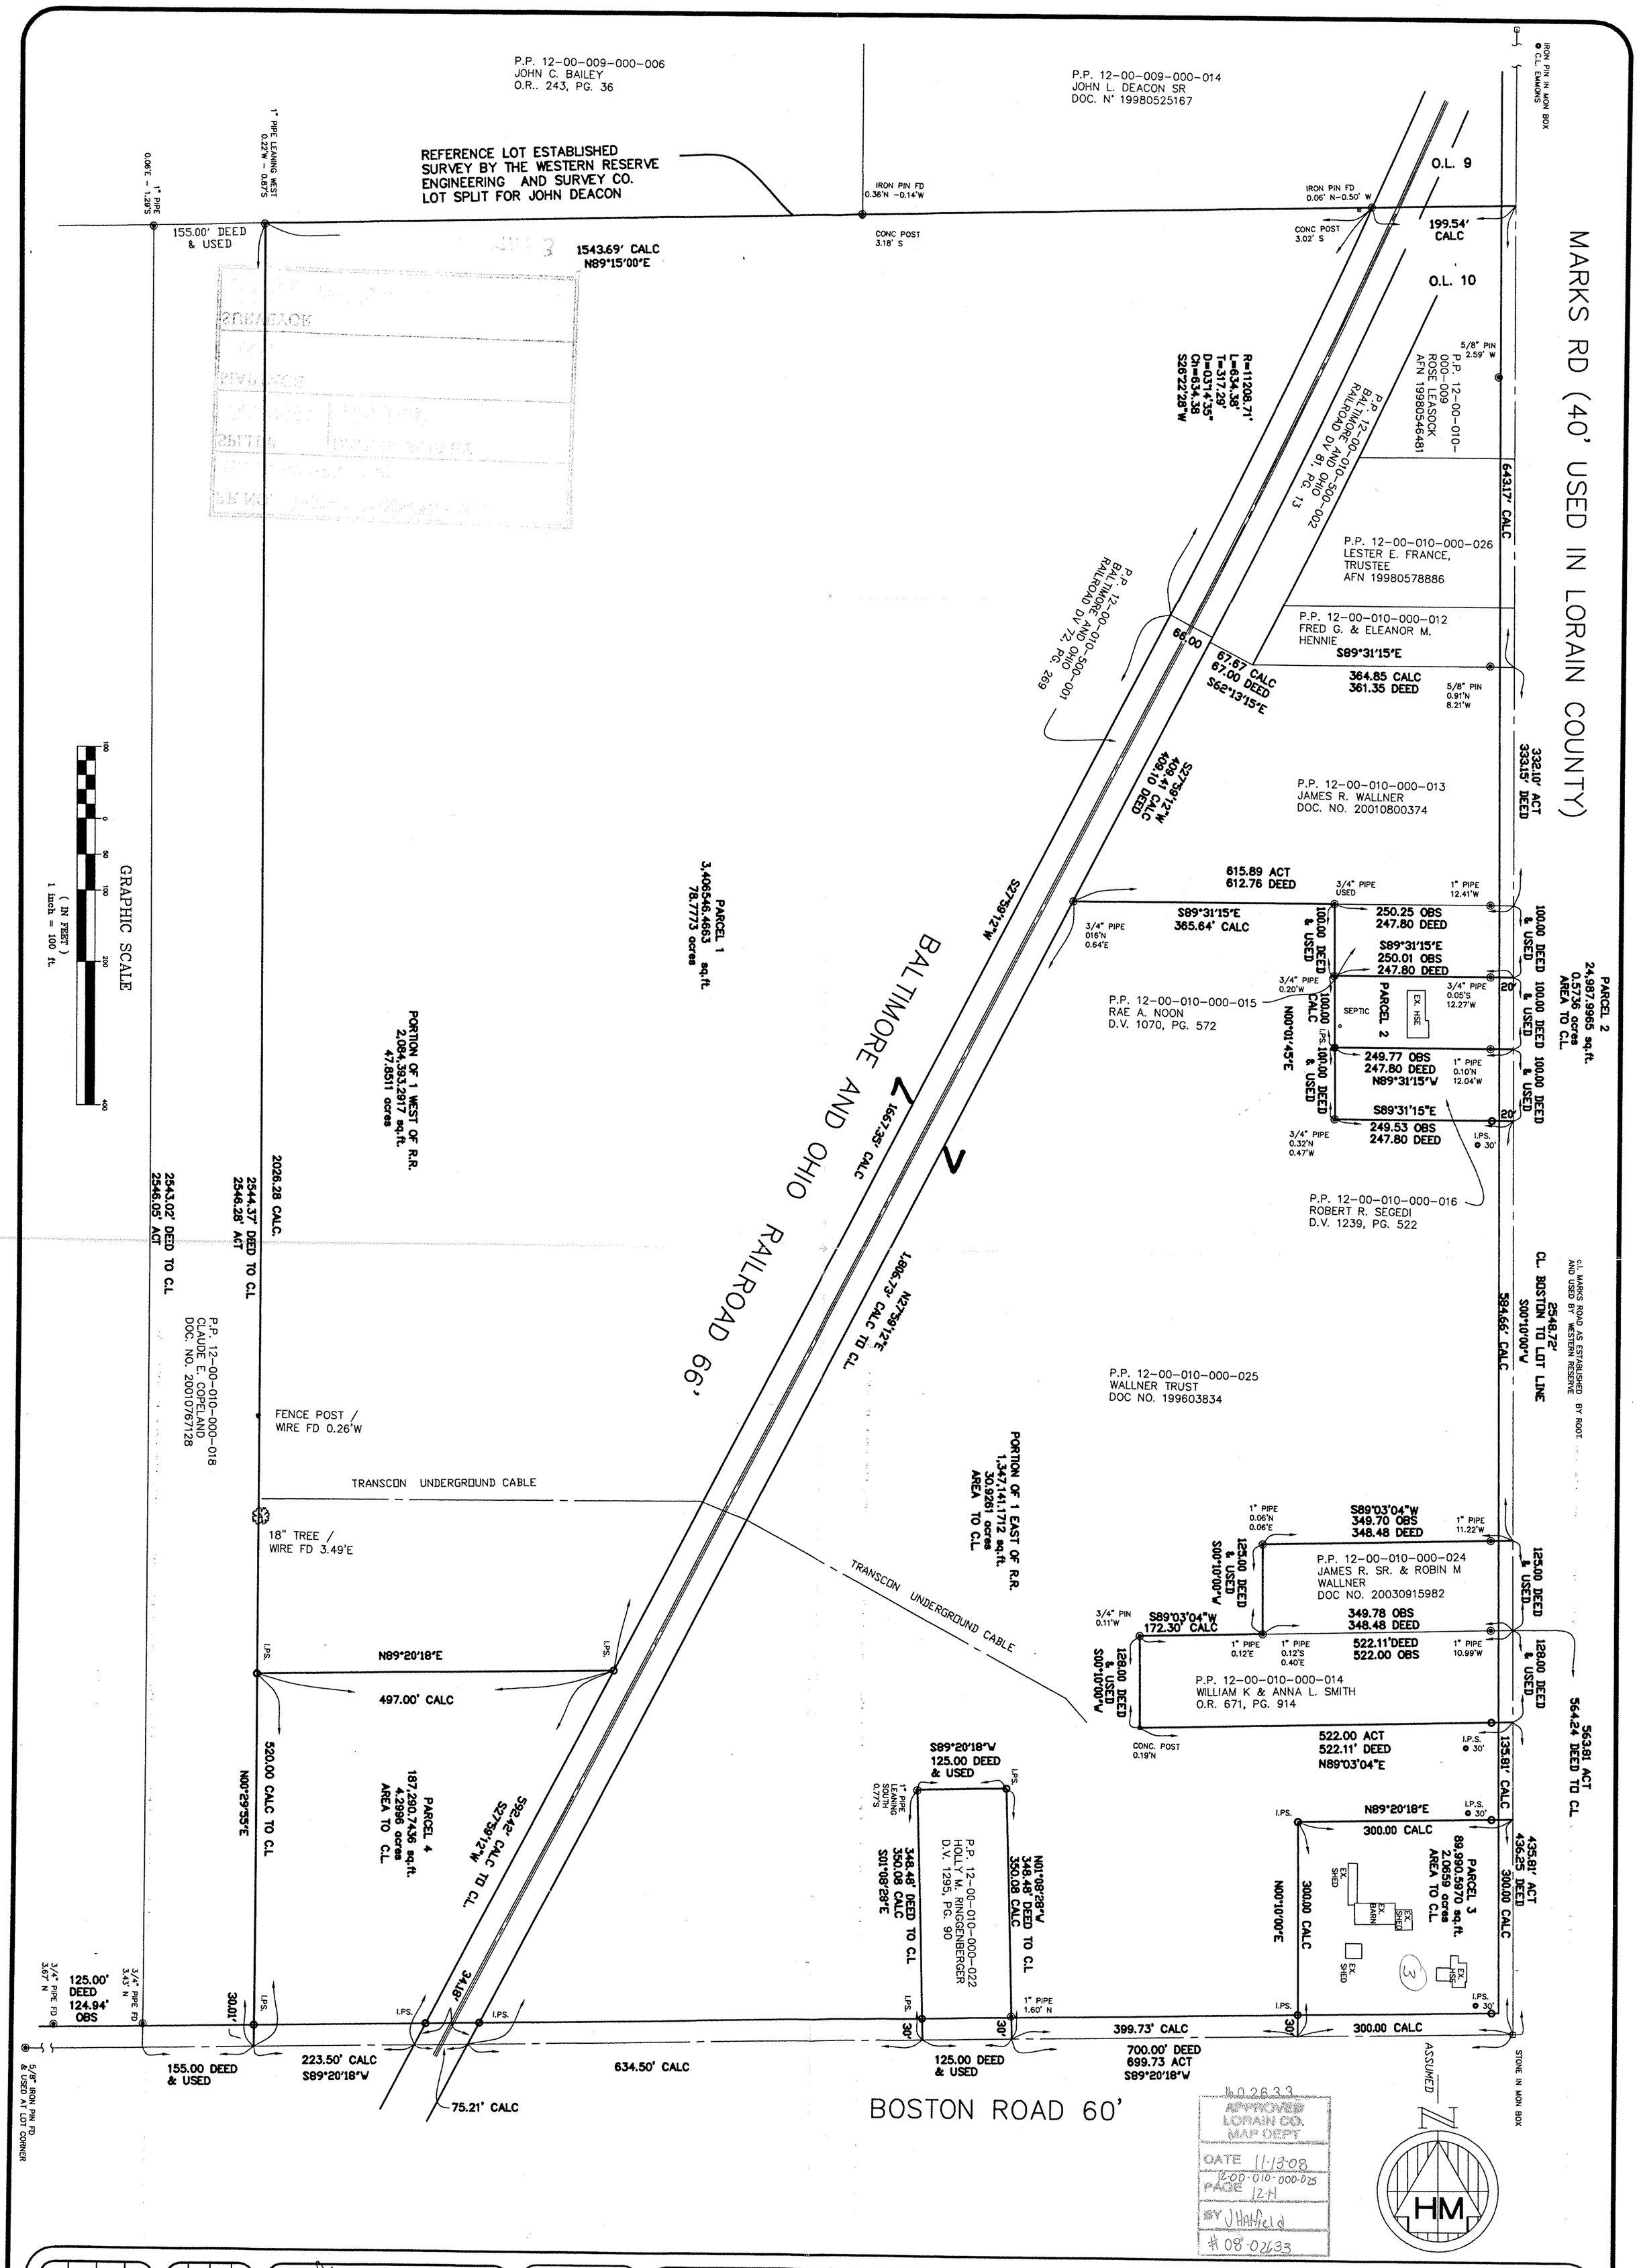

LOT SPLIT MADE AT THE INSTANCE OF

THE WALLNER TRUST

ORIGINAL COLUMBIA TOWNSHIP LOT N° 10
LORAIN COUNTY, OHIO

DRAWING.DWG	1/1
ORDER NO. 03-316	
F.B. 789 PG.	
JULY 28,2004	

NO.	REVISION	DATE

GEORGE A. HOFMANN
DATE

STATE OF OHIO — GEORGE A. HOFMANN 6752 — REGISTERED SURVEYOR

HOFMANN-METZKER, INC.
REGISTERED PROFESSIONAL SURVEYORS
24 BEECH ST - P.O. BOX 343
BEREA, OHIO 44017
440-234-7350 FAX 440-234-7351
GEORGE HOFMANN E-MAIL
george_hm@ameritechnet