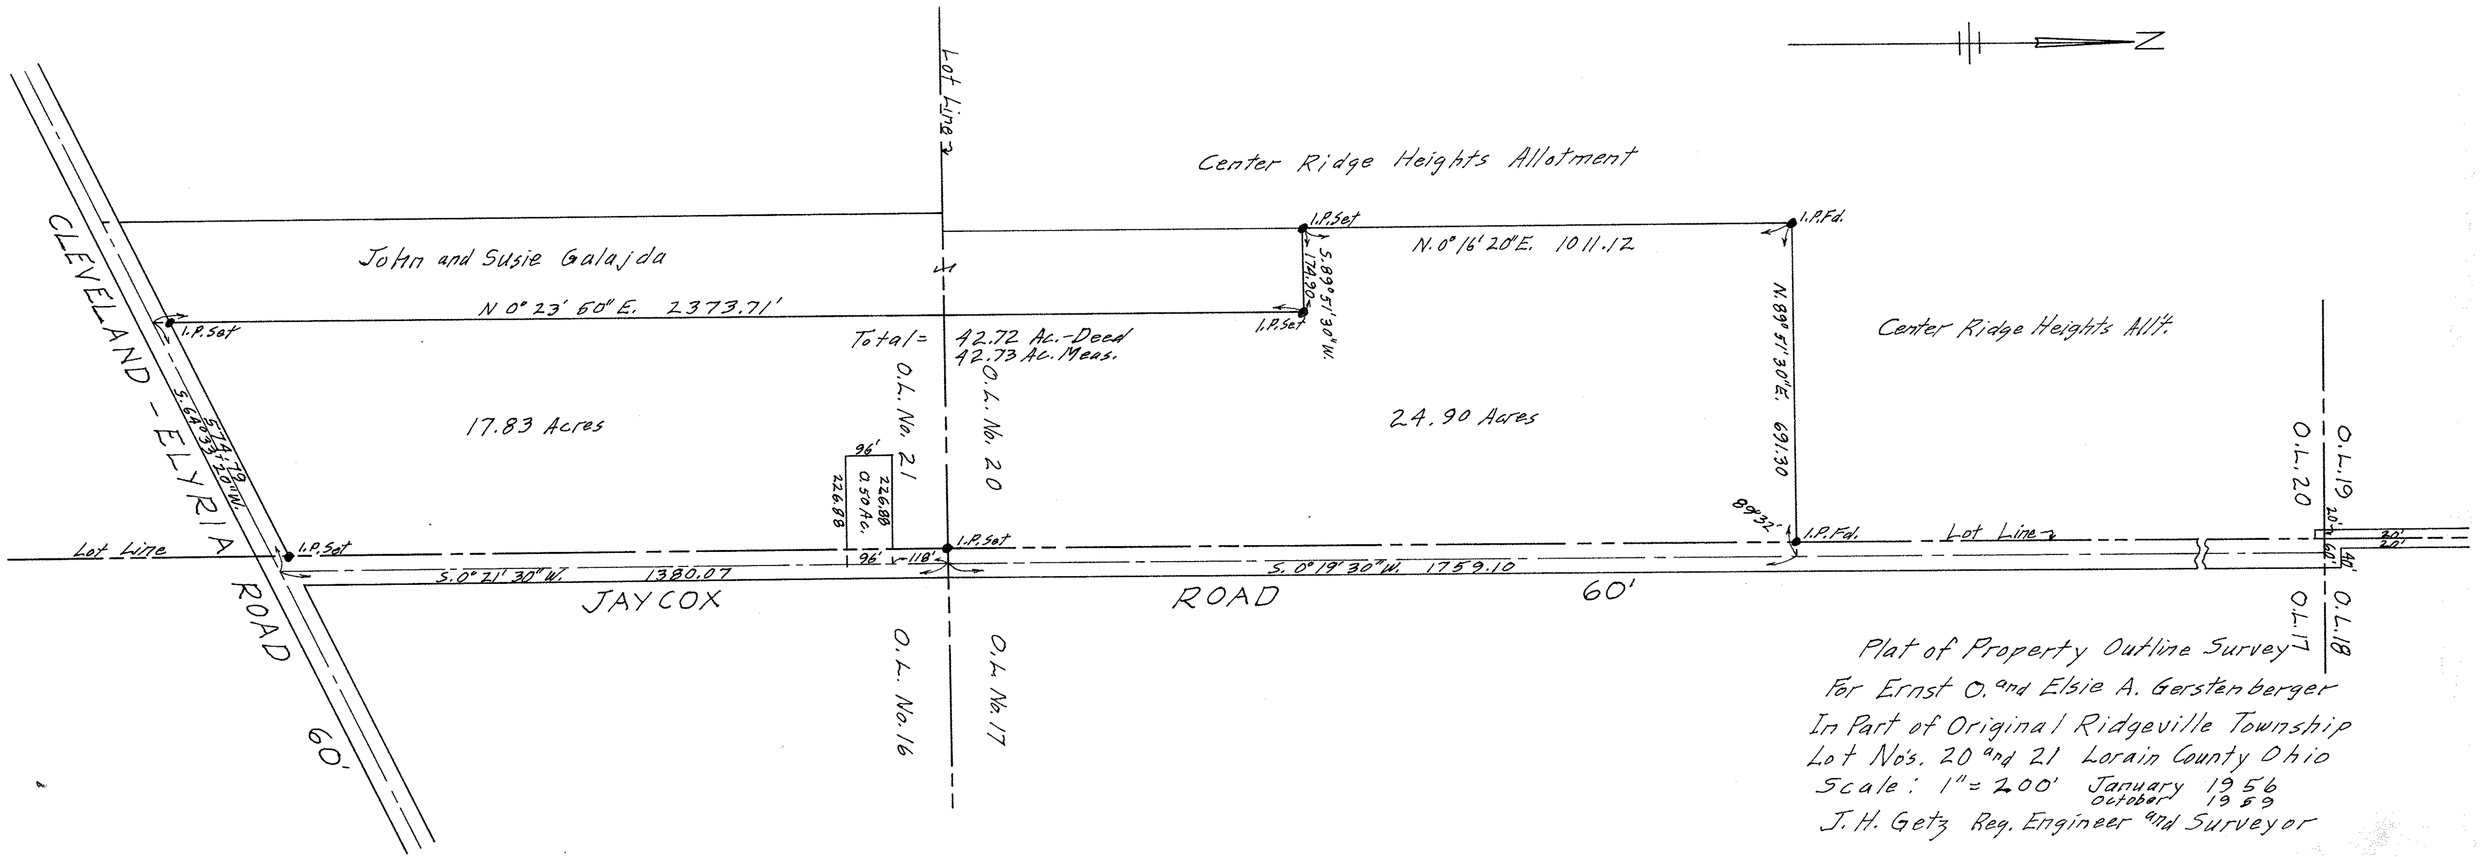

Plat of Property Outline Survey
For Ernst O. and Elsie A. Gerstenberger
In Part of Original Ridgeville Township
Lot No's. 20 and 21 Lorain County Ohio
Scale: 1" = 200' January 1956
October 1969
J. H. Getz Reg. Engineer and Surveyor

Traced July 24-1965 by G.E.P.

07-00-020,021