PLAT OF SURVEY FOR
THOMAS R. & JEWEL ALLEN
ORIG. LOTS 15 & 22 RIDGEVILLE TWP.
NORTH RIDGEVILLE VILLAGE
LORAIN COUNTY – OHIO
SCALE: 1" = 60' JULY 26 – 1960
Gary E. Penfound Reg. Surveyor No. 4457

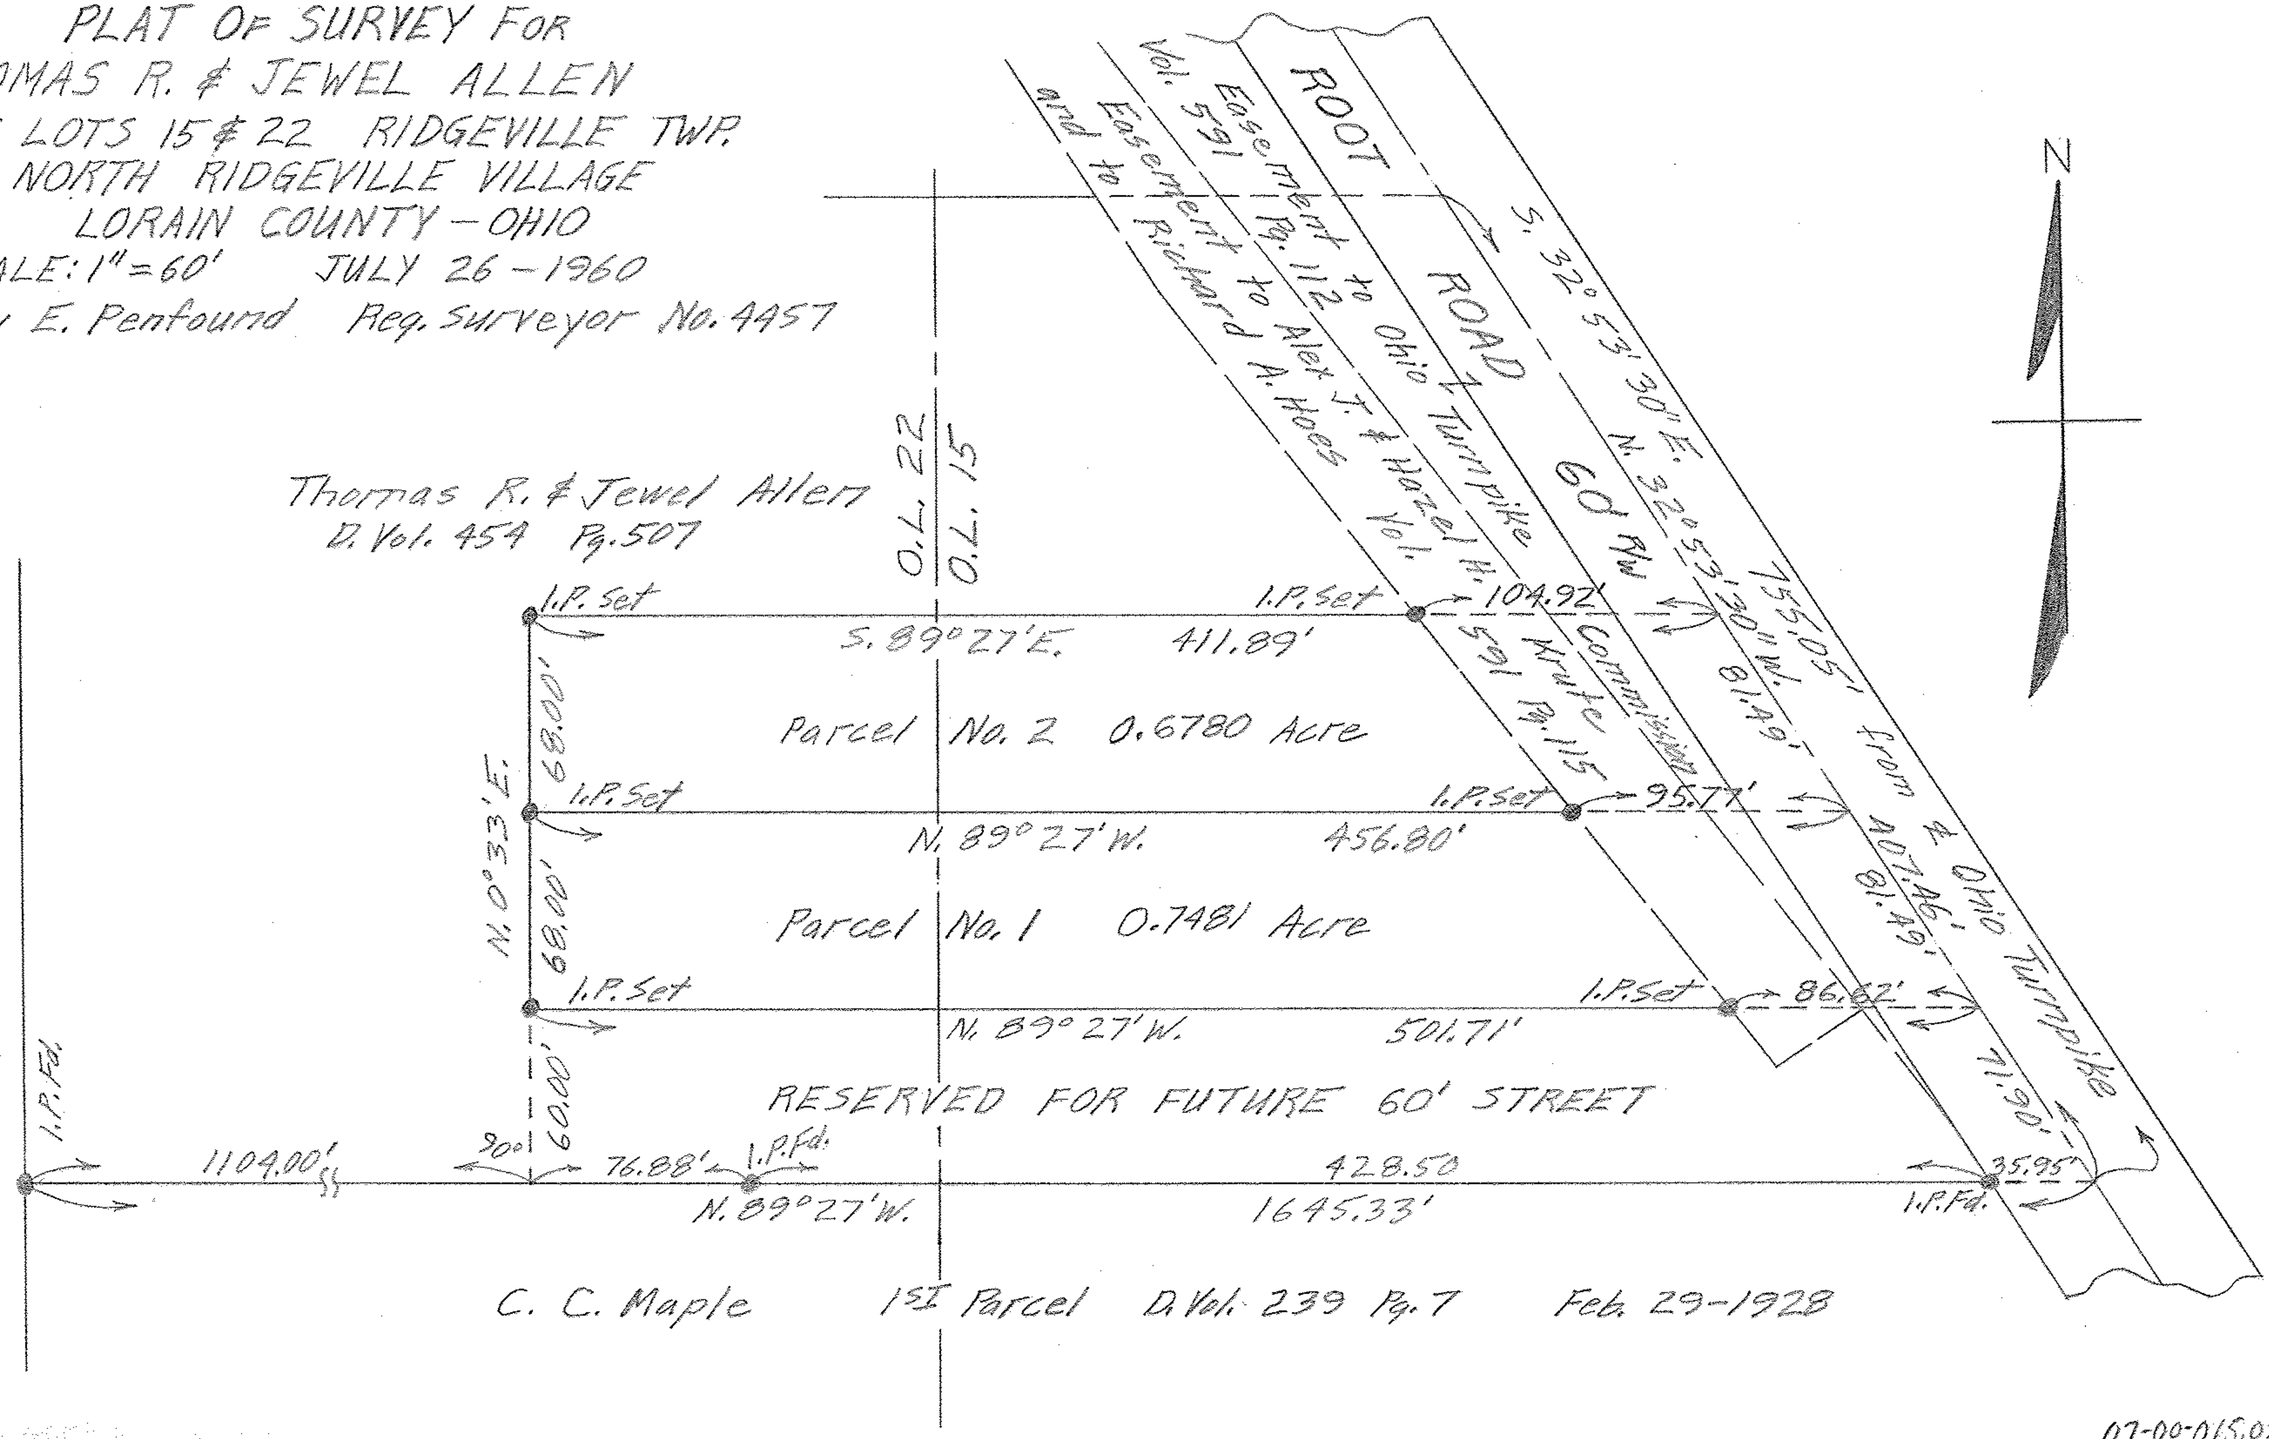

07-00-015.022