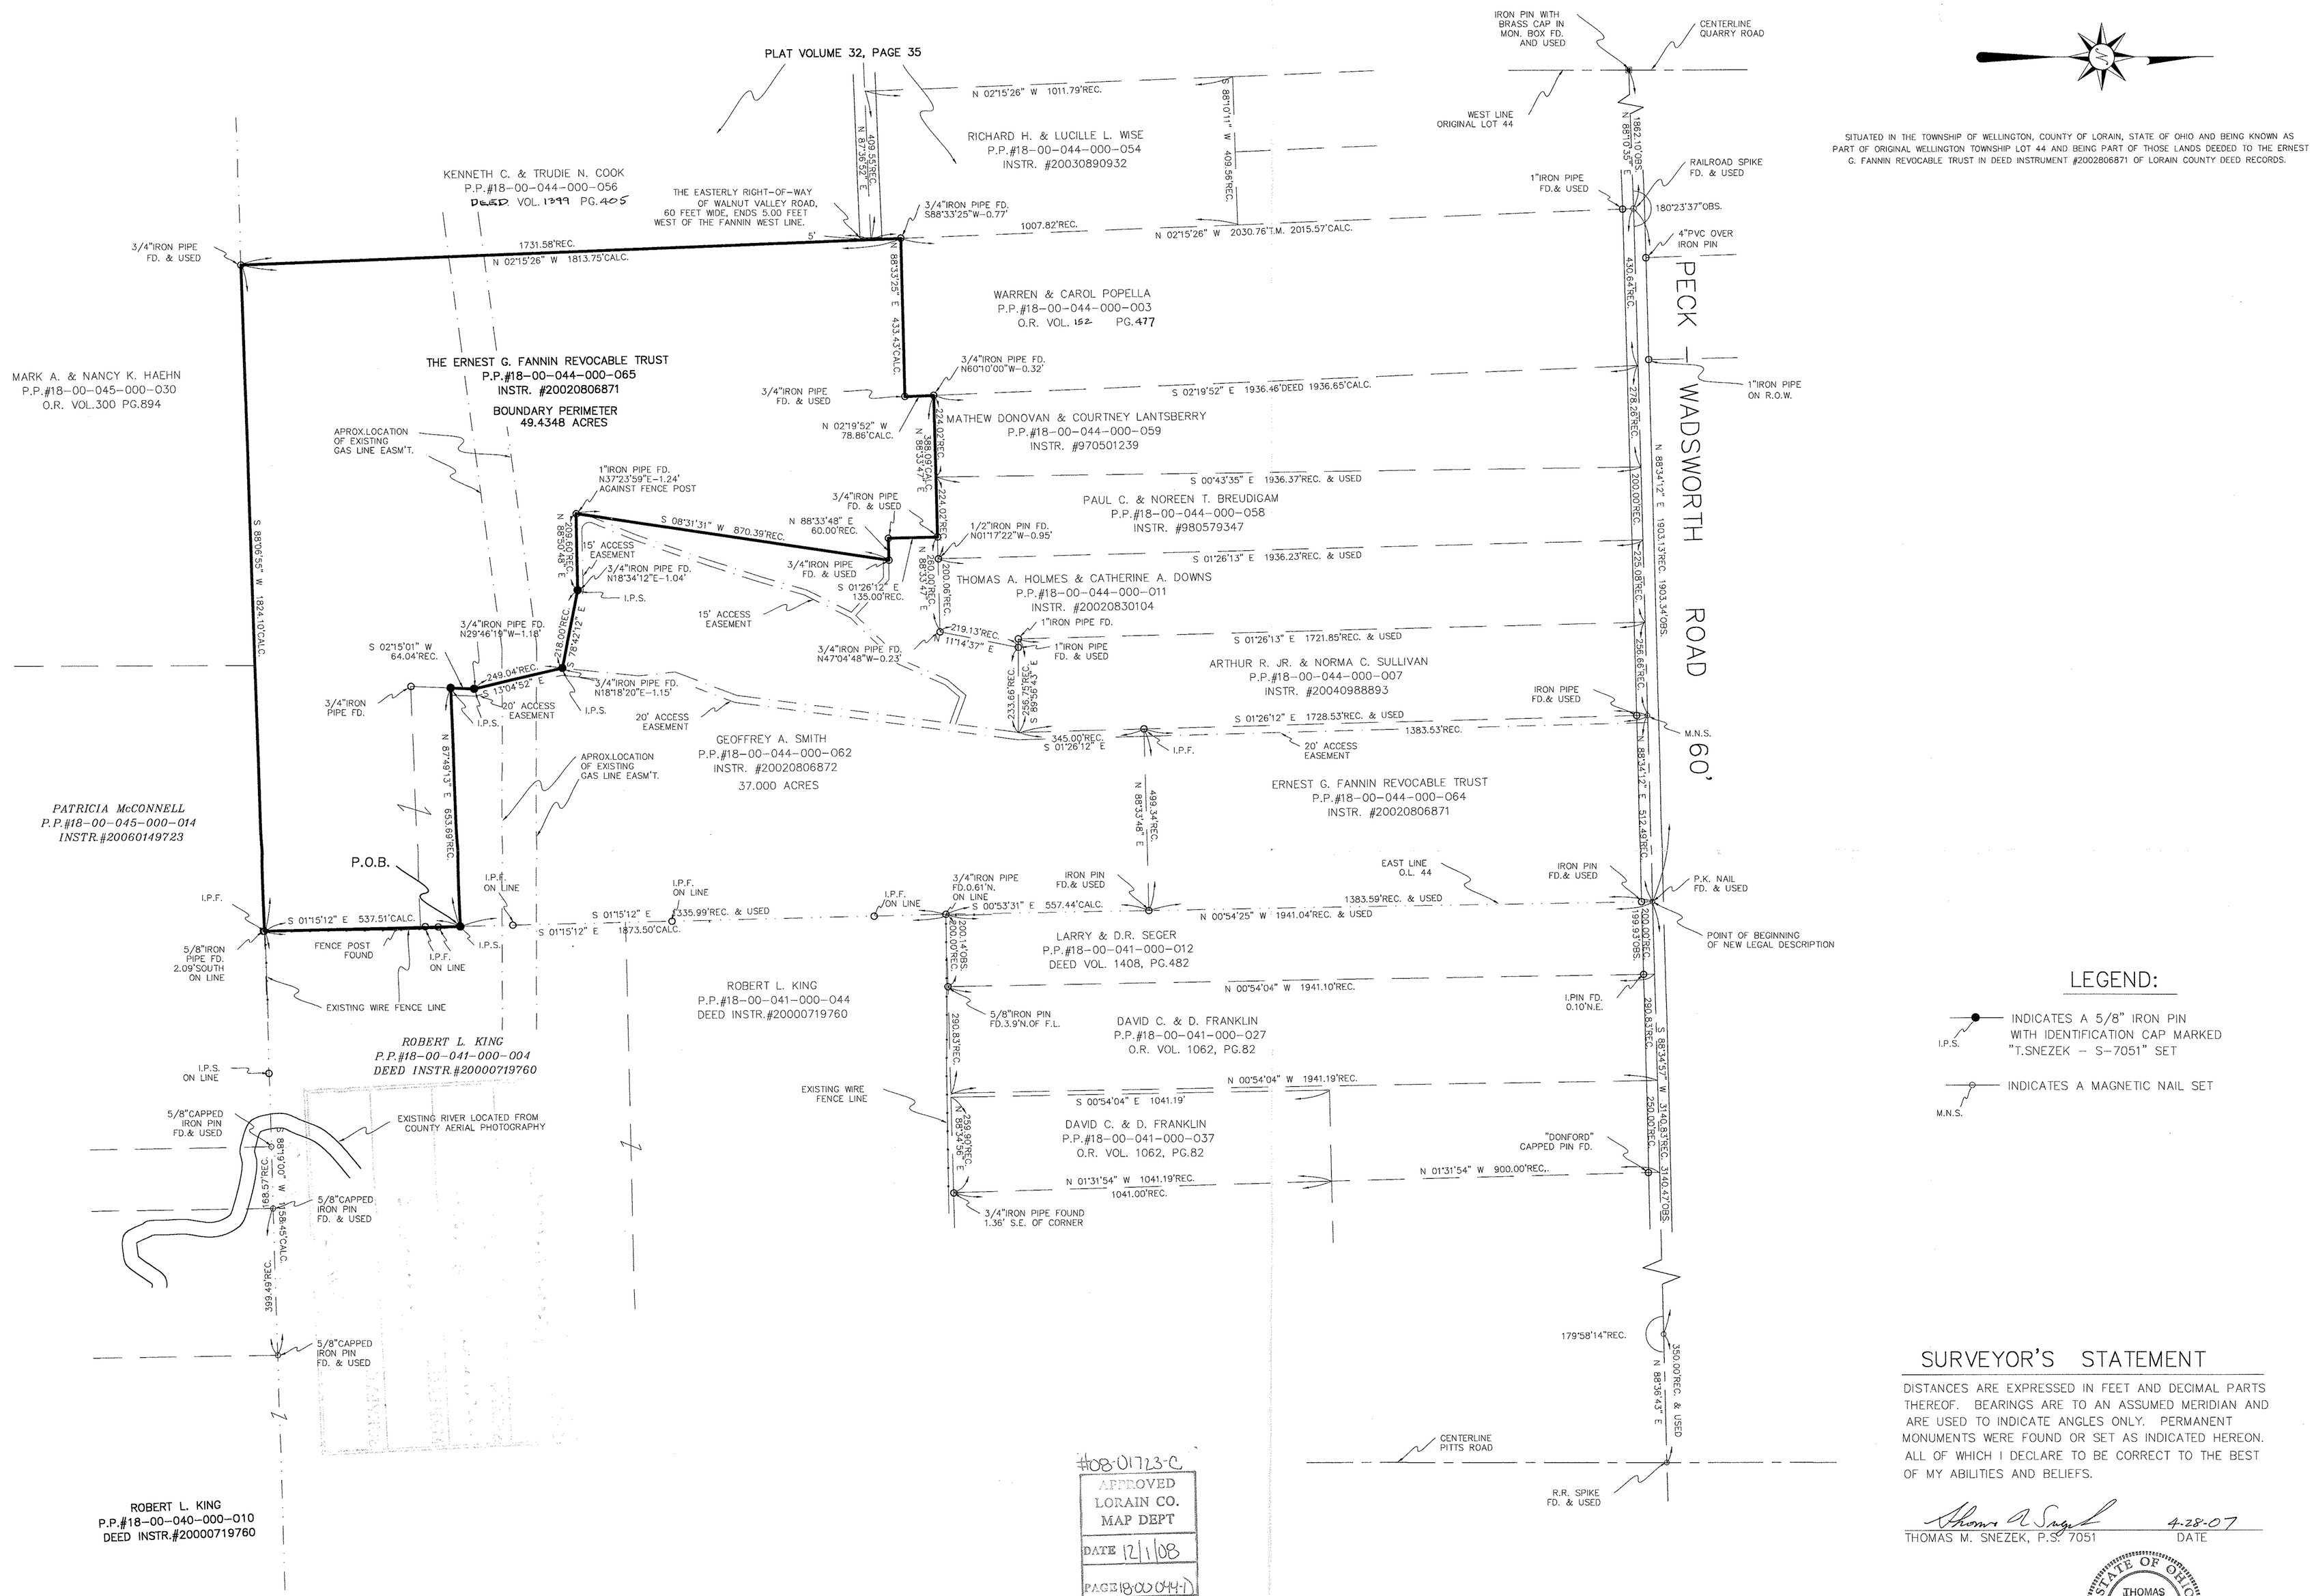

SURVEYOR'S STATEMENT

DISTANCES ARE EXPRESSED IN FEET AND DECIMAL PARTS THEREOF. BEARINGS ARE TO AN ASSUMED MERIDIAN AND ARE USED TO INDICATE ANGLES ONLY. PERMANENT MONUMENTS WERE FOUND OR SET AS INDICATED HEREON. ALL OF WHICH I DECLARE TO BE CORRECT TO THE BEST OF MY ABILITIES AND BELIEFS.

THOMAS M. SNEZEK, P.S. 7051 — DATE 4-25-07

STATE OF OHIO — THOMAS M. SNEZEK S-7051 — SURVEYOR

SCALE: 1" = 200'

PROJECT NO. #0613BFANNIN

MAP OF PERIMETER SURVEY

PREPARED FOR:

THE ERNEST G. FANNIN REVOCABLE TRUST

PREPARED BY:
SNEZEK & ASSOCIATES, L.L.C.
PROFESSIONAL SURVEYORS
CLEVELAND, OHIO 44111
DADSURV@HOTMAIL.COM
3496 COLLETTA LANE
(216) 671-4902
FAX (216)-941-2431

DRAWN T.SNEZEK | DATE 04-25-07 | SHEET 1 OF 1

REVISED: