PLAT OF SURVEY FOR 57.2966 AND 31.0722 ACRE PARCELS

PART OF ORIGINAL LOT NO. 10

EATON TOWNSHIP, LORAIN COUNTY, OHIO

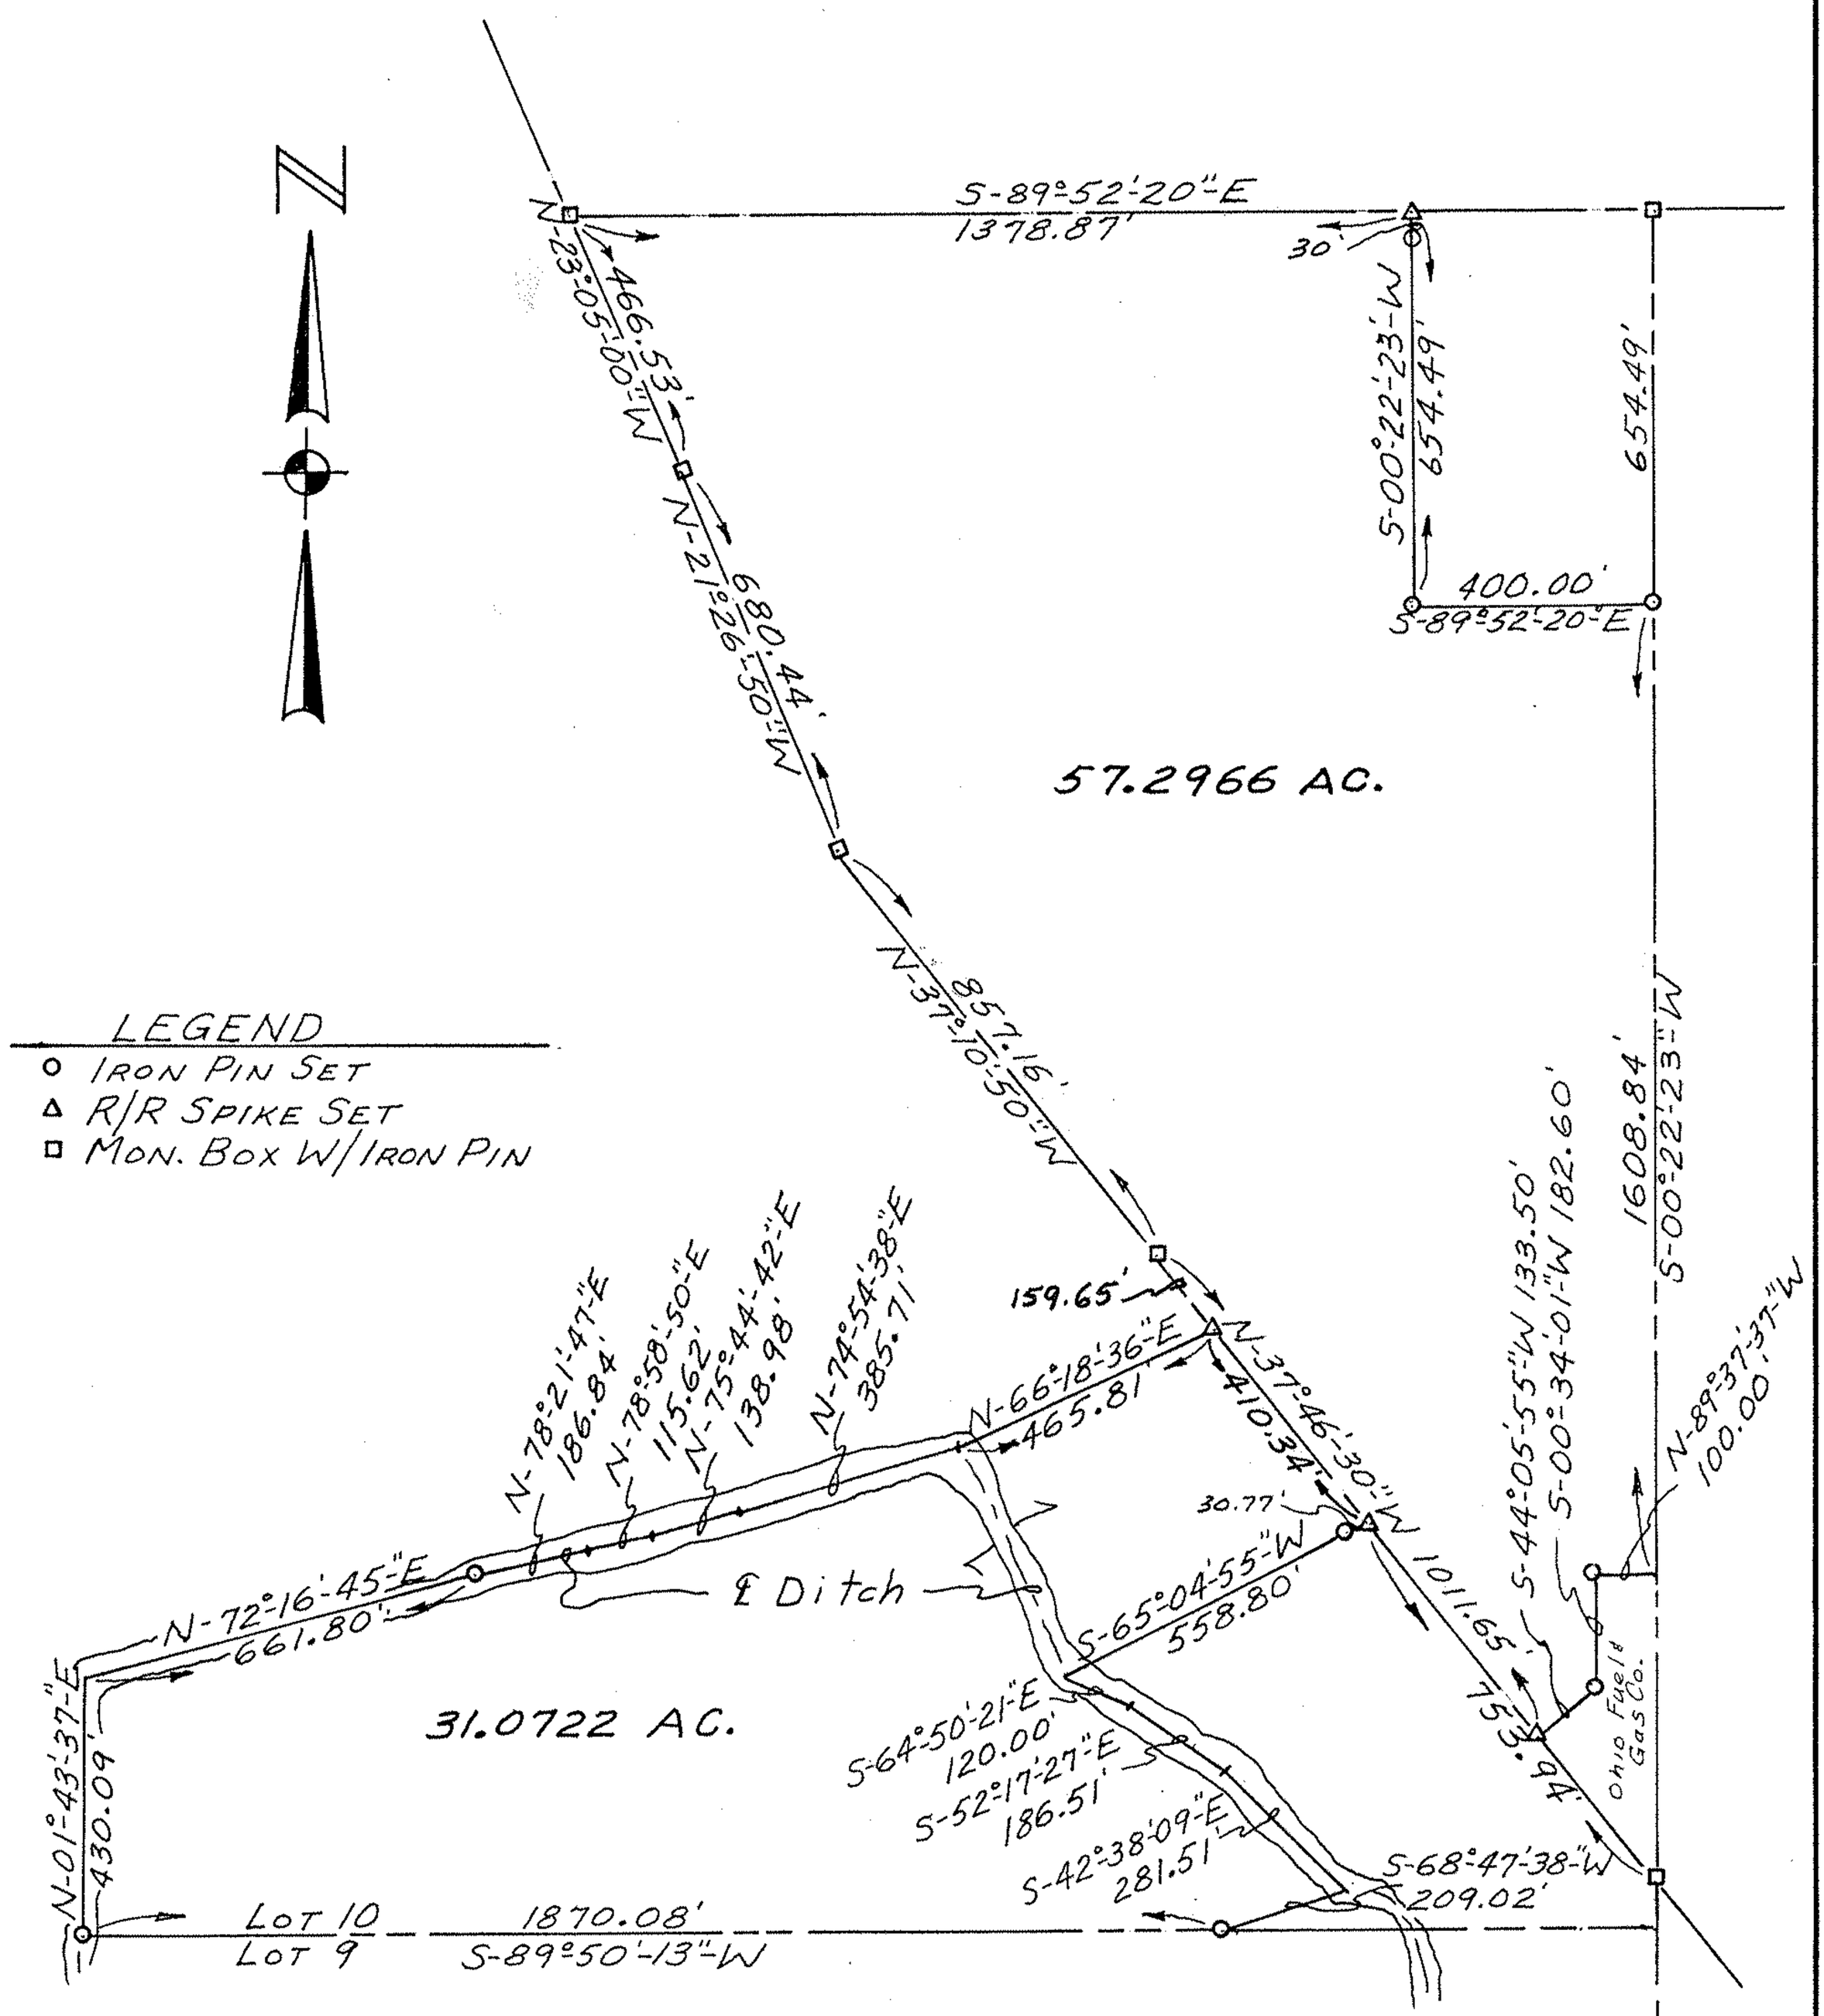

All bearings are magnetic and are to be used for the determination of angles only.

William L. Fox

William L. Fox, P.S.
Reg. Surveyor No. 5878

STATE OF OHIO
WILLIAM L. FOX
5878
REGISTERED
PROFESSIONAL SURVEYOR

Scale In Feet

Job No. 108533 Nov. 1, 1985

11-00-010