PLAT OF REVISED SURVEYS FOR BILL GARRETT BUILDERS

ORIGINAL LOT NO. 20 – EATON TOWNSHIP
LORAIN COUNTY OHIO
SCALE: 1" = 100' JULY & DECEMBER – 1976
Gary E. Pen found Reg. Surveyor No. 4457

REVISED DIVISION OF 18.9976 ACRES

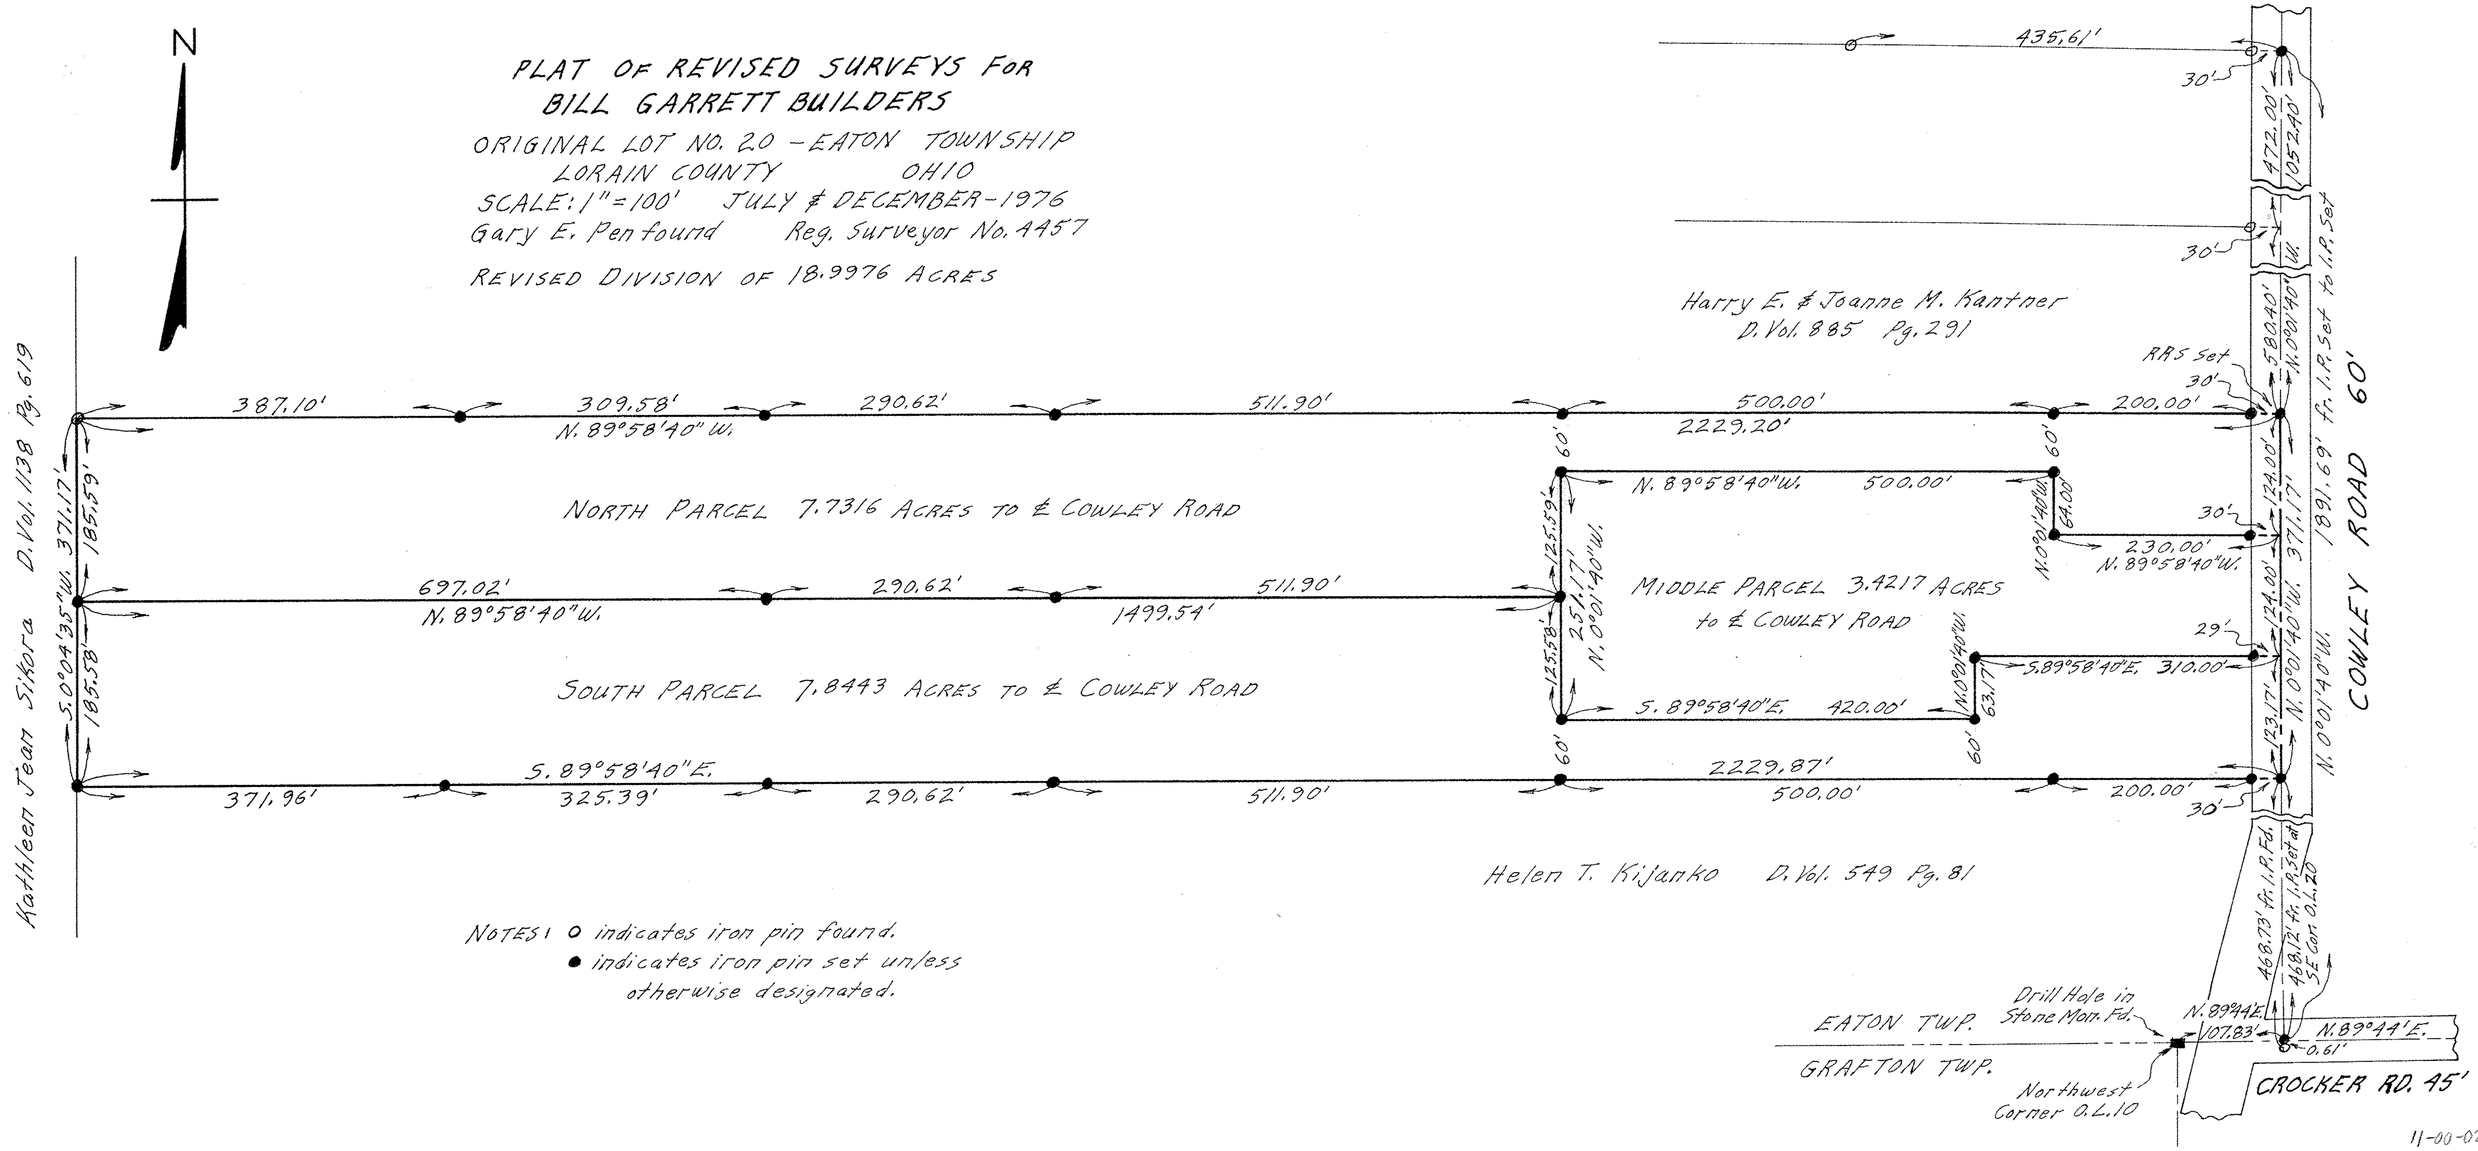

NOTES: ○ indicates iron pin found.
● indicates iron pin set unless otherwise designated.

11-00-020