PLAT OF SURVEYING FOR
29603 LORAIN, INC. (SIMMONS HOMES)

ORIGINAL LOT NO. 27 – EATON TOWNSHIP
LORAIN COUNTY OHIO
SCALE: 1" = 100' APRIL – 1978
Gary E. Penfound Reg. Surveyor No. 4457

REVISED JULY 25-1978 FOR LOTS NO'S. 1 AND 2
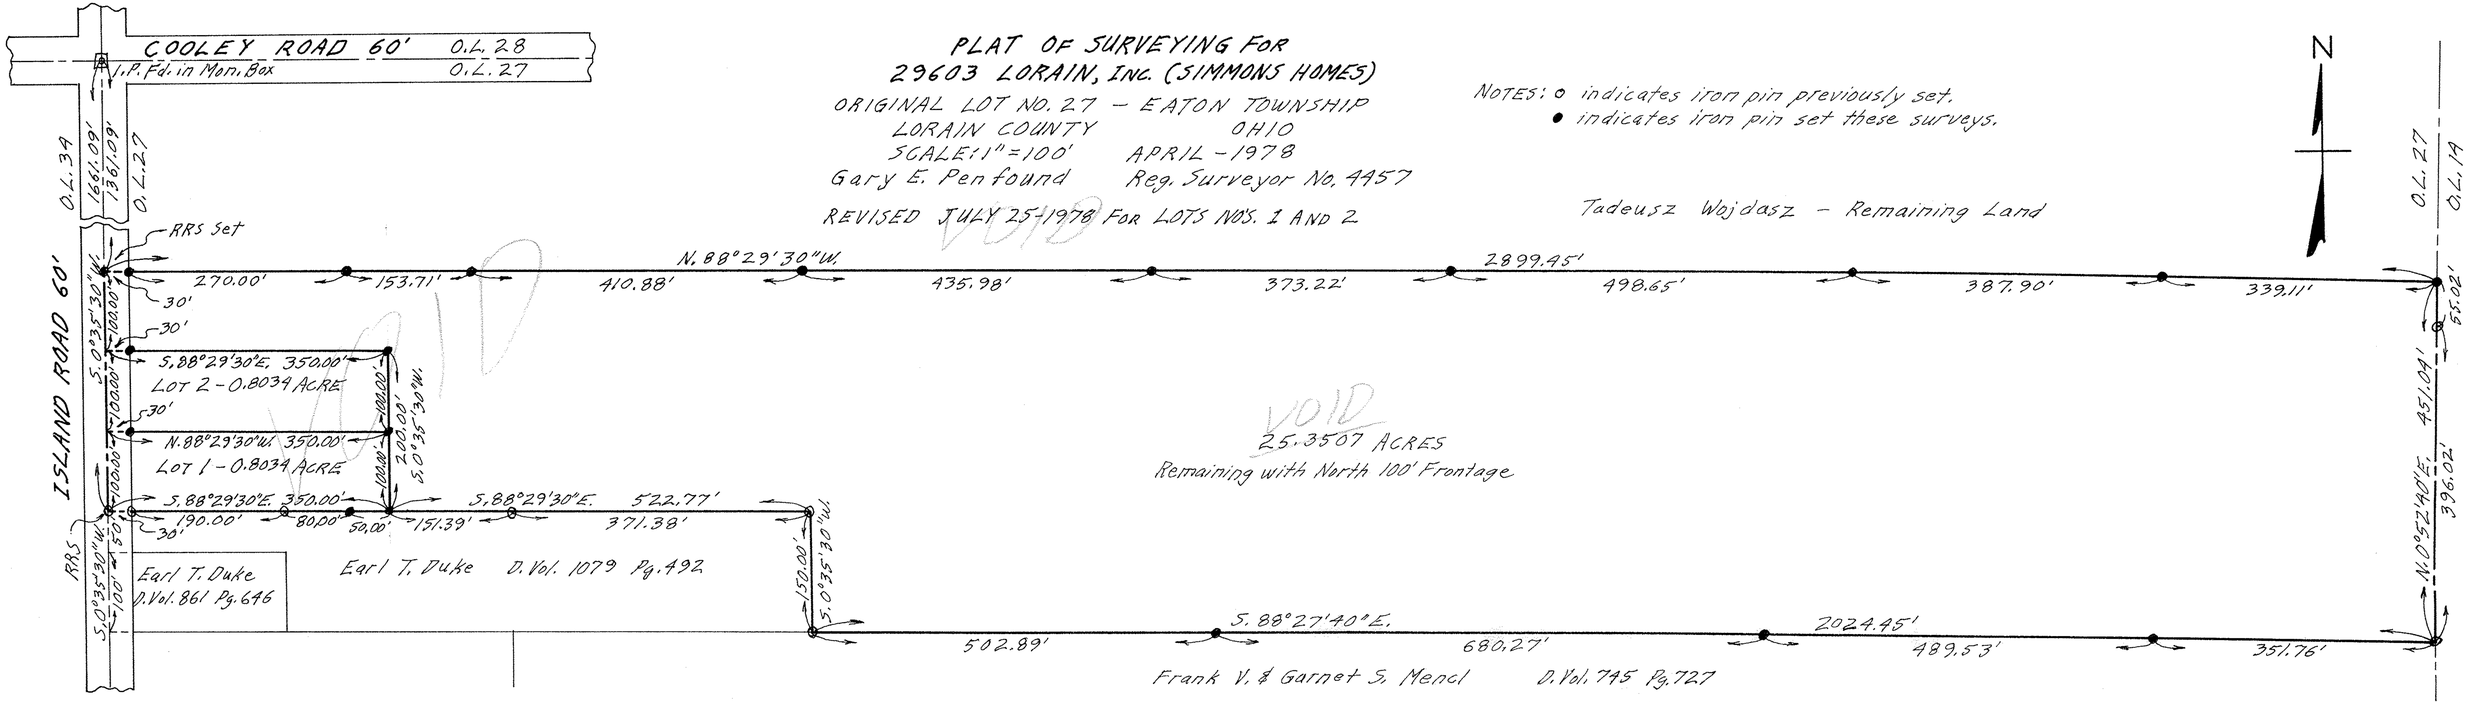
NOTES: ○ indicates iron pin previously set.
● indicates iron pin set these surveys.