PLAT OF SURVEYS FOR
RICHARD A. BROOKS AND
FOR WILLIAM BROOKS

ORIGINAL LOT 100 - RUSSIA TWP.
LORAIN COUNTY - OHIO
SCALE: 1" = 60' MAY 1975
Gary E. Penfound Reg. Surveyor No. 4457

4.6798 ACRES DIVIDED SEPT. 22-1976 FOR
FRED R. & HELEN PRICE

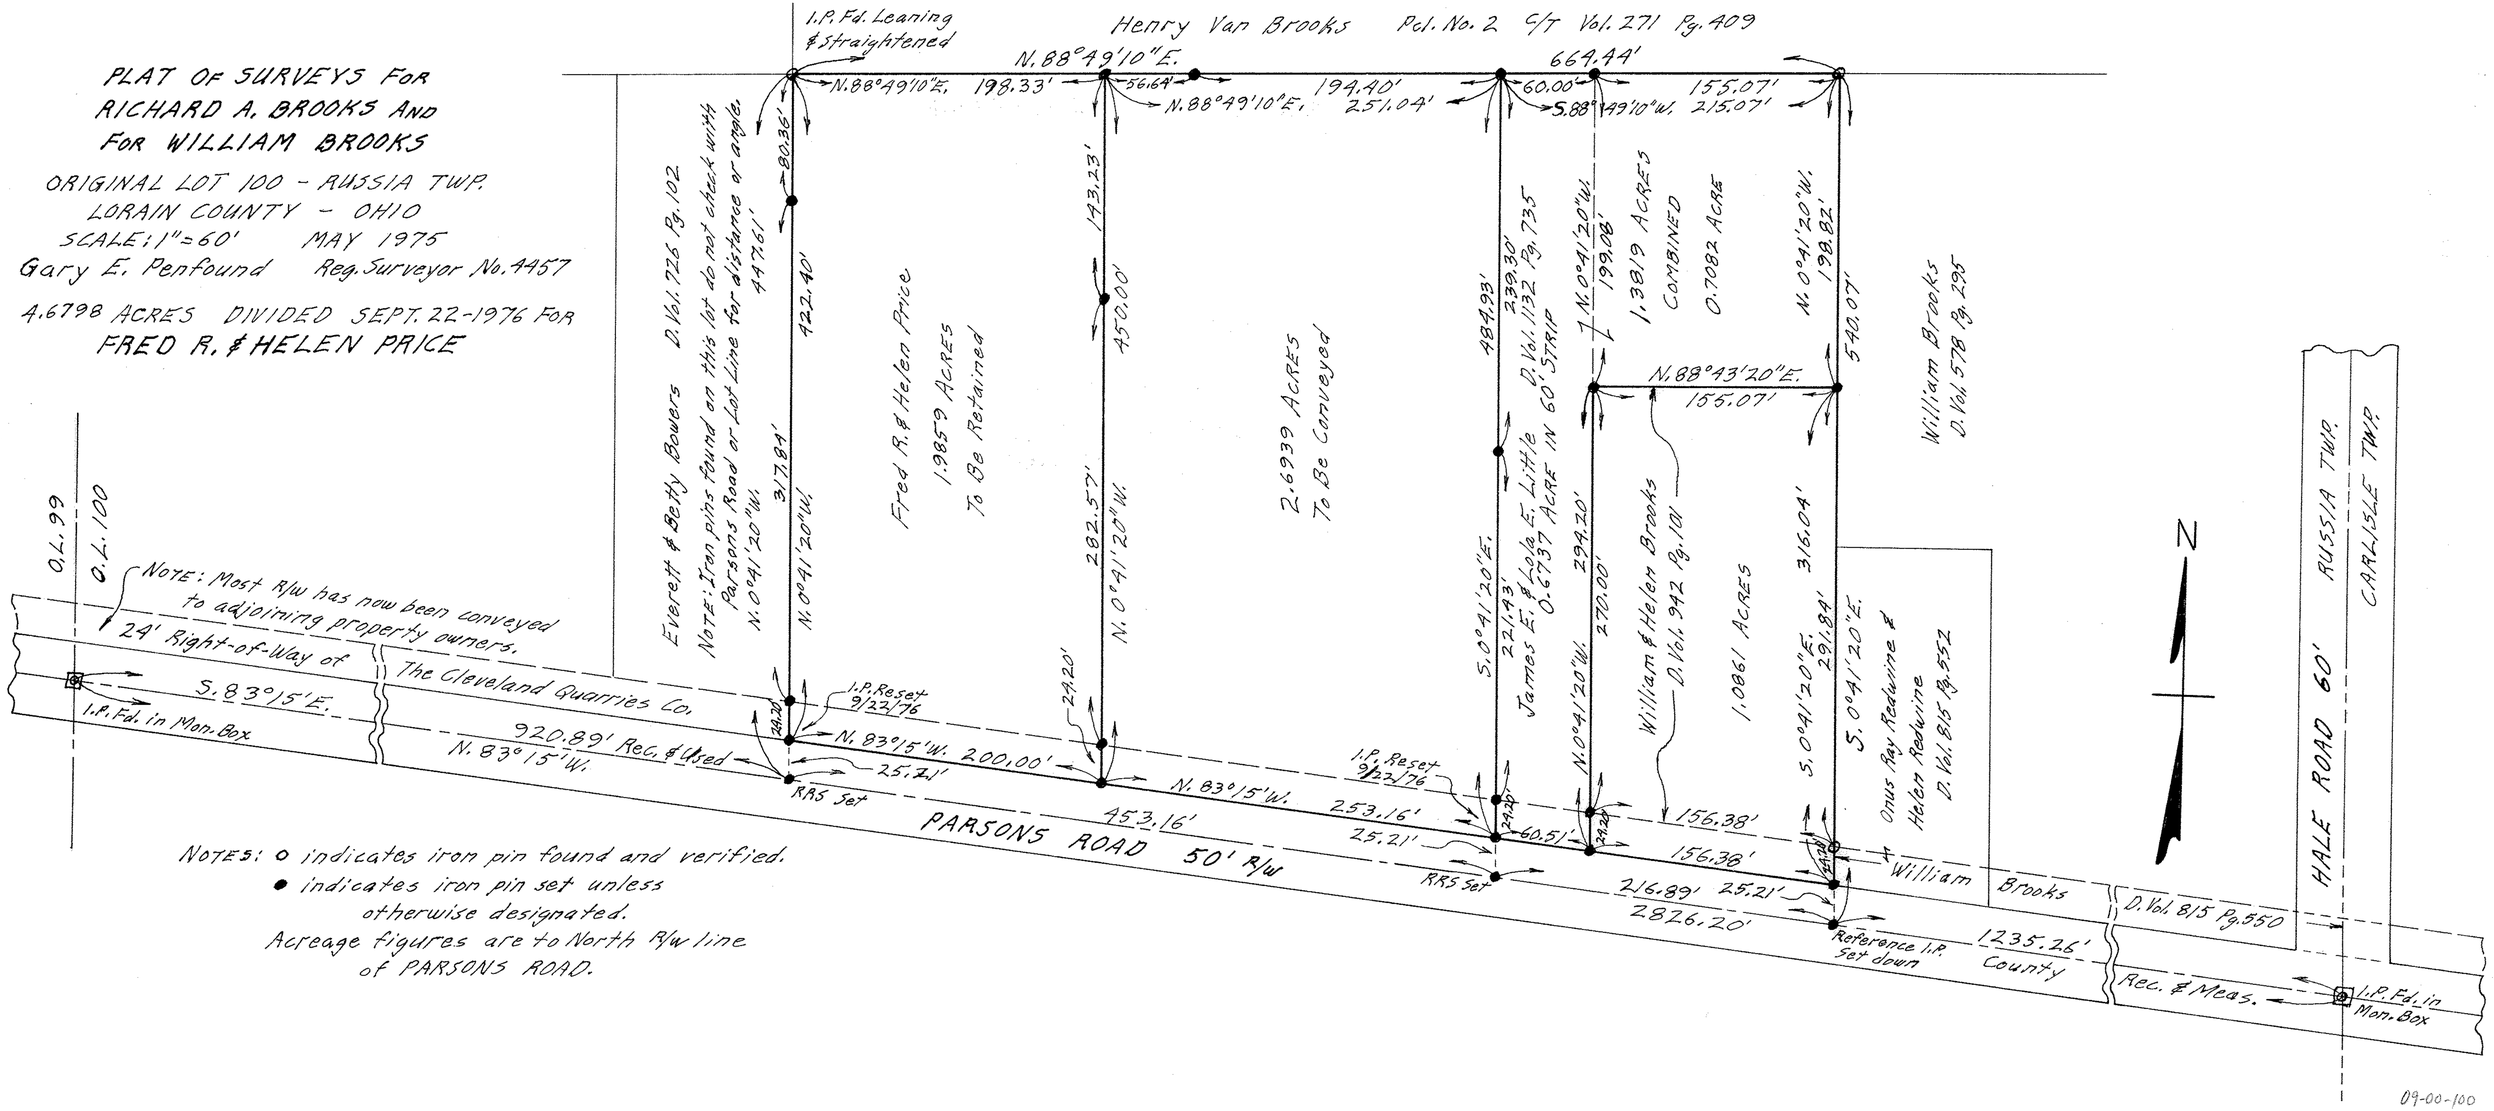

NOTES: ○ indicates iron pin found and verified.
● indicates iron pin set unless otherwise designated.
Acreage figures are to North R/W line of PARSONS ROAD.

09-00-100