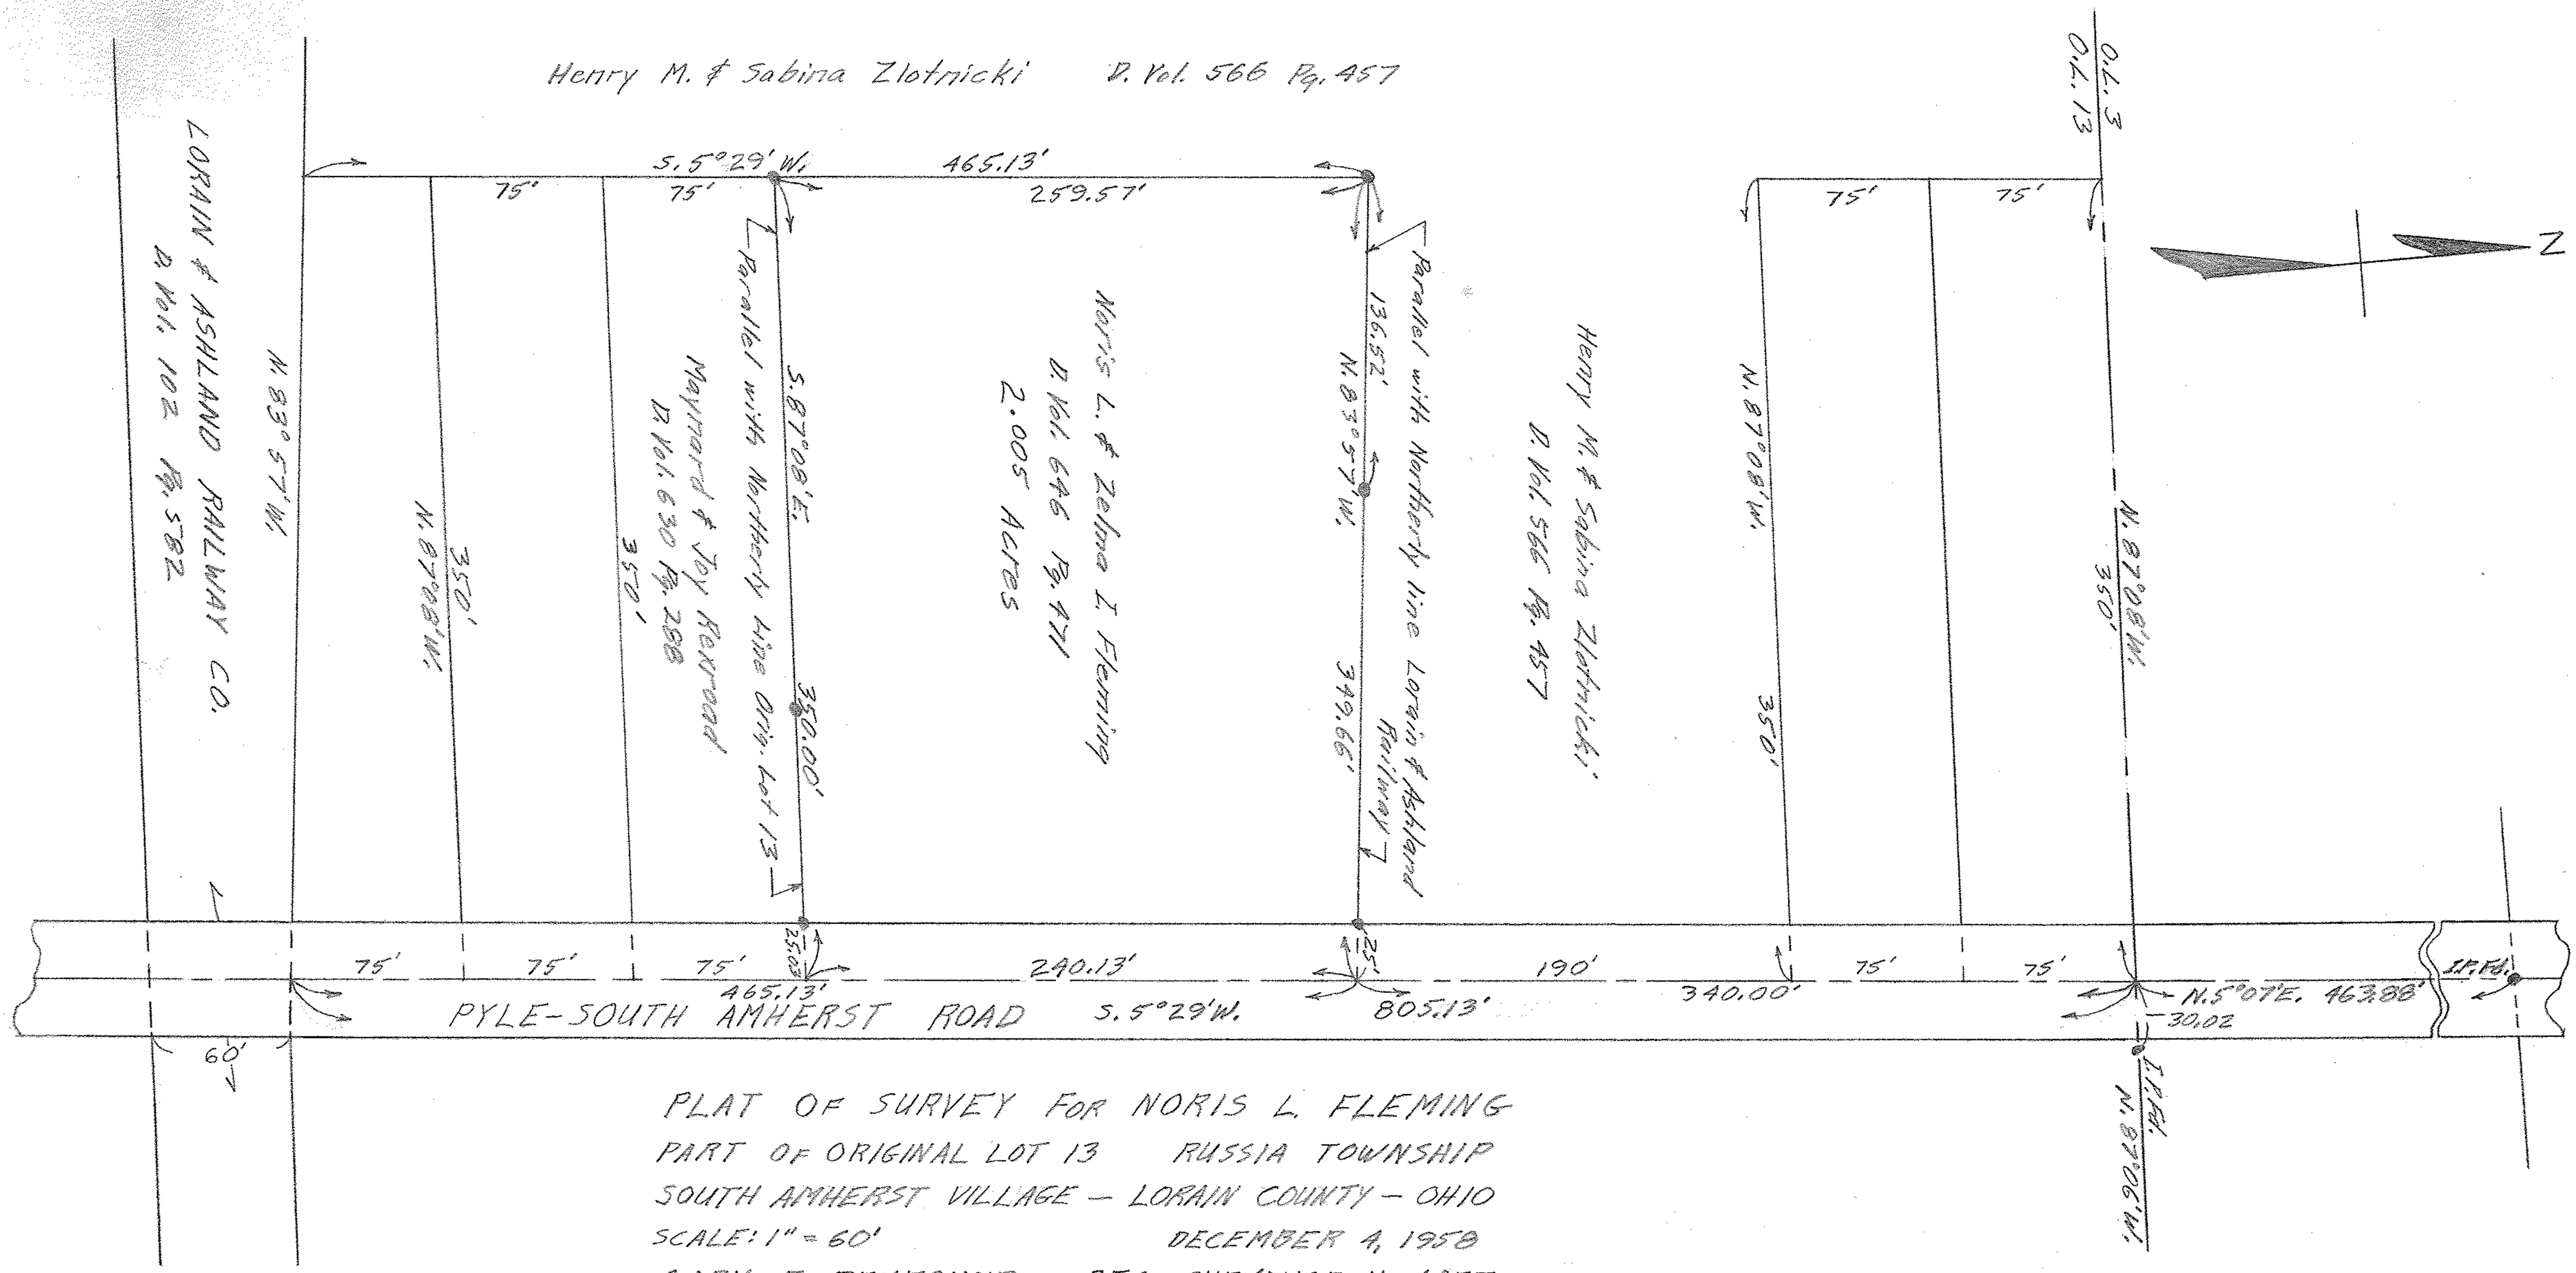

PLAT OF SURVEY FOR NORIS L. FLEMING
PART OF ORIGINAL LOT 13 RUSSIA TOWNSHIP
SOUTH AMHERST VILLAGE — LORAIN COUNTY — OHIO
SCALE: 1" = 60' DECEMBER 4, 1958
GARY E. PENFOUND REG. SURVEYOR No. 4457

NOTE: ● indicates iron pin found or set.

09-00-013