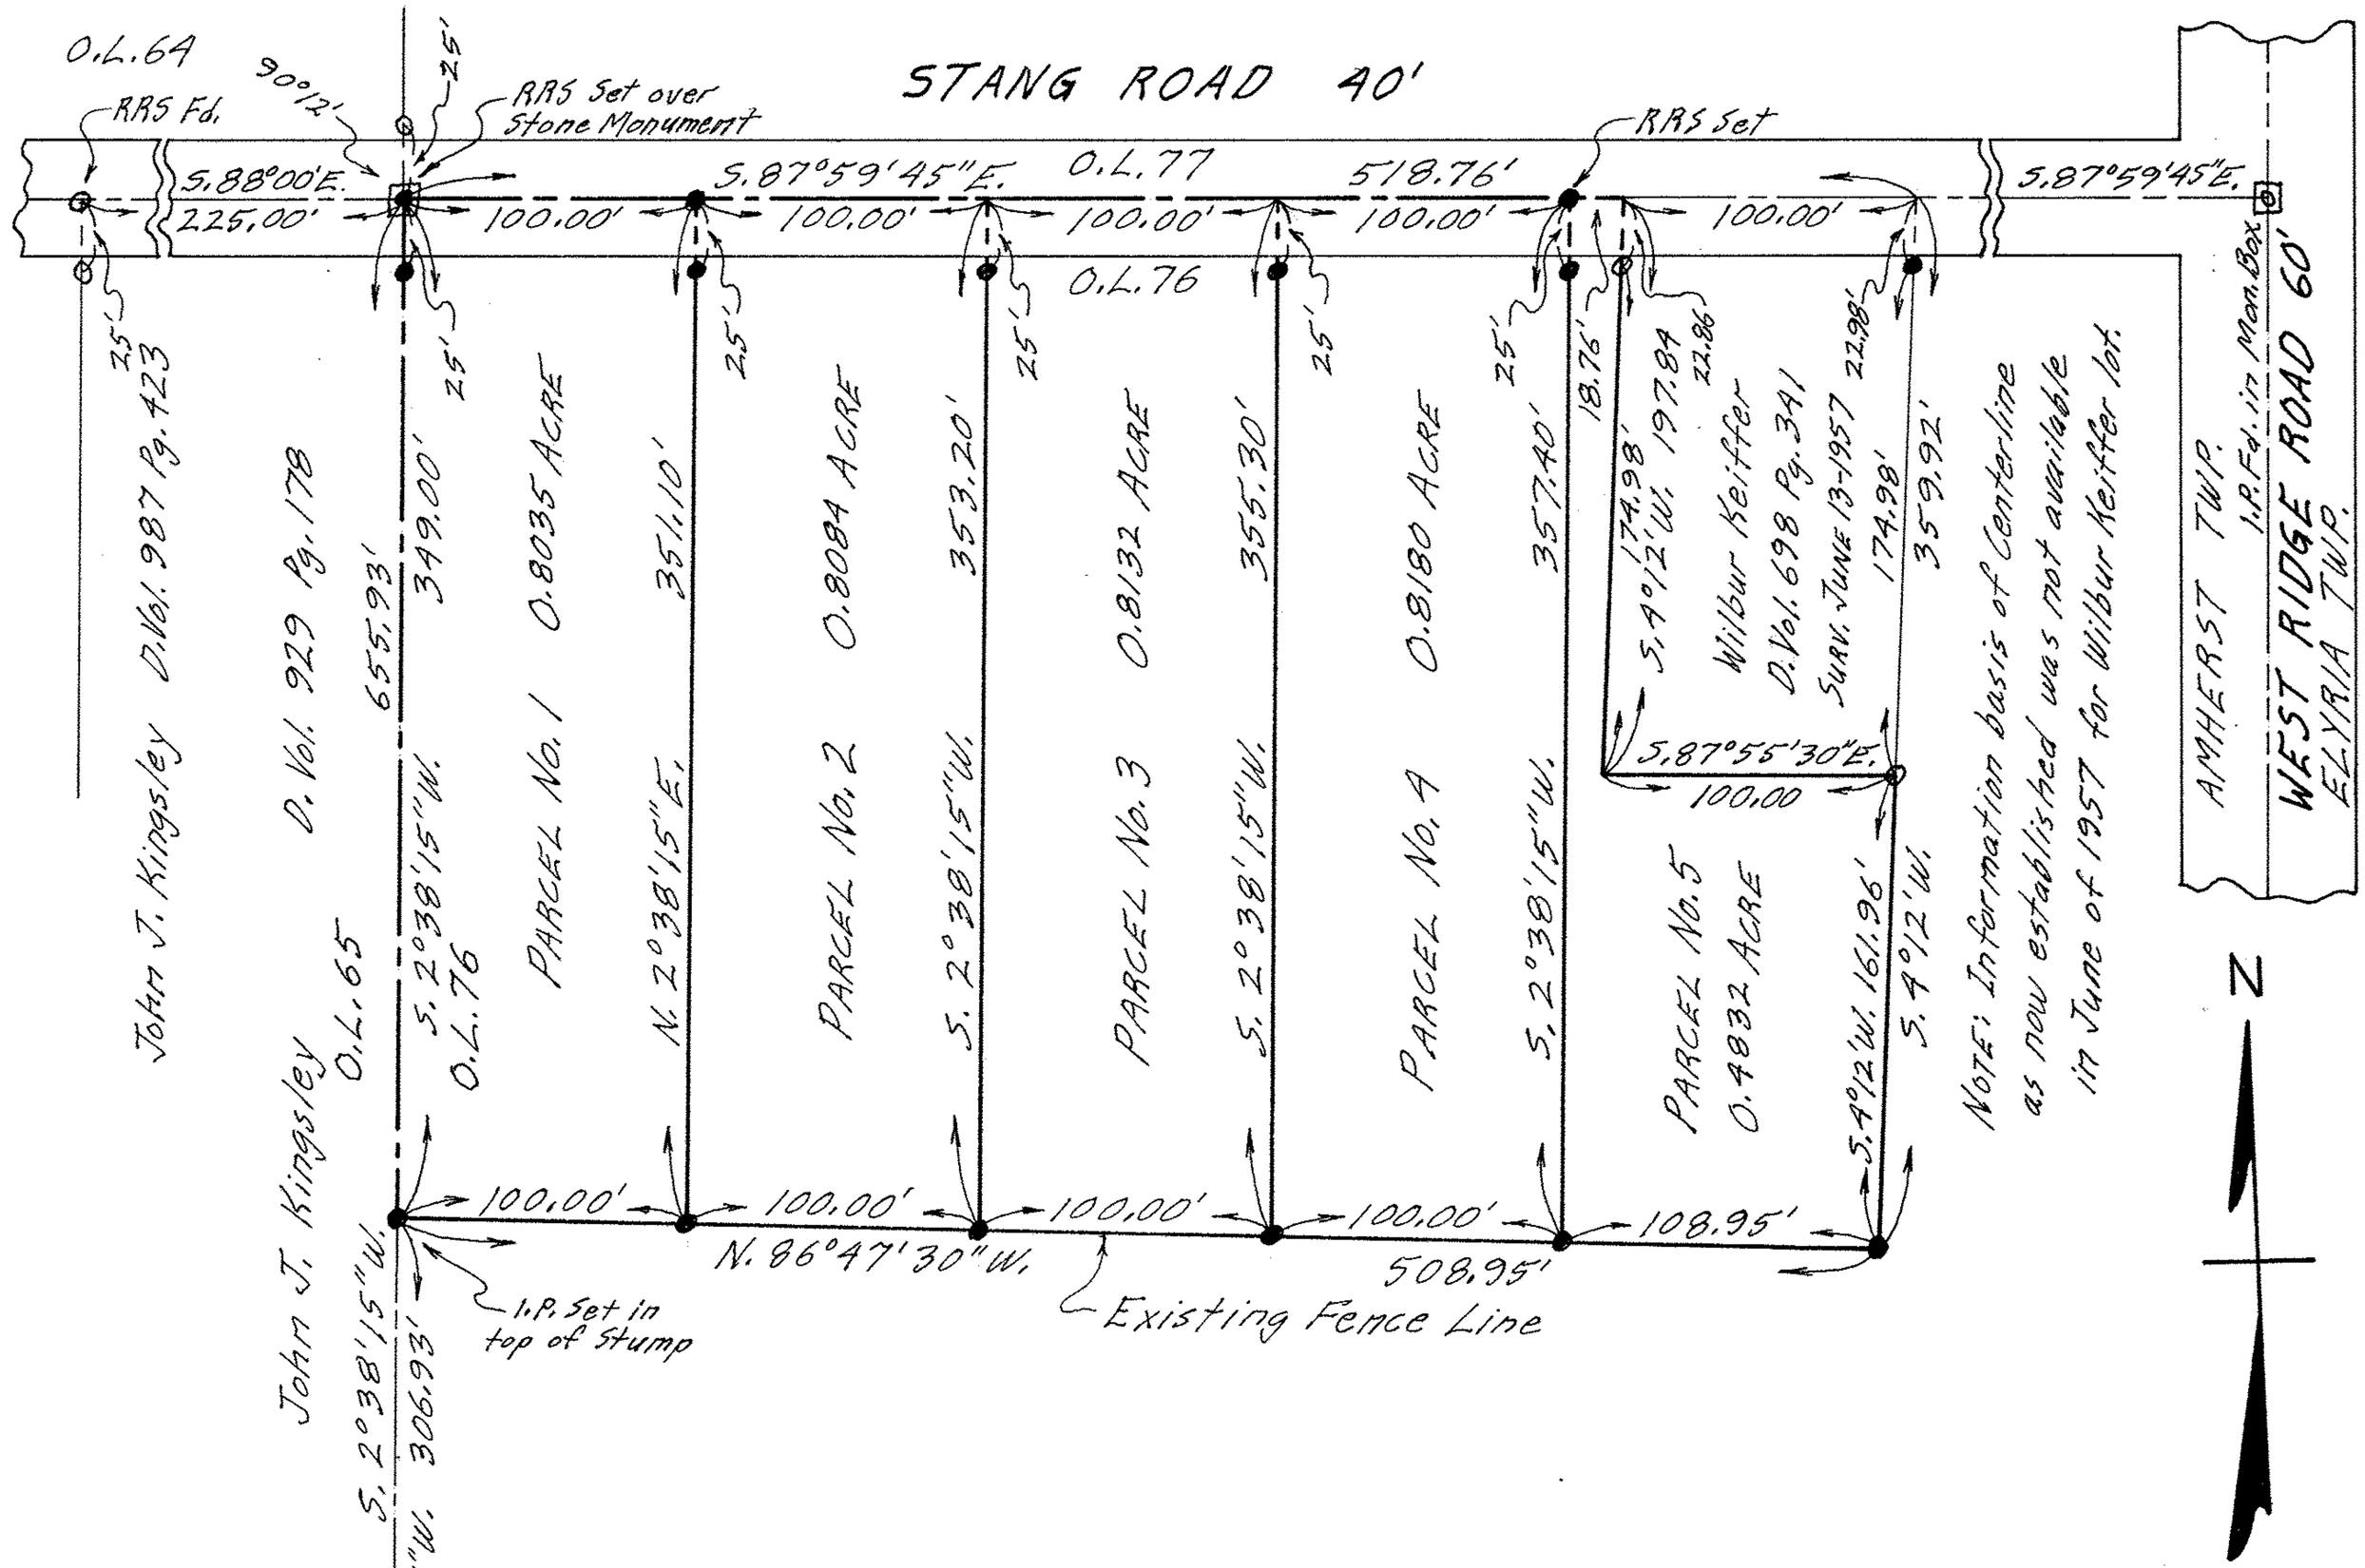

PLAT OF SURVEYS FOR VICTOR & VICTORIA KEIFFER

ORIGINAL LOT 76 AMHERST TWP.
LORAIN COUNTY OHIO
SCALE: 1" = 60' JUNE-1975
Gary E. Penfound Reg. Surveyor No. 4457

NOTES: o indicates iron pin found unless otherwise designated.
● indicates iron pin set unless otherwise designated.

05-00-076