PLAT OF SURVEYS FOR NEWTON G. WHITMORE

ORIGINAL LOTS NOS. 23 & 26 – BROWNHELM TWP.
LORAIN COUNTY OHIO
SCALE: 1" = 100' APRIL-JULY 1971
Gary E. Penfound Reg. Surveyor No. 4457

NOTES: ○ indicates iron pin found from previous survey.
● indicates iron pin set unless otherwise designated.

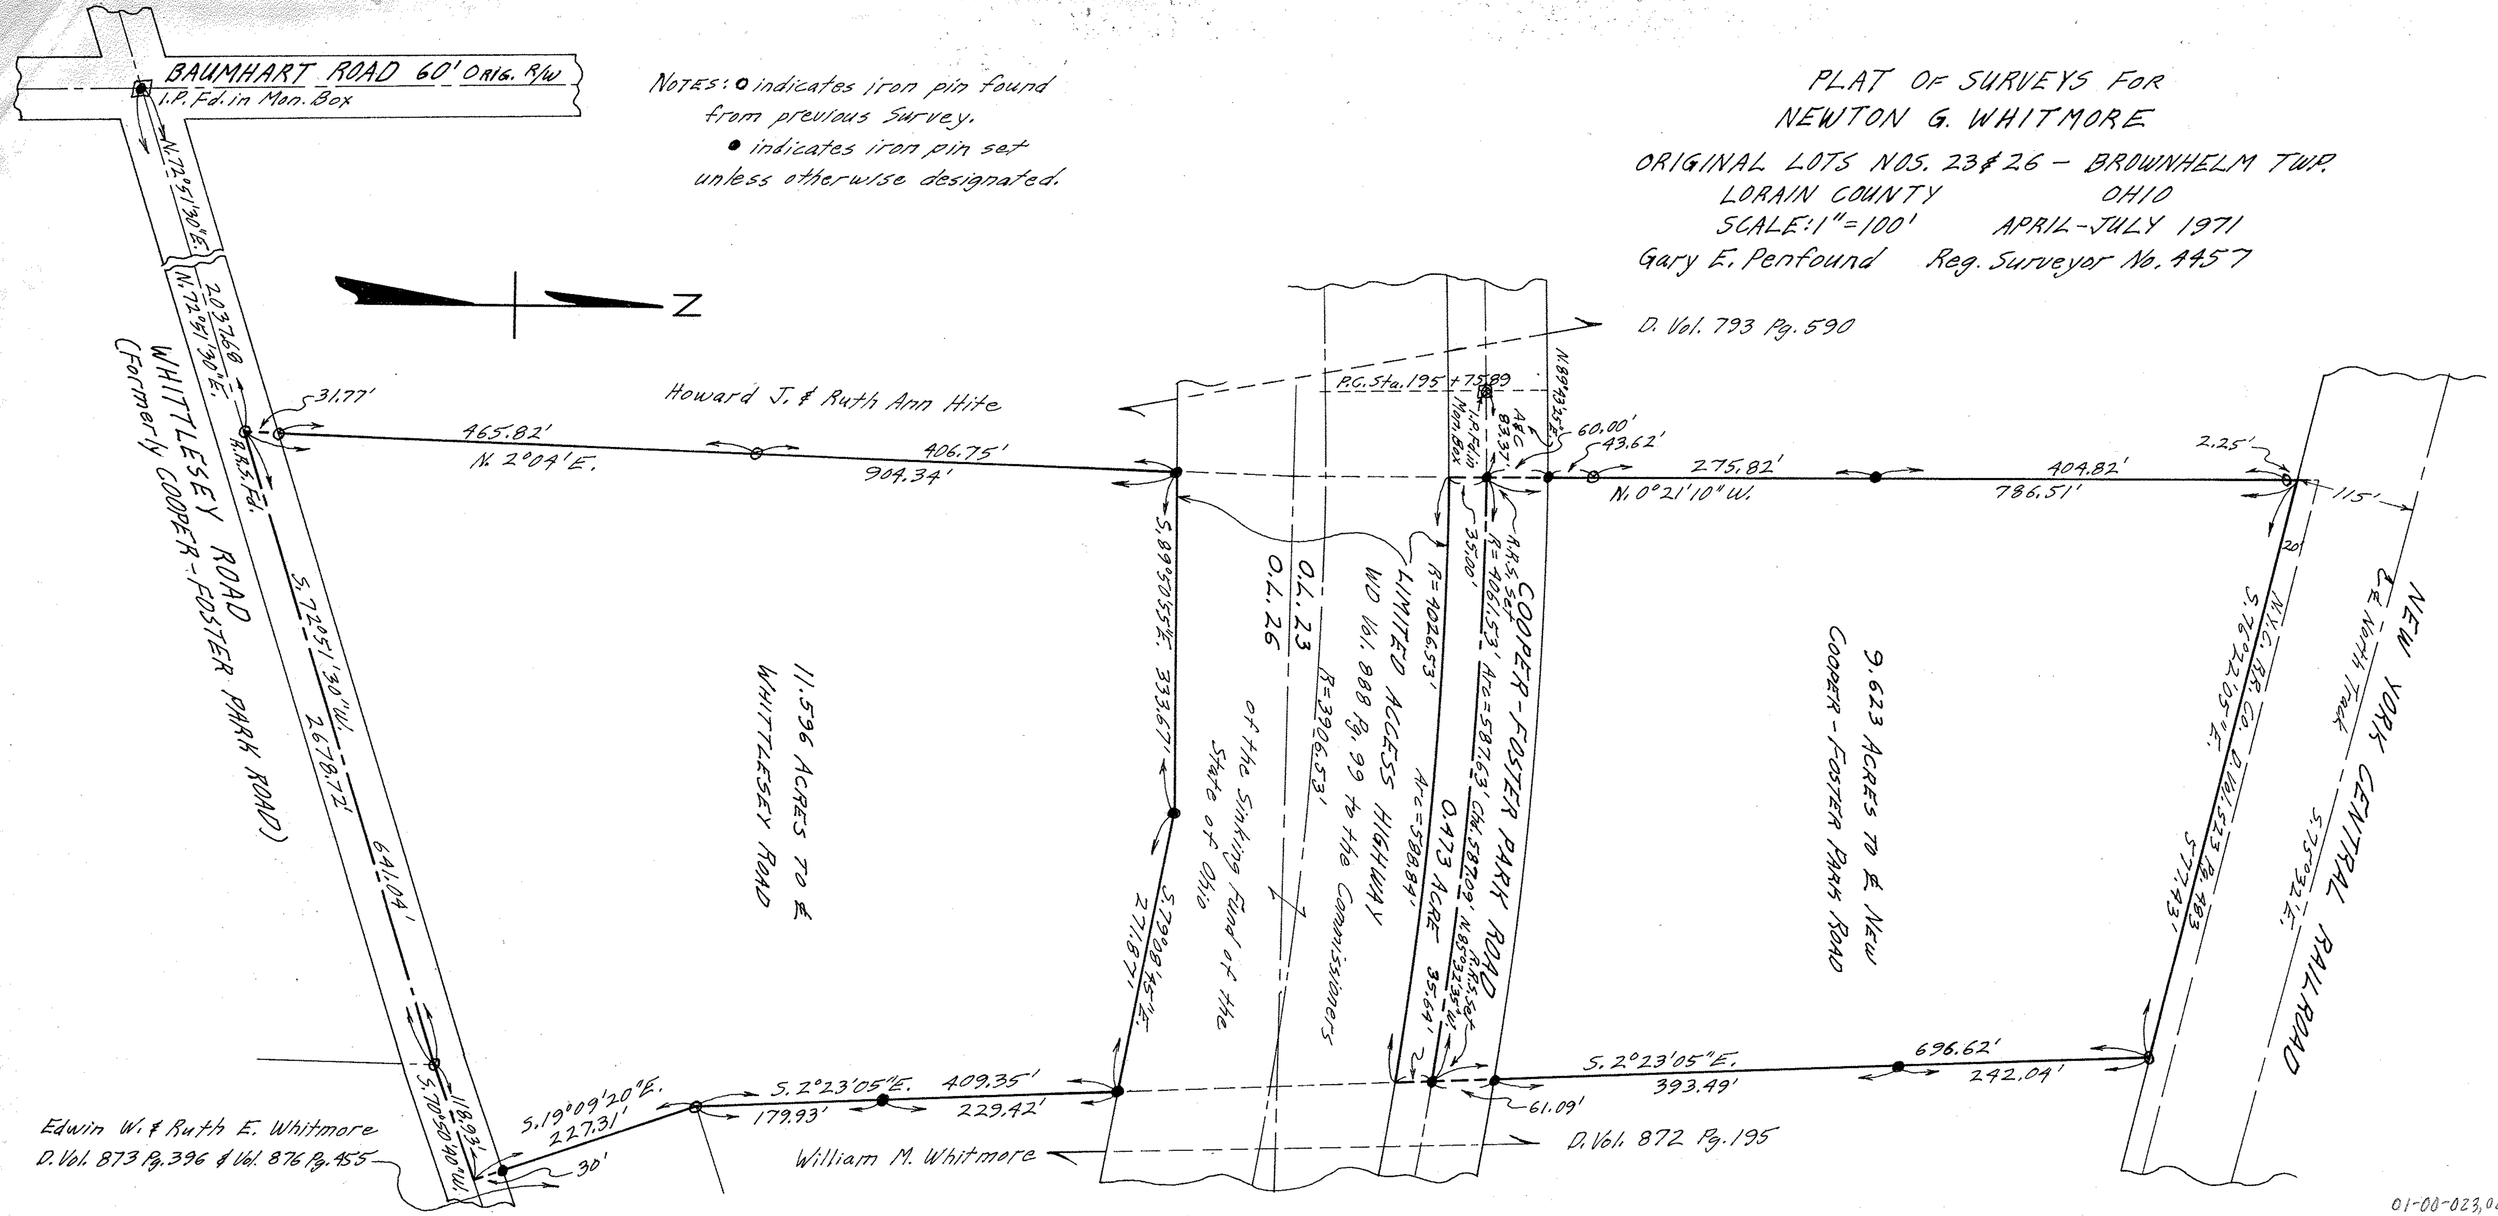

01-00-023,026