PLAT OF SURVEY FOR JACK CUSICK AND ERNIE KOVACS

ORIGINAL LOT 12 - TRACT NO. 12
HENRIETTA TOWNSHIP
LORAIN COUNTY OHIO
SCALE: 1"=60' APRIL-MAY 1973

Gary E. Penfound
Reg. Surveyor No. 4457
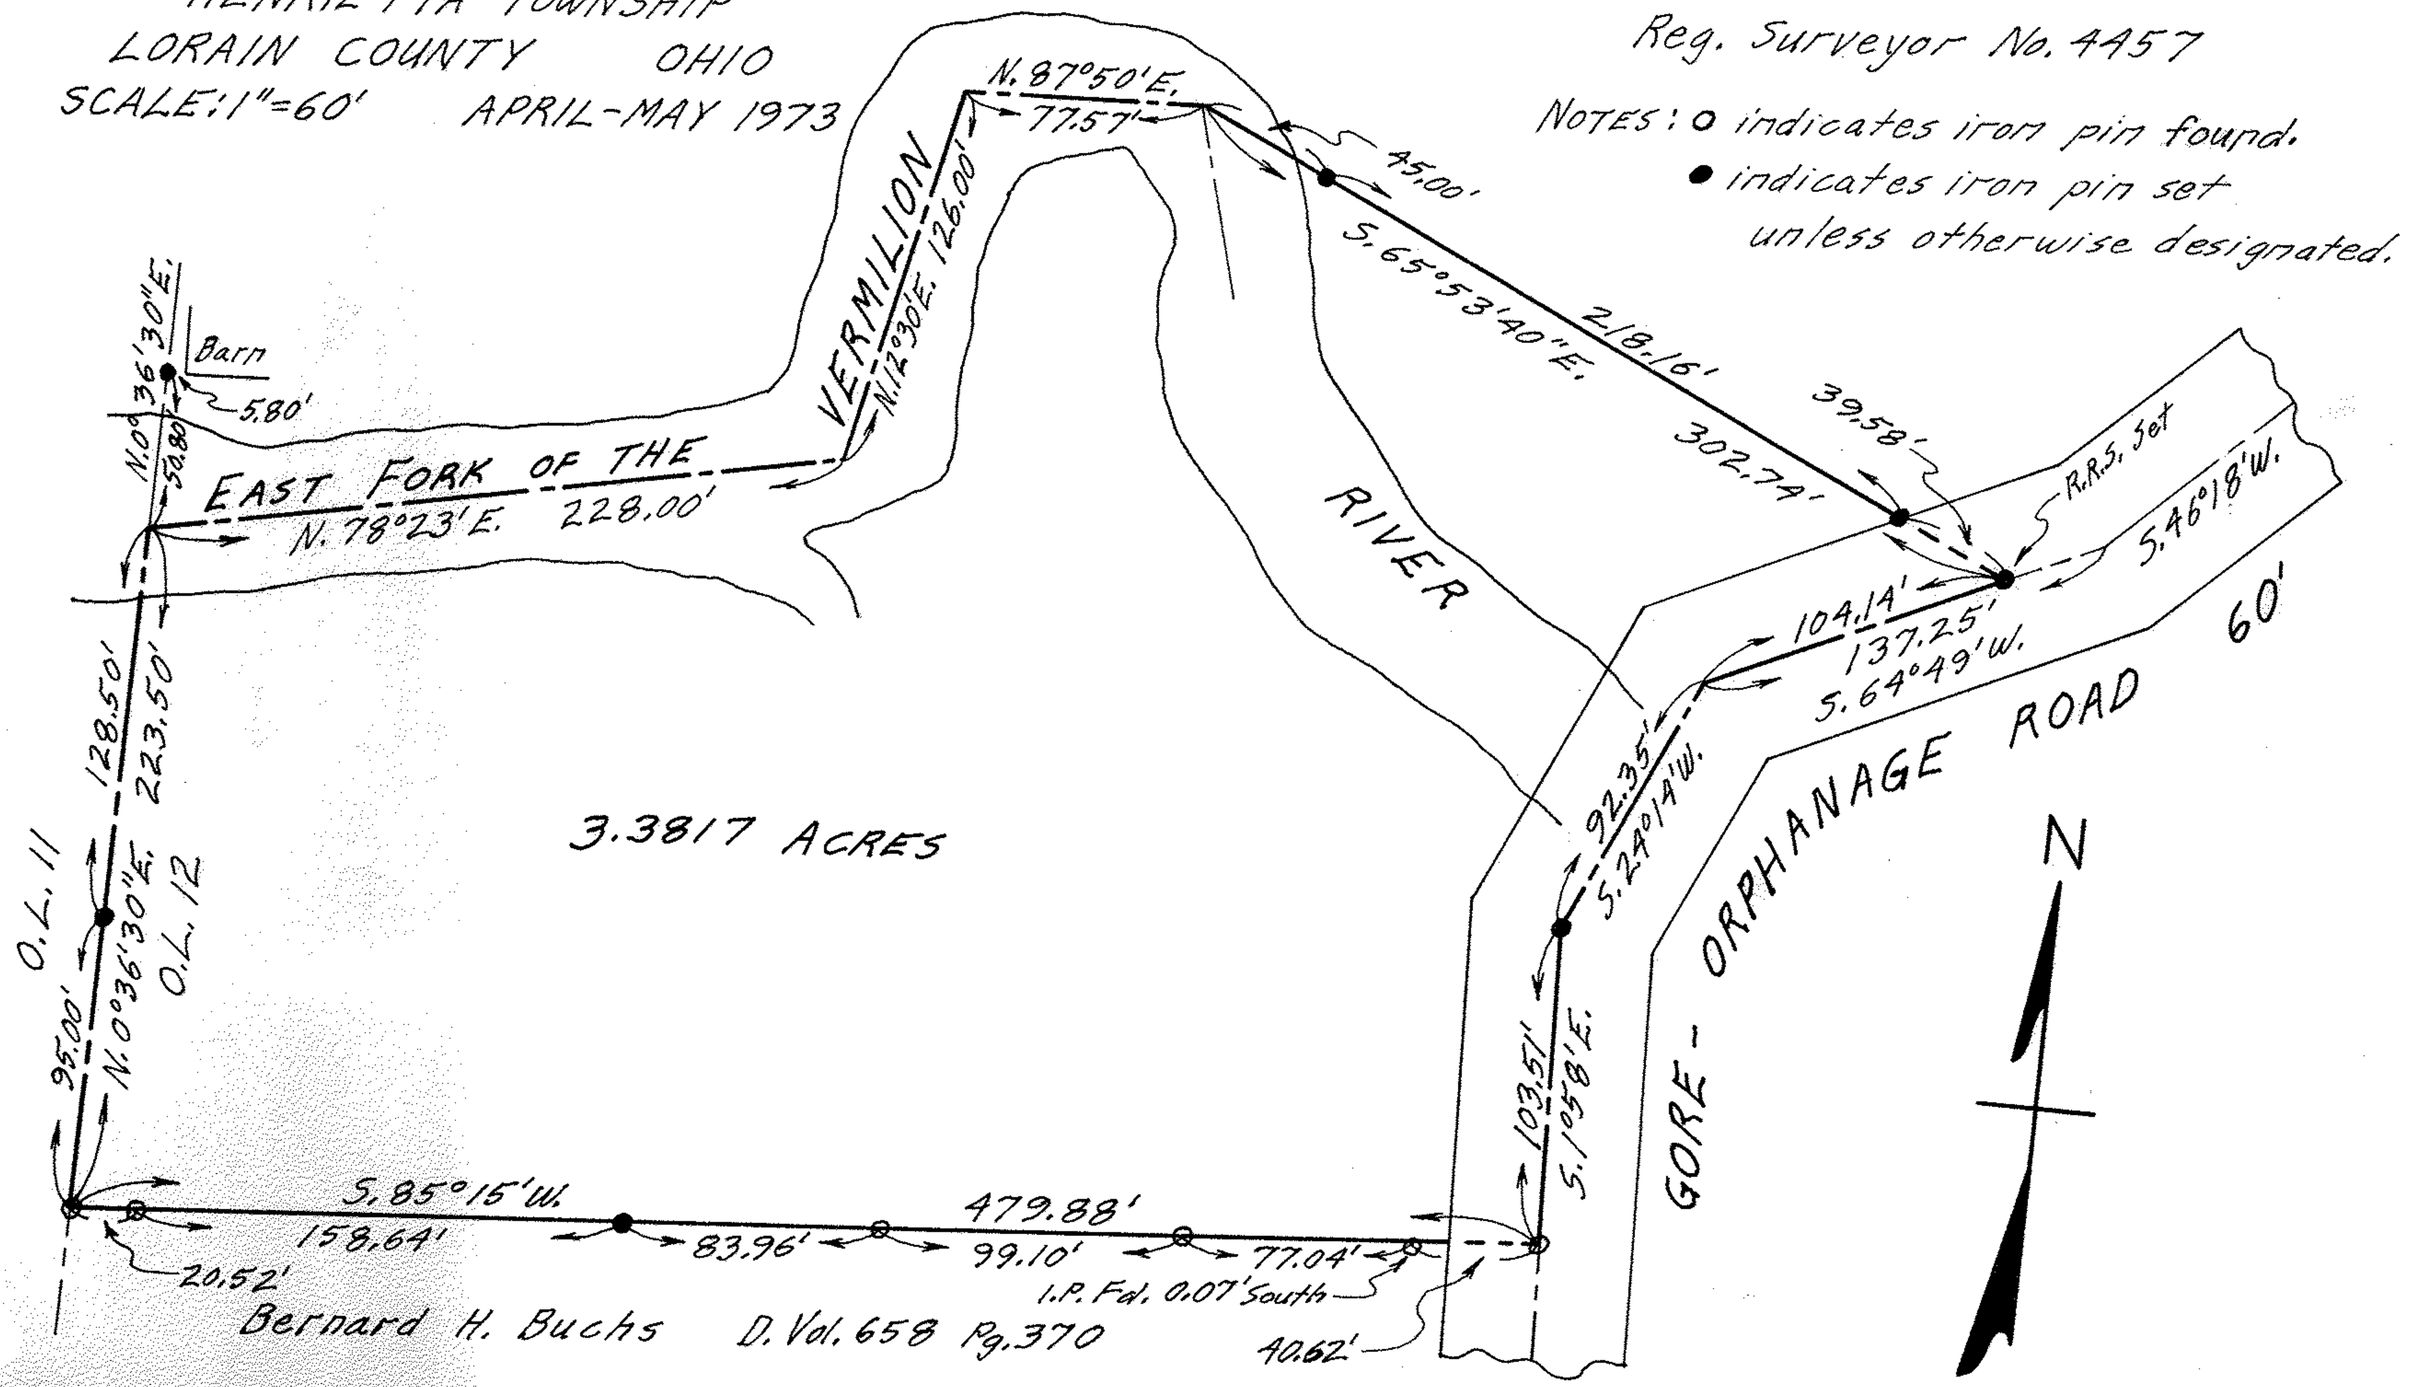
NOTES: o indicates iron pin found.
● indicates iron pin set
unless otherwise designated.