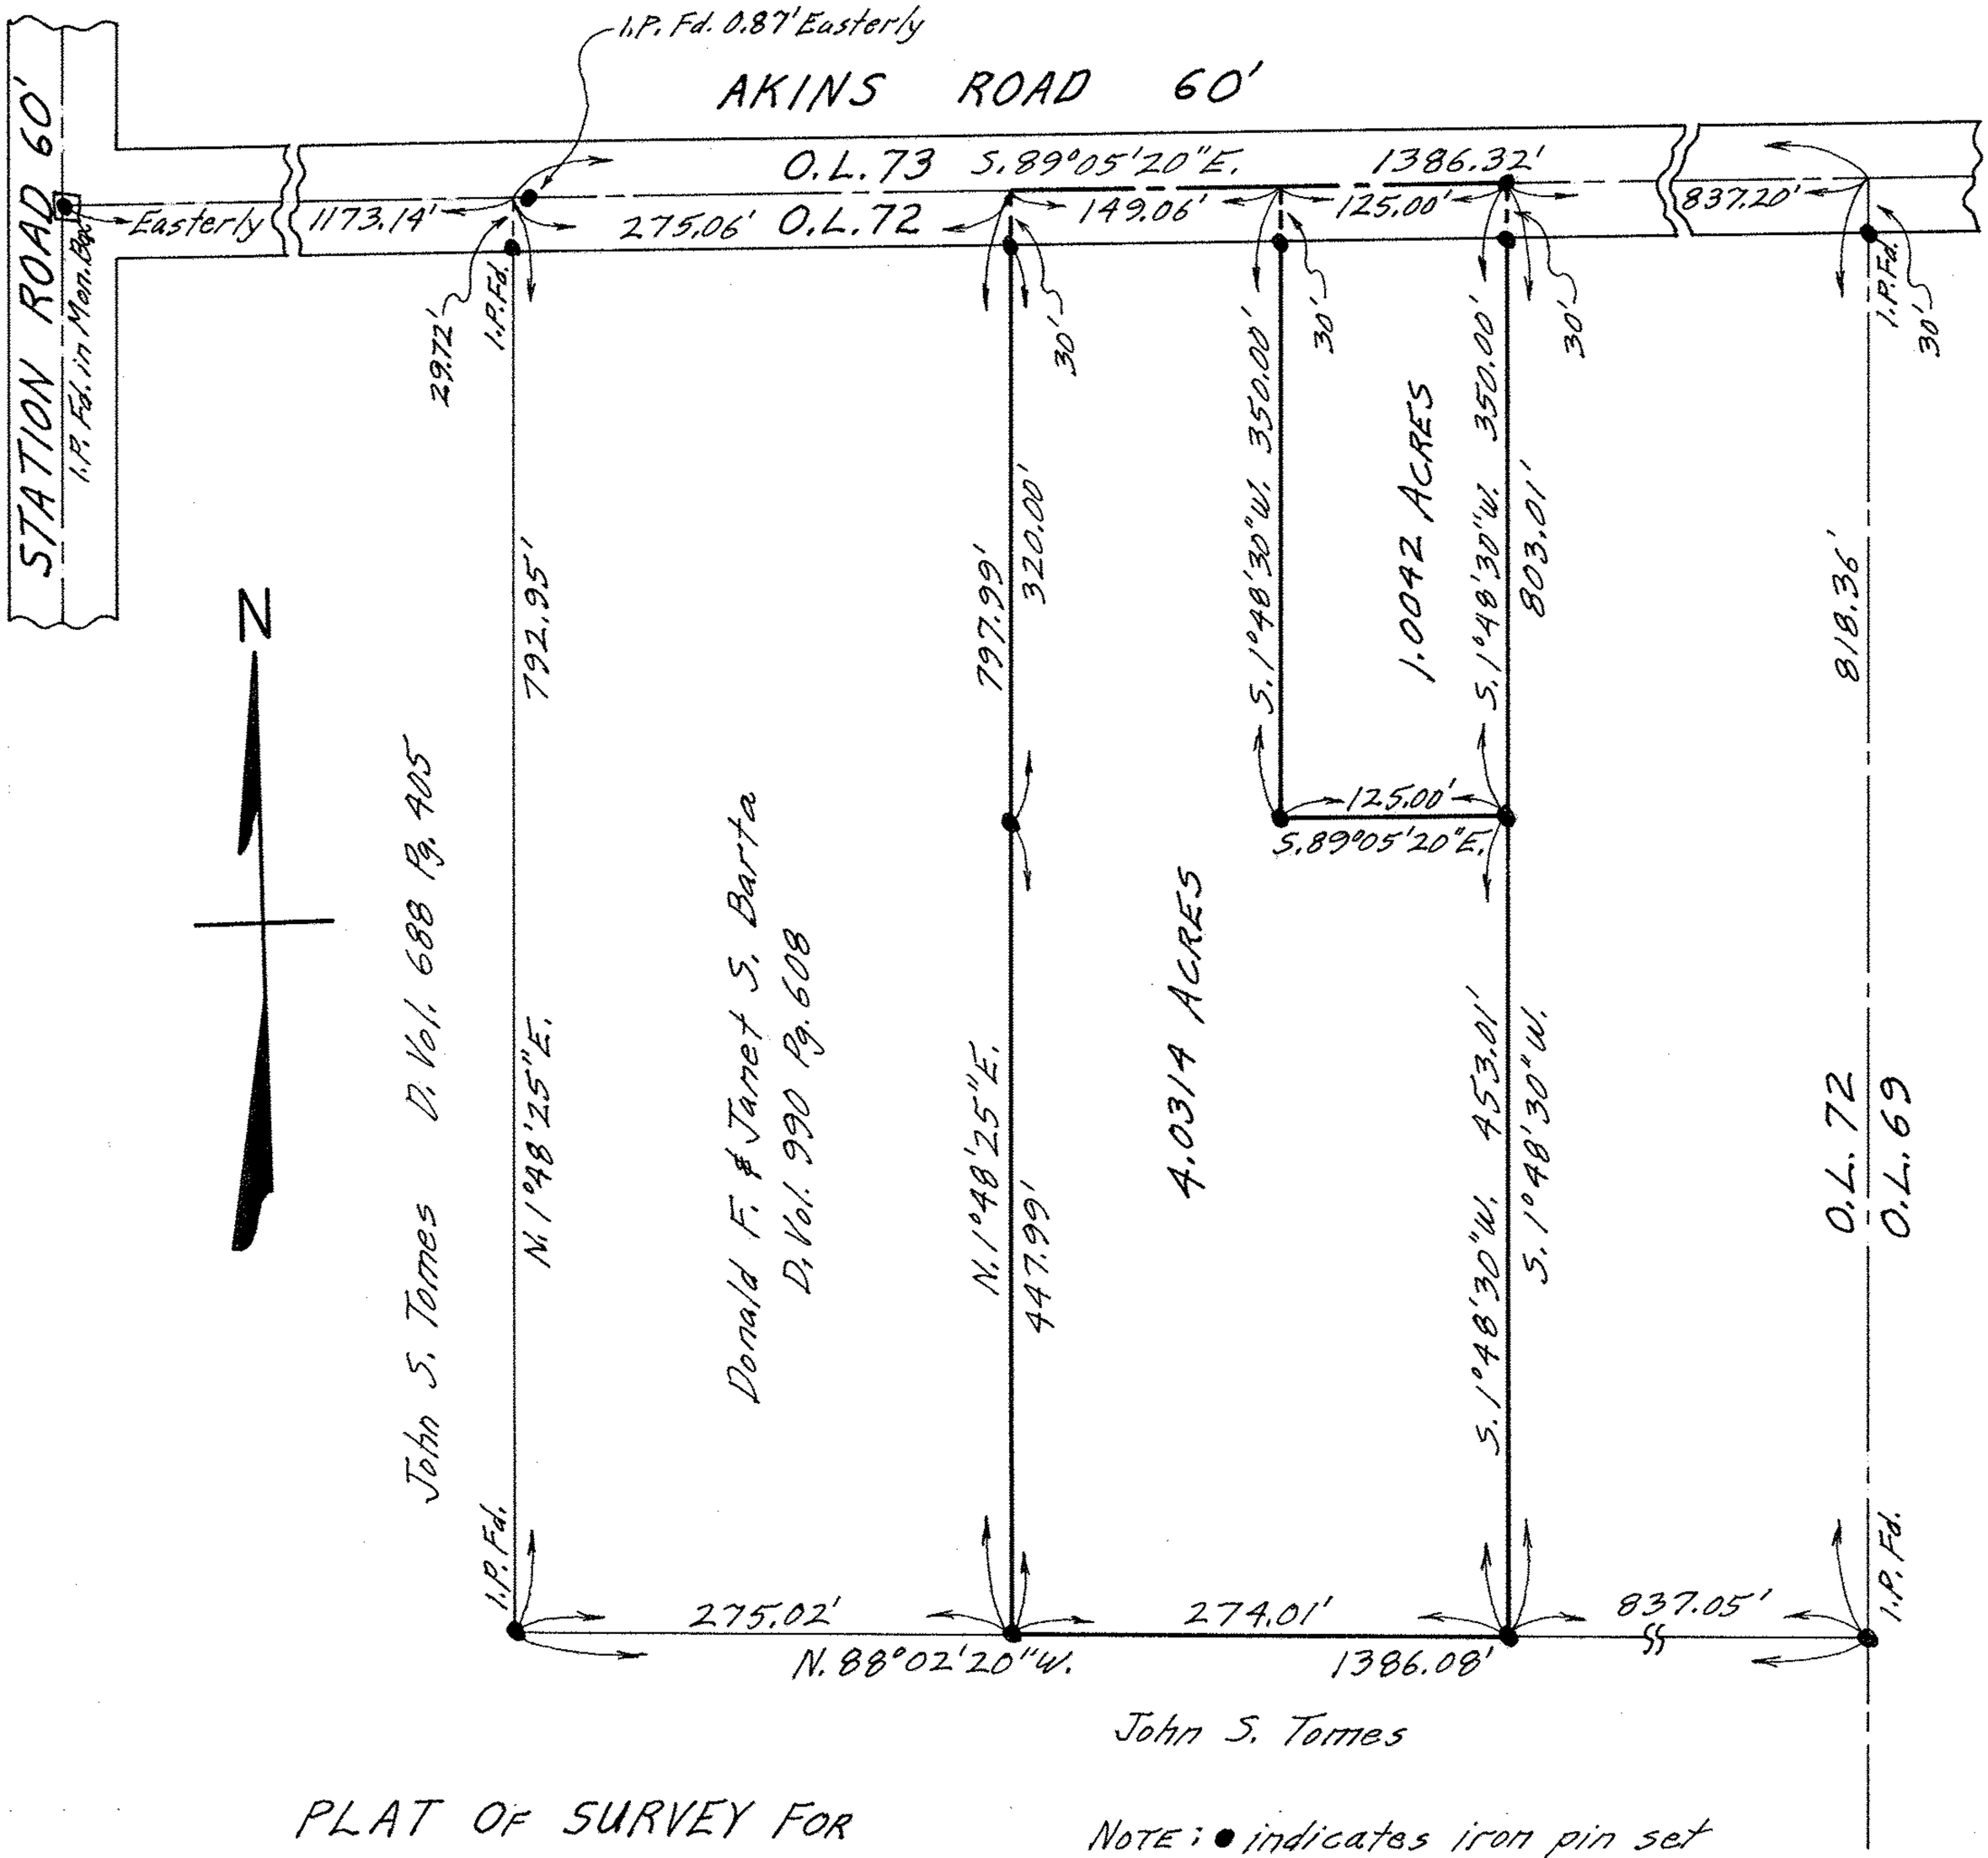

PLAT OF SURVEY FOR
WILFRED L. & ELSIE E. PACK
ORIGINAL LOT 72 COLUMBIA TWP.
LORAIN COUNTY OHIO
SCALE: 1" = 100' MARCH 1971

NOTE: ● indicates iron pin set unless otherwise designated.

Gary E. Penfound
Reg. Surveyor No. 4457

12-00-072