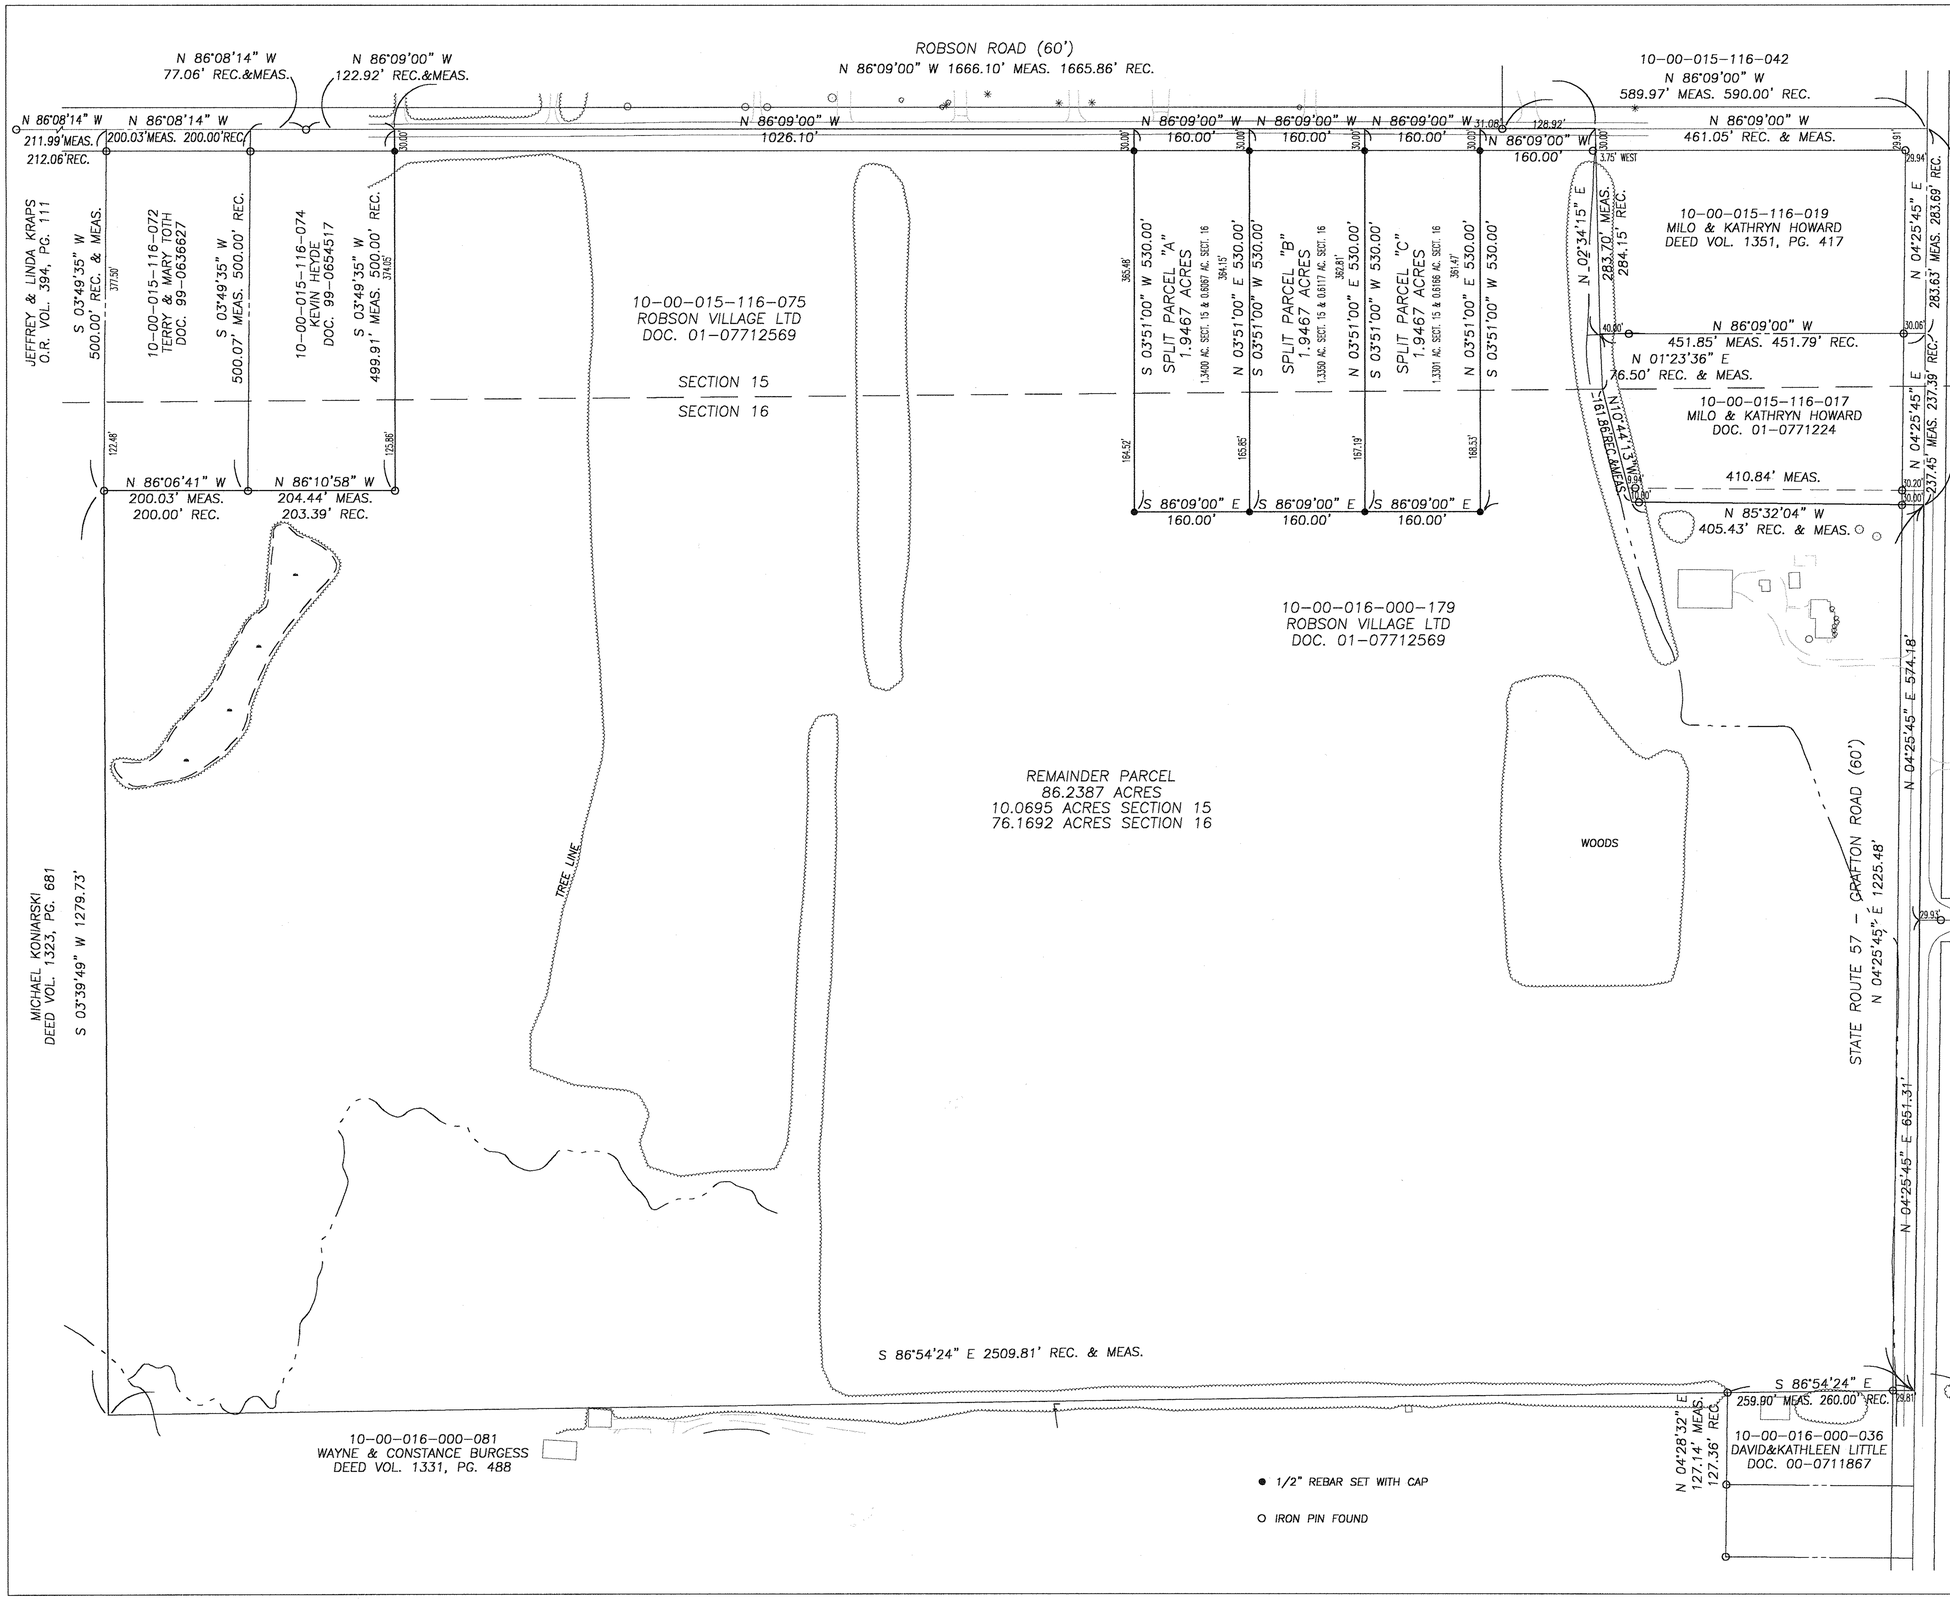

AREA MAP NO SCALE

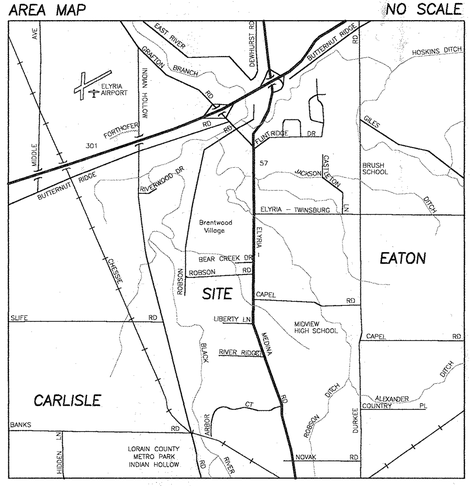

BOUNDARY SURVEY

CARLISLE TOWNSHIP LORAIN COUNTY
STATE OF OHIO
PART OF CARLISLE TOWNSHIP SECTIONS 15 & 16
AS RECORDED IN DOC. NO. 01-0772569
P.P.N.'S 10-00-015-116-075 & 10-00-016-000-179

SITUATED IN CARLISLE TOWNSHIP, COUNTY OF LORAIN, STATE OF OHIO AND BEING PART OF ORIGINAL CARLISLE TOWNSHIP SECTIONS 15 & 16.
I CERTIFY THAT AT THE REQUEST OF THE OWNERS I HAVE SURVEYED AND PLATTED THE LANDS SHOWN HEREON. ALL MEASUREMENTS ARE IN FEET AND DECIMAL PARTS THEREOF. ANGLES ARE TO AN ASSUMED MERIDIAN AND ARE USED TO DESCRIBE ANGLES ONLY.

STATE OF OHIO
CARL R. ANDERSON
S-6580
REGISTERED PROFESSIONAL SURVEYOR

Carl R. Anderson

N
W E
S

0 50 100 200
1 IN. = 200 FT.

PREPARED FOR
ROBSON VILLAGE LTD
33488 LIBERTY PARKWAY
NORTH RIDGEVILLE, OHIO 44039
(440) 327-3030
(440) 327-3071 FAX

PREPARED BY
HAYWOOD CIVIL ENGINEERING
630 CLEVELAND STREET
ELYRIA, OHIO 44035
(440) 365-9831
(440) 365-3426 FAX

Haywood
CIVIL ENGINEERING
ELYRIA, OHIO