



3-00-032-104-013  
3-00-032-A

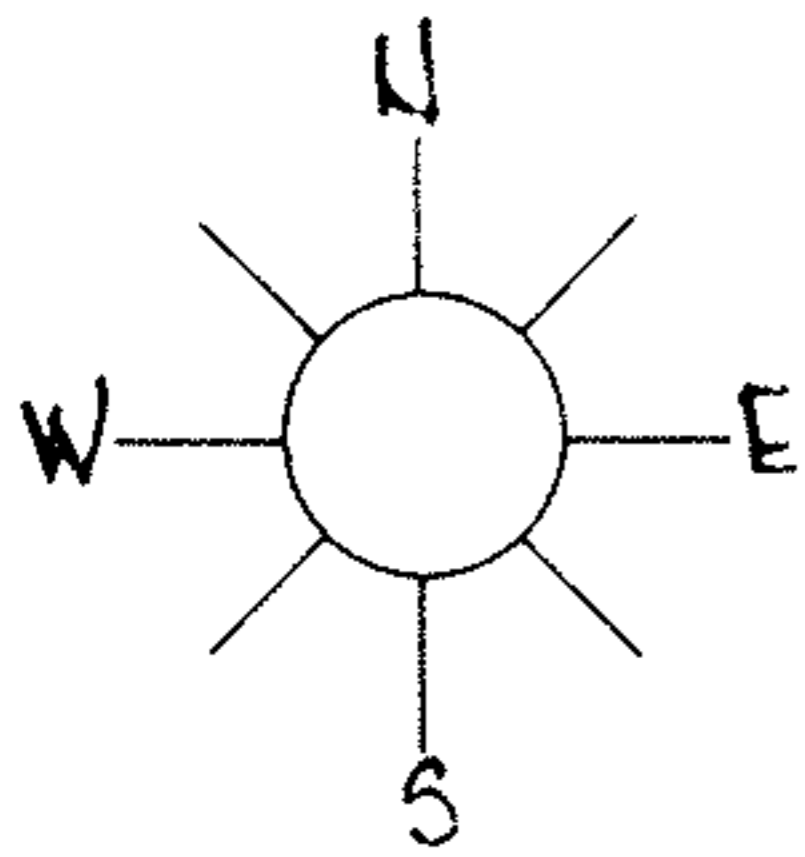

LYNNE DRIVE

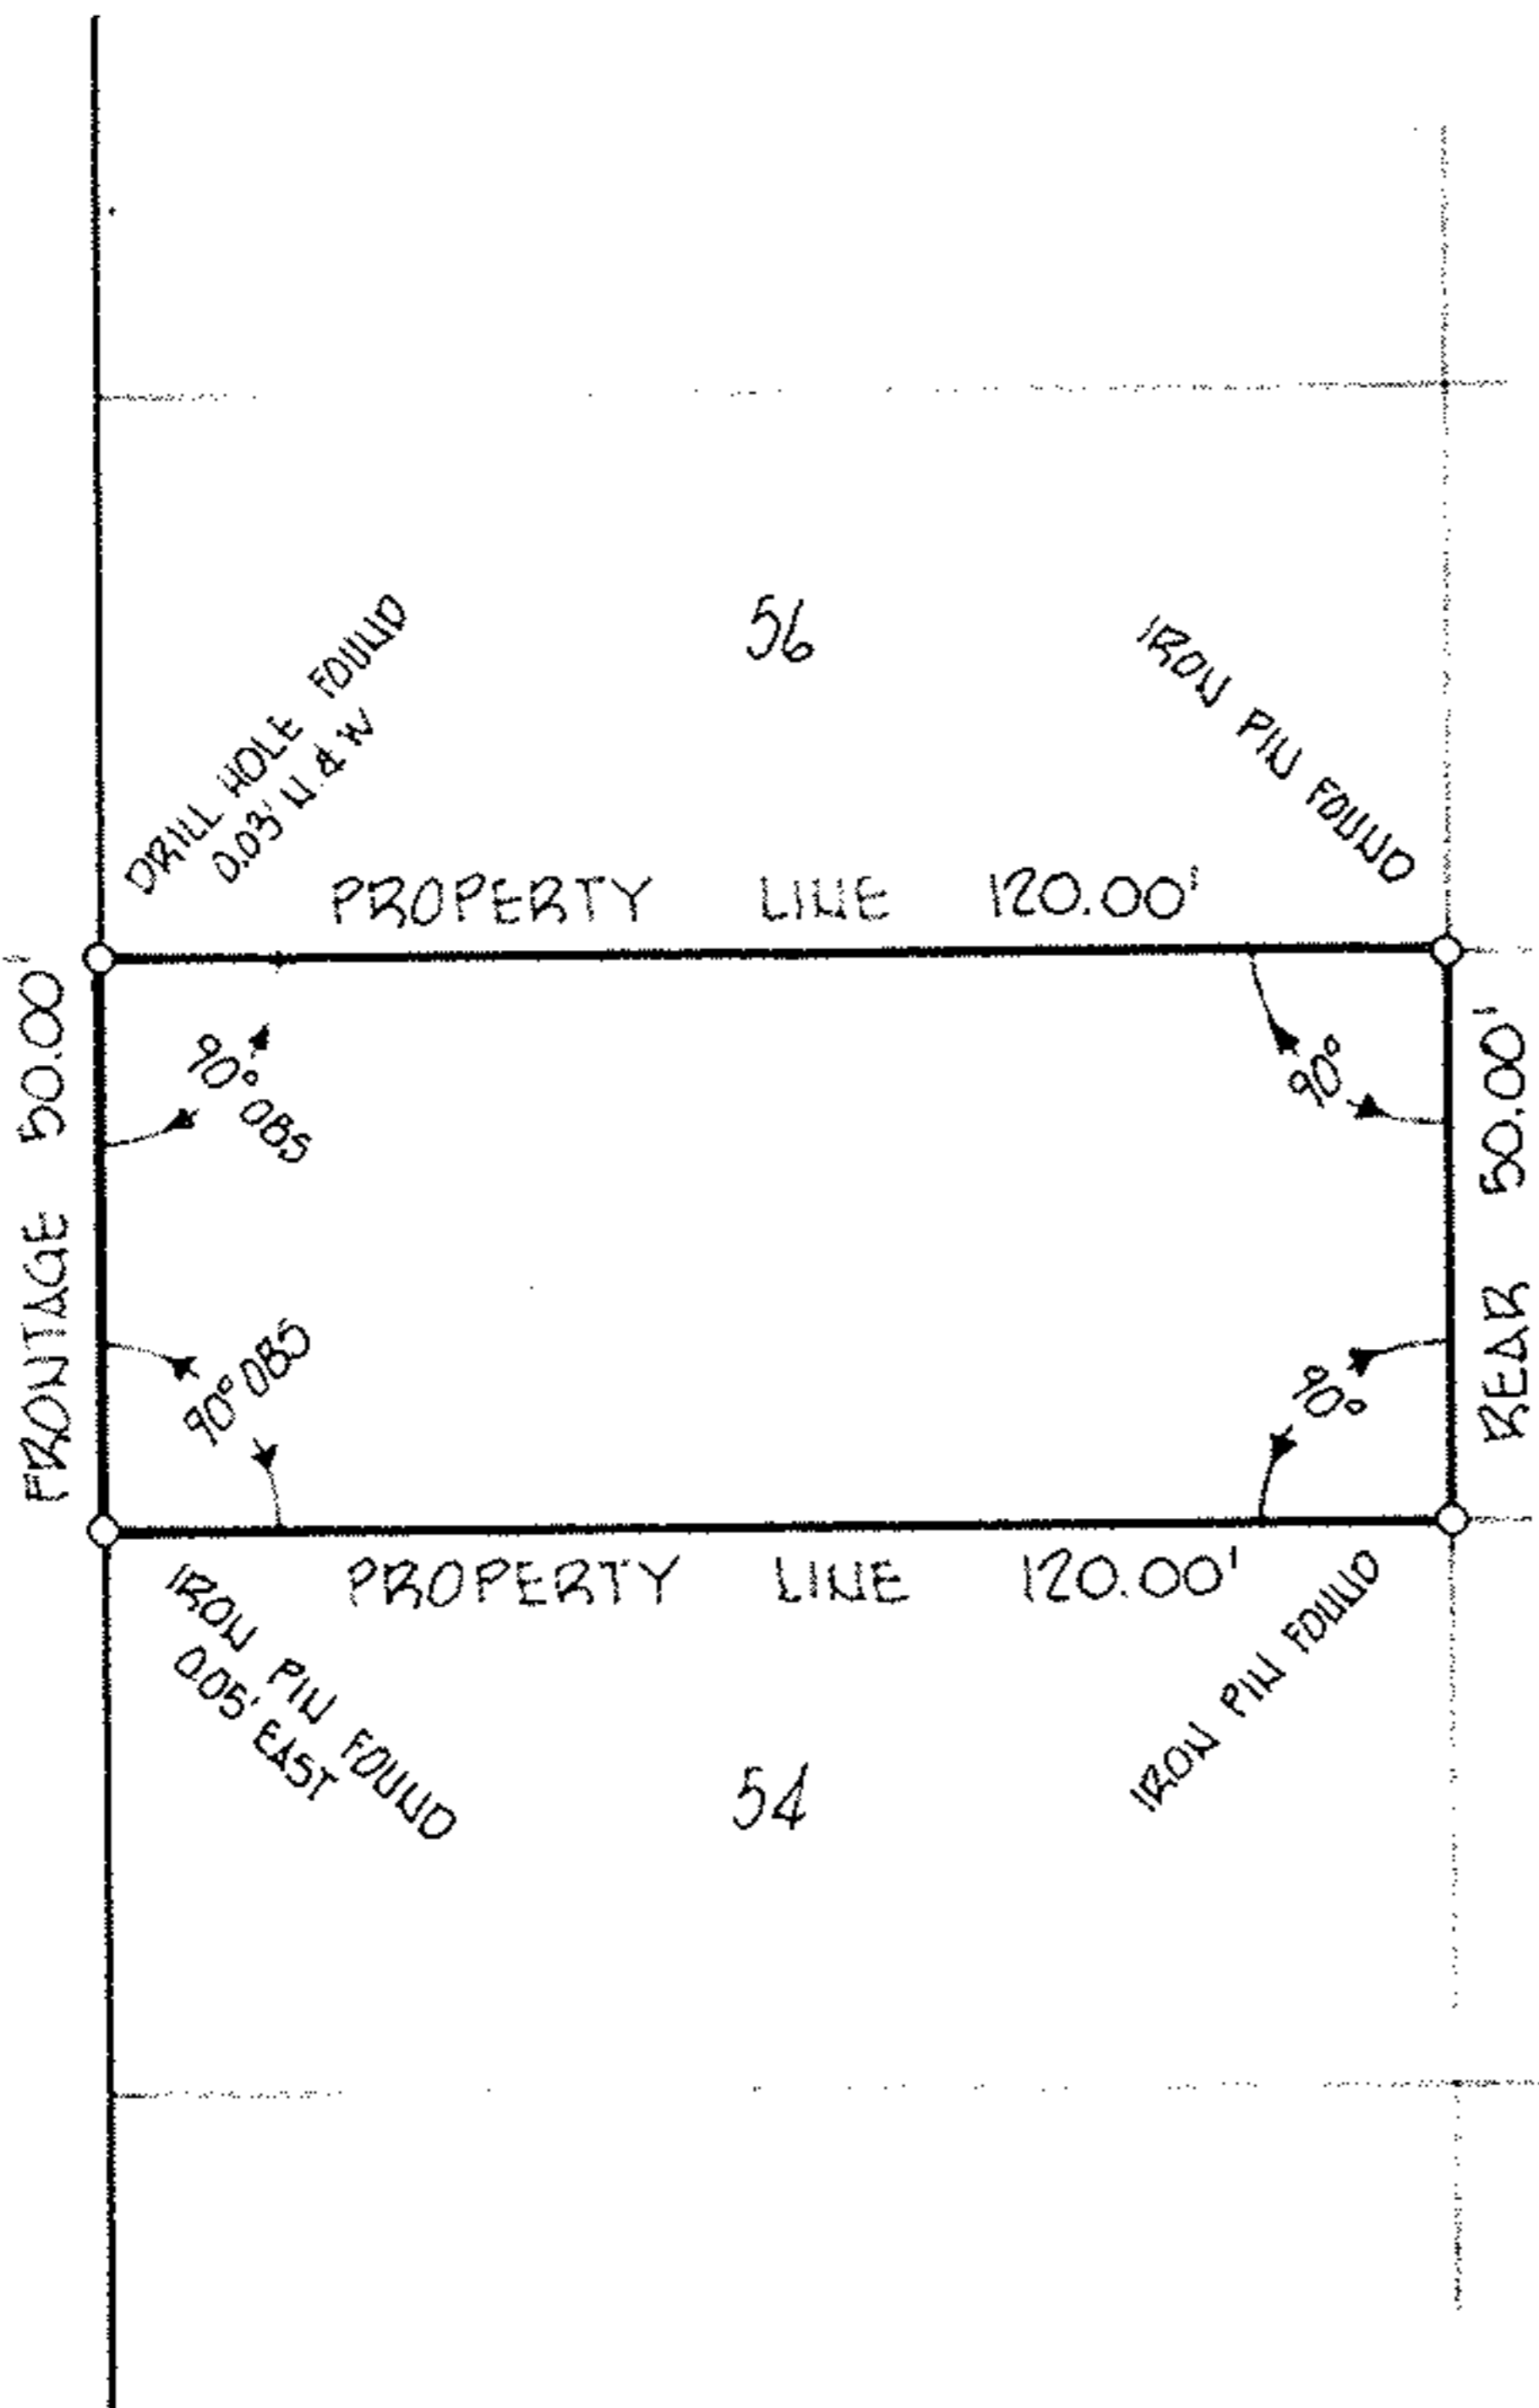

SCALE: 1" = 40'



**PERIMETER SURVEY**

MONUMENT BOX  
1200' P.I.U. FOUND

HAWTHORNE AVENUE

DRIVE

LYNNE

WALKER ROAD

MONUMENT BOX  
1200' P.I.U. FOUND

1541.68' RECORD  
1578.35' RECORD

1541.66' MEASURED  
1578.29' MEASURED

SCALE: 1" = 200'

Scale 1" : \_\_\_\_\_  
Acreage \_\_\_\_\_

36	37	38	39	40	41	42	43	44	45	46	47	48	49	50	51	52	53	54	55	56	57	58	59	60	61	62	63	64	65	66	67	73
105	104	103	102	101	100	99	98	97	96	95	94	93	92	91	90	89	88	87	86	85	84	83	82	81	80	79	78	77	76	75	74	73

SUBLOT 55 of WEST 1/4  
PLAT  
Plat Vol 20 Page 40  
Part of O.L. 32 Section \_\_\_\_\_  
Tract SHEFFIELD TWP  
City of SHEFFIELD LAKE  
LORAIN Co., Ohio

**Michael G. Hura & Associates**  
4560 Liberty Ave. Vermilion, Ohio  
drawn \_\_\_\_\_  
date 9-12-80  
scale \_\_\_\_\_  
field book \_\_\_\_\_

PERMANENT  
PARCEL NUMBER  
03-00-032-104-013