MUNICIPAL ENGINEERING SUBDIVISIONS CITY AND FARM SURVEYS

RAY E. HOLLIS

CIVIL ENGINEER & SURVEYOR

900 COLORADO AVENUE

LORAIN, OHIO 44052

REGISTERED { PROFESSIONAL ENG. NO. 1580 / SURVEYOR NO. 885 } STATE OF OHIO

LORAIN PHONE
ATLANTIC 8 4123

ELYRIA PHONE
FAIRFAX 2-5117

4-010-14

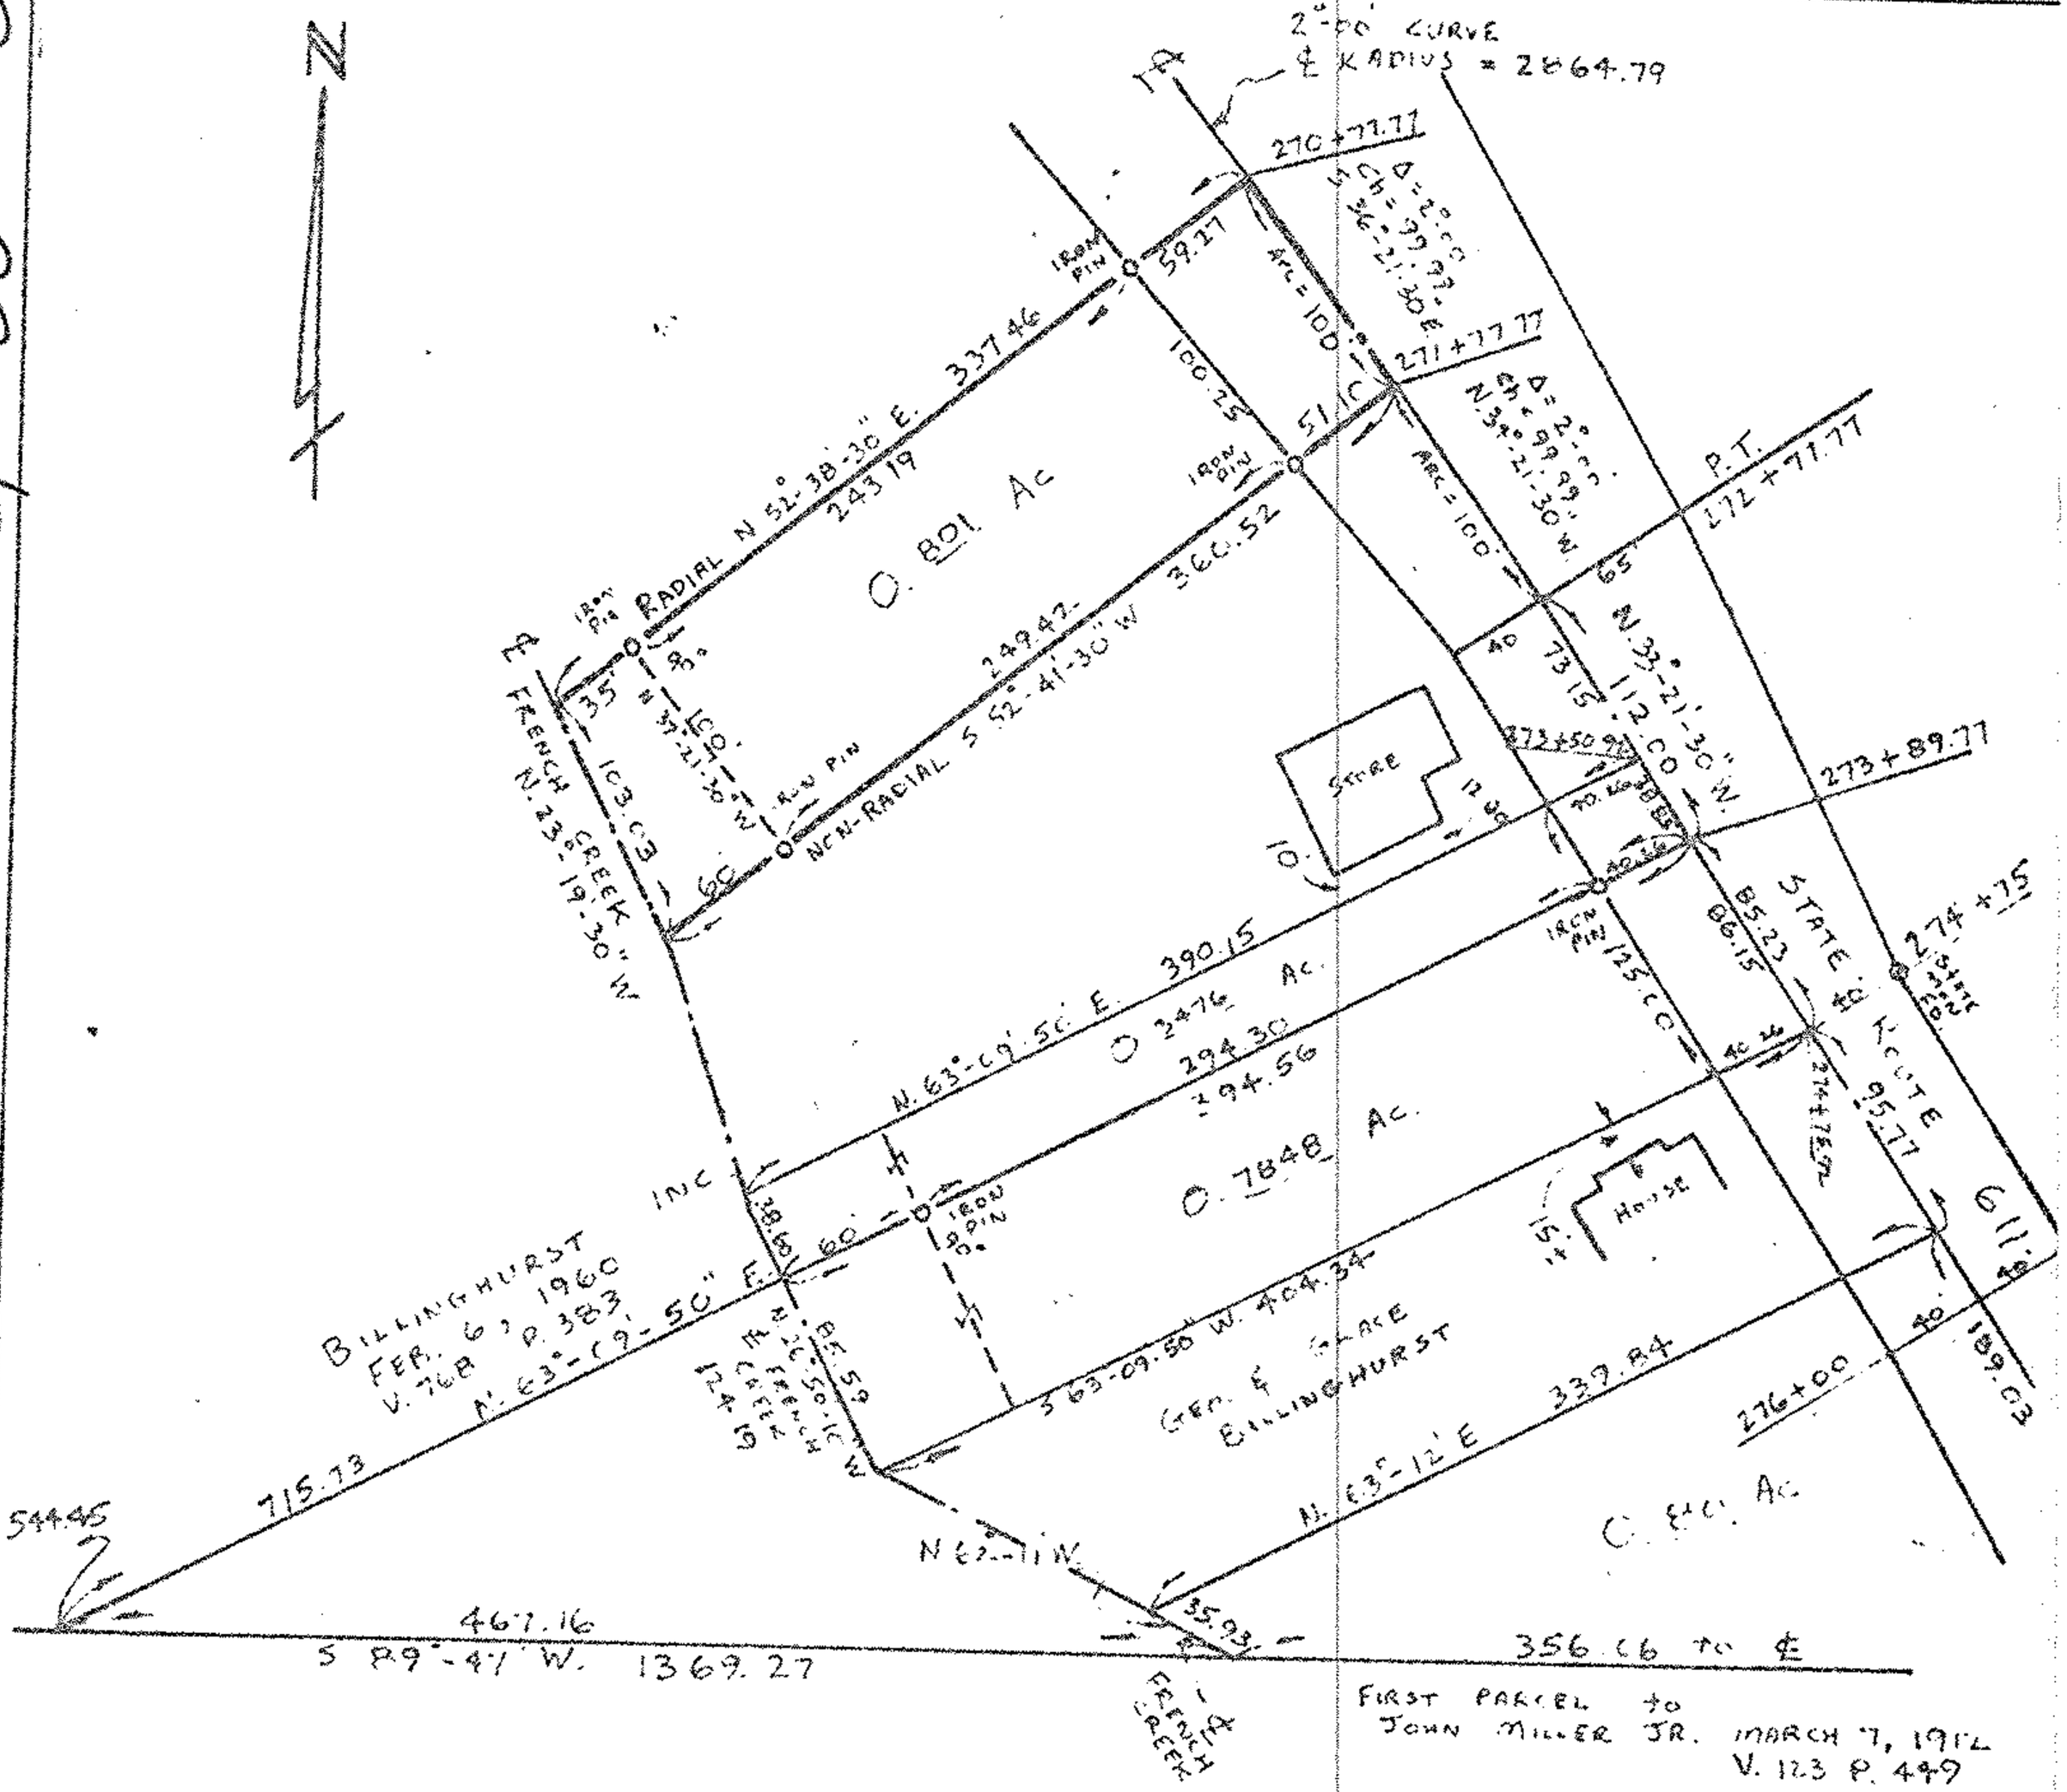

FIRST PARCEL to
JOHN MILLER JR. MARCH 7, 1912
V. 123 P. 449

SURVEY OF BILLINGHURST LAND IN THE CITY OF AVON, SECTION 10, AVON TOWNSHIP, LORAIN COUNTY, OHIO, FROM SURVEY MAP DATED FEB. 11, 1955 by J.H GETZ., REG ENG. & SURVEYOR.

JUNE 4, 1964

SCALE 1" = 100'

4-010-15