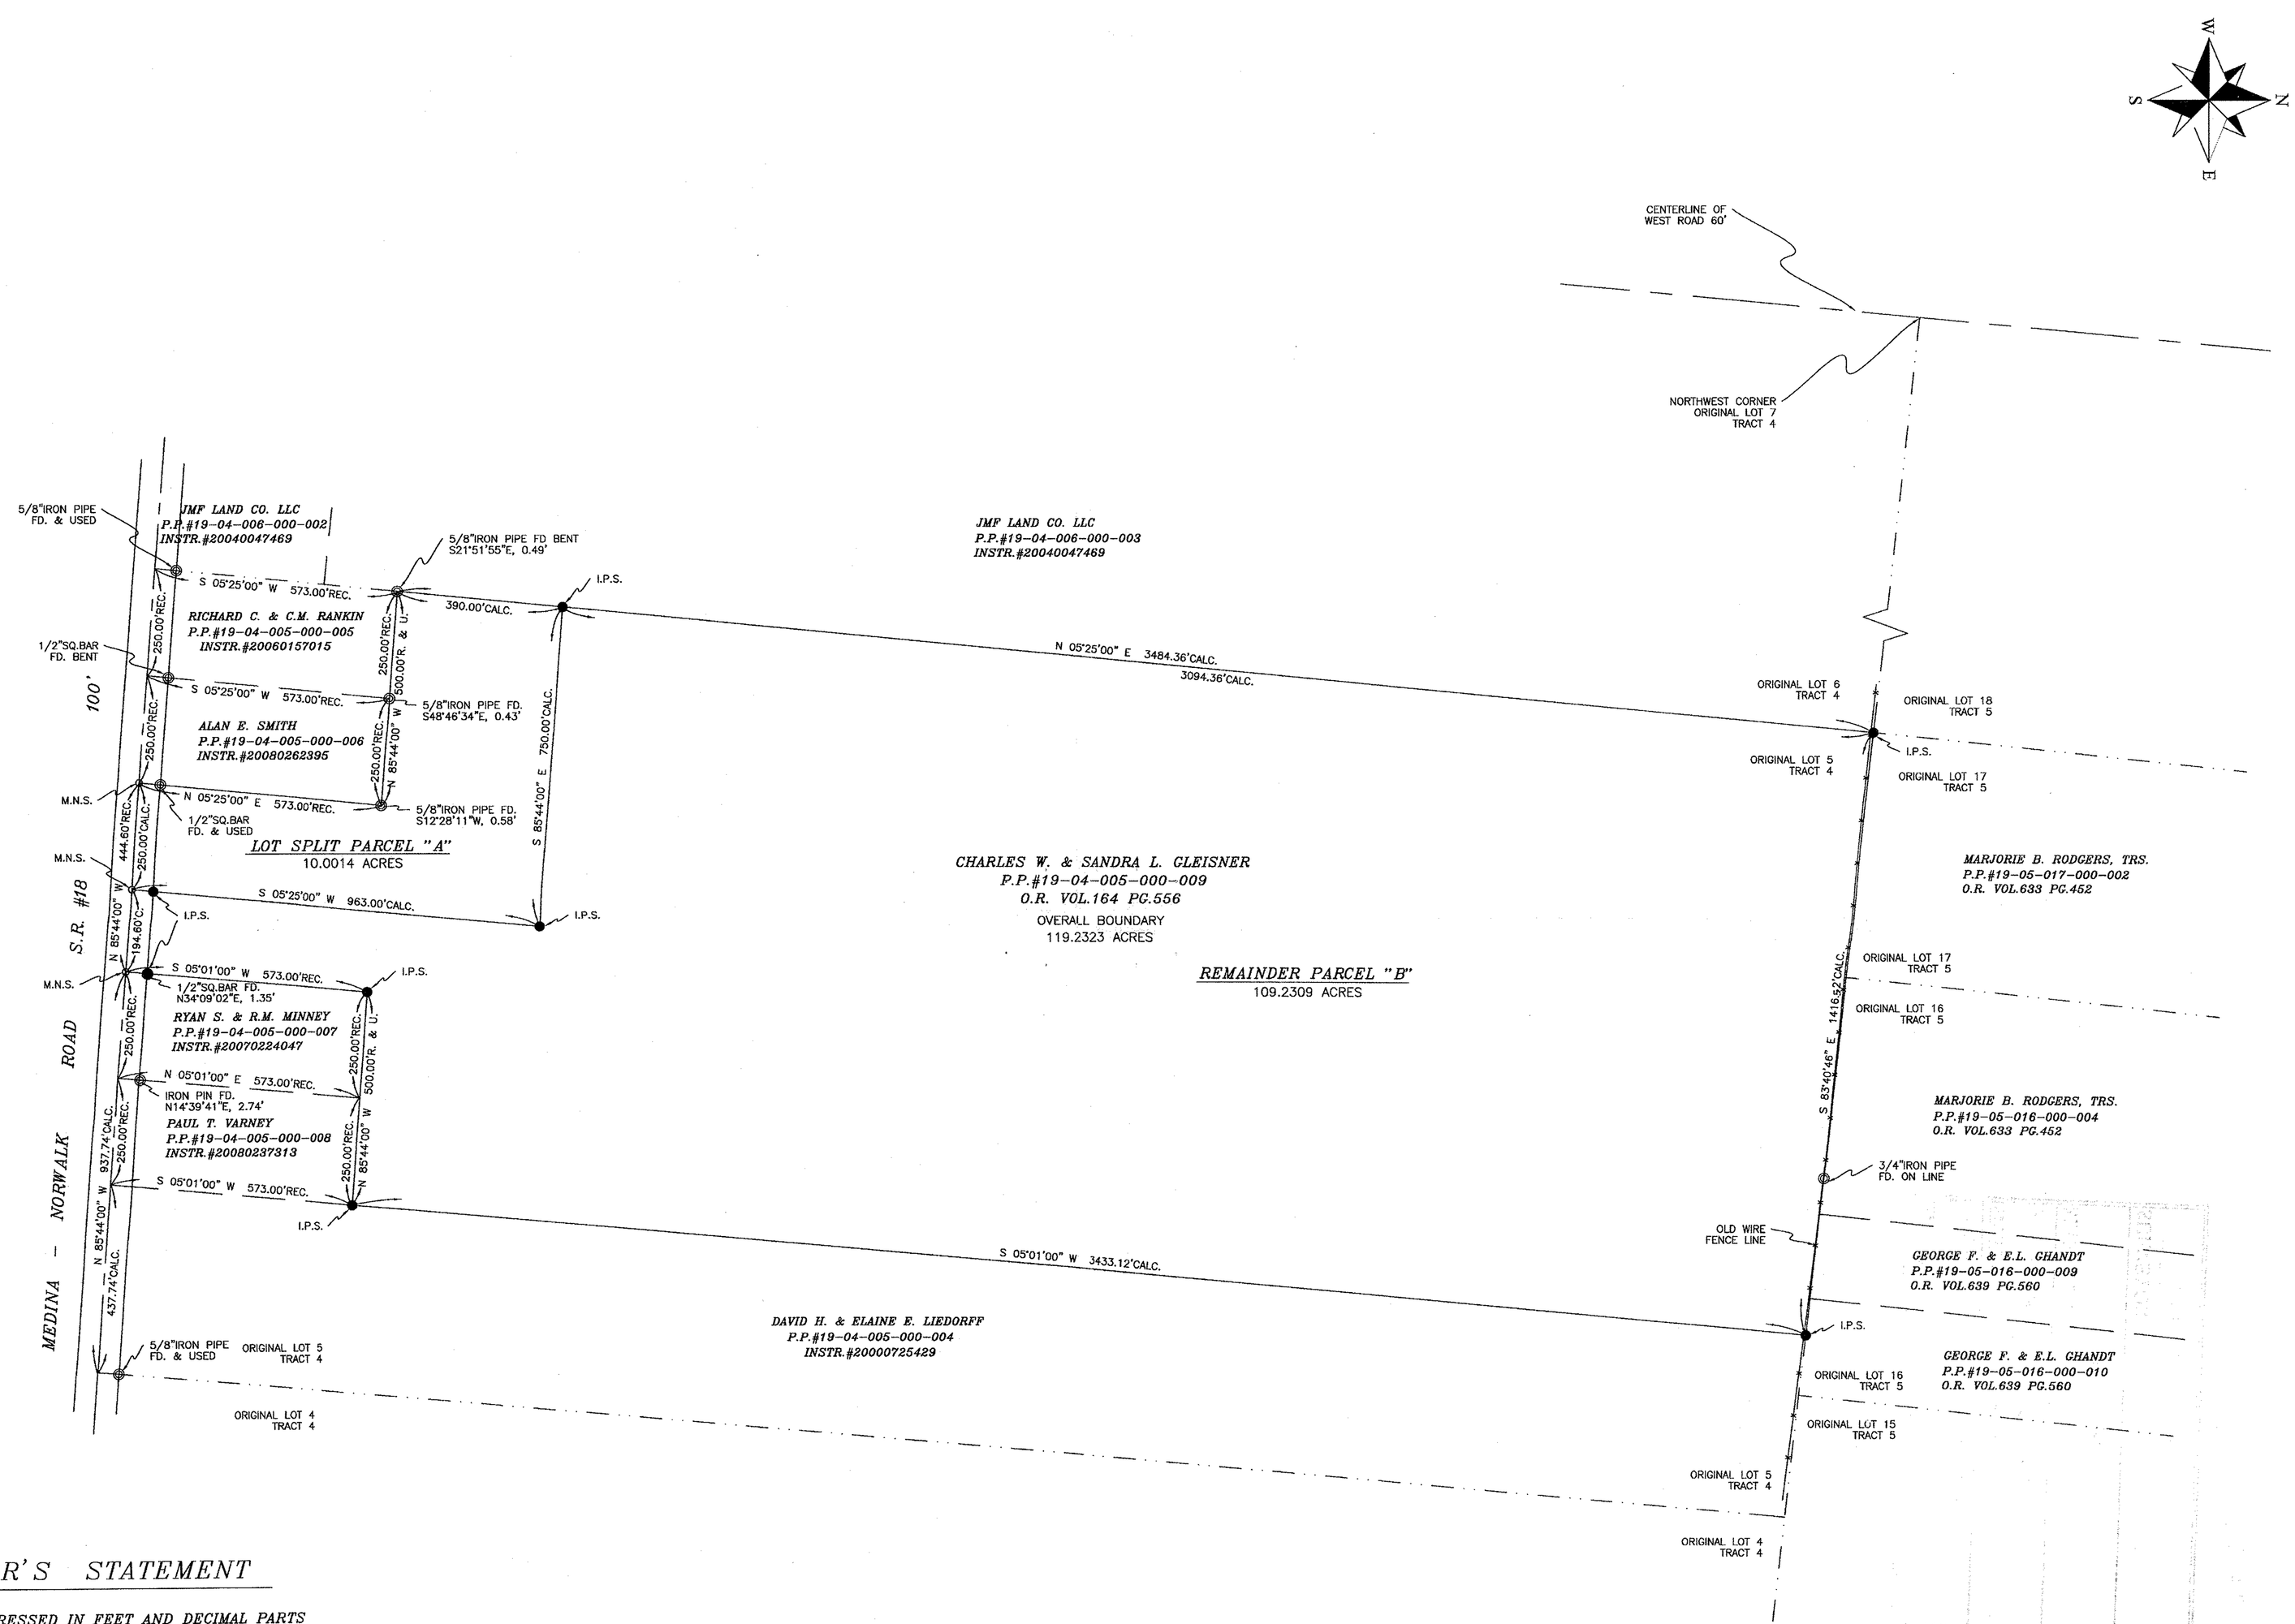


## SURVEYOR'S STATEMENT

DISTANCES ARE EXPRESSED IN FEET AND DECIMAL PARTS THEREOF. BEARINGS ARE TO AN ASSUMED MERIDIAN AND ARE USED TO INDICATE ANGLES ONLY. PERMANENT MONUMENTS WERE FOUND OR SET AS INDICATED HEREON. ALL OF WHICH I DECLARE TO BE CORRECT TO THE BEST OF MY ABILITIES AND BELIEFS.

THOMAS M. SNEZEK, P.S. 7051 — DATE 12-5-08

STATE OF OHIO — THOMAS M. SNEZEK S-7051 — SURVEYOR

SITUATED IN THE TOWNSHIP OF PENFIELD, COUNTY OF LORAIN, STATE OF OHIO AND BEING KNOWN AS PART OF ORIGINAL PENFIELD TOWNSHIP LOT 5, TRACT 4 AND ALSO BEING KNOWN AS PART OF THOSE LANDS DEEDED TO CHARLES W. AND SANDRA L. GLEISNER IN DEED O.R. VOLUME 164, PAGE 556 OF LORAIN COUNTY DEED RECORDS.

## LEGEND:

I.P.S. — INDICATES A 5/8" IRON PIN WITH IDENTIFICATION CAP MARKED "T.SNEZEK - S-7051" SET

M.N.S. — INDICATES A MAGNETIC NAIL SET

200' 0' 200' 400'
SCALE: 1" = 200'

PROJECT NO. GLEISNER#0812

# MAP OF SURVEY AND LOT SPLIT

PREPARED FOR:

CHARLES W. & SANDRA L. GLEISNER
42864 STATE ROUTE 18 MEDINA-NORWALK ROAD
WELLINGTON, OHIO 44090

PREPARED BY:

SNEZEK & ASSOCIATES, L.L.C.
PROFESSIONAL SURVEYORS
CLEVELAND, OHIO 44111
DADSURV@HOTMAIL.COM
3496 COLLETTA LANE
(216) 671-4902
FAX (216)-941-2431

| DRAWN | DATE | SHEET |
|---|---|---|
| T.SNEZEK | 12-02-08 | 1OF1 |
| REVISED: | | |