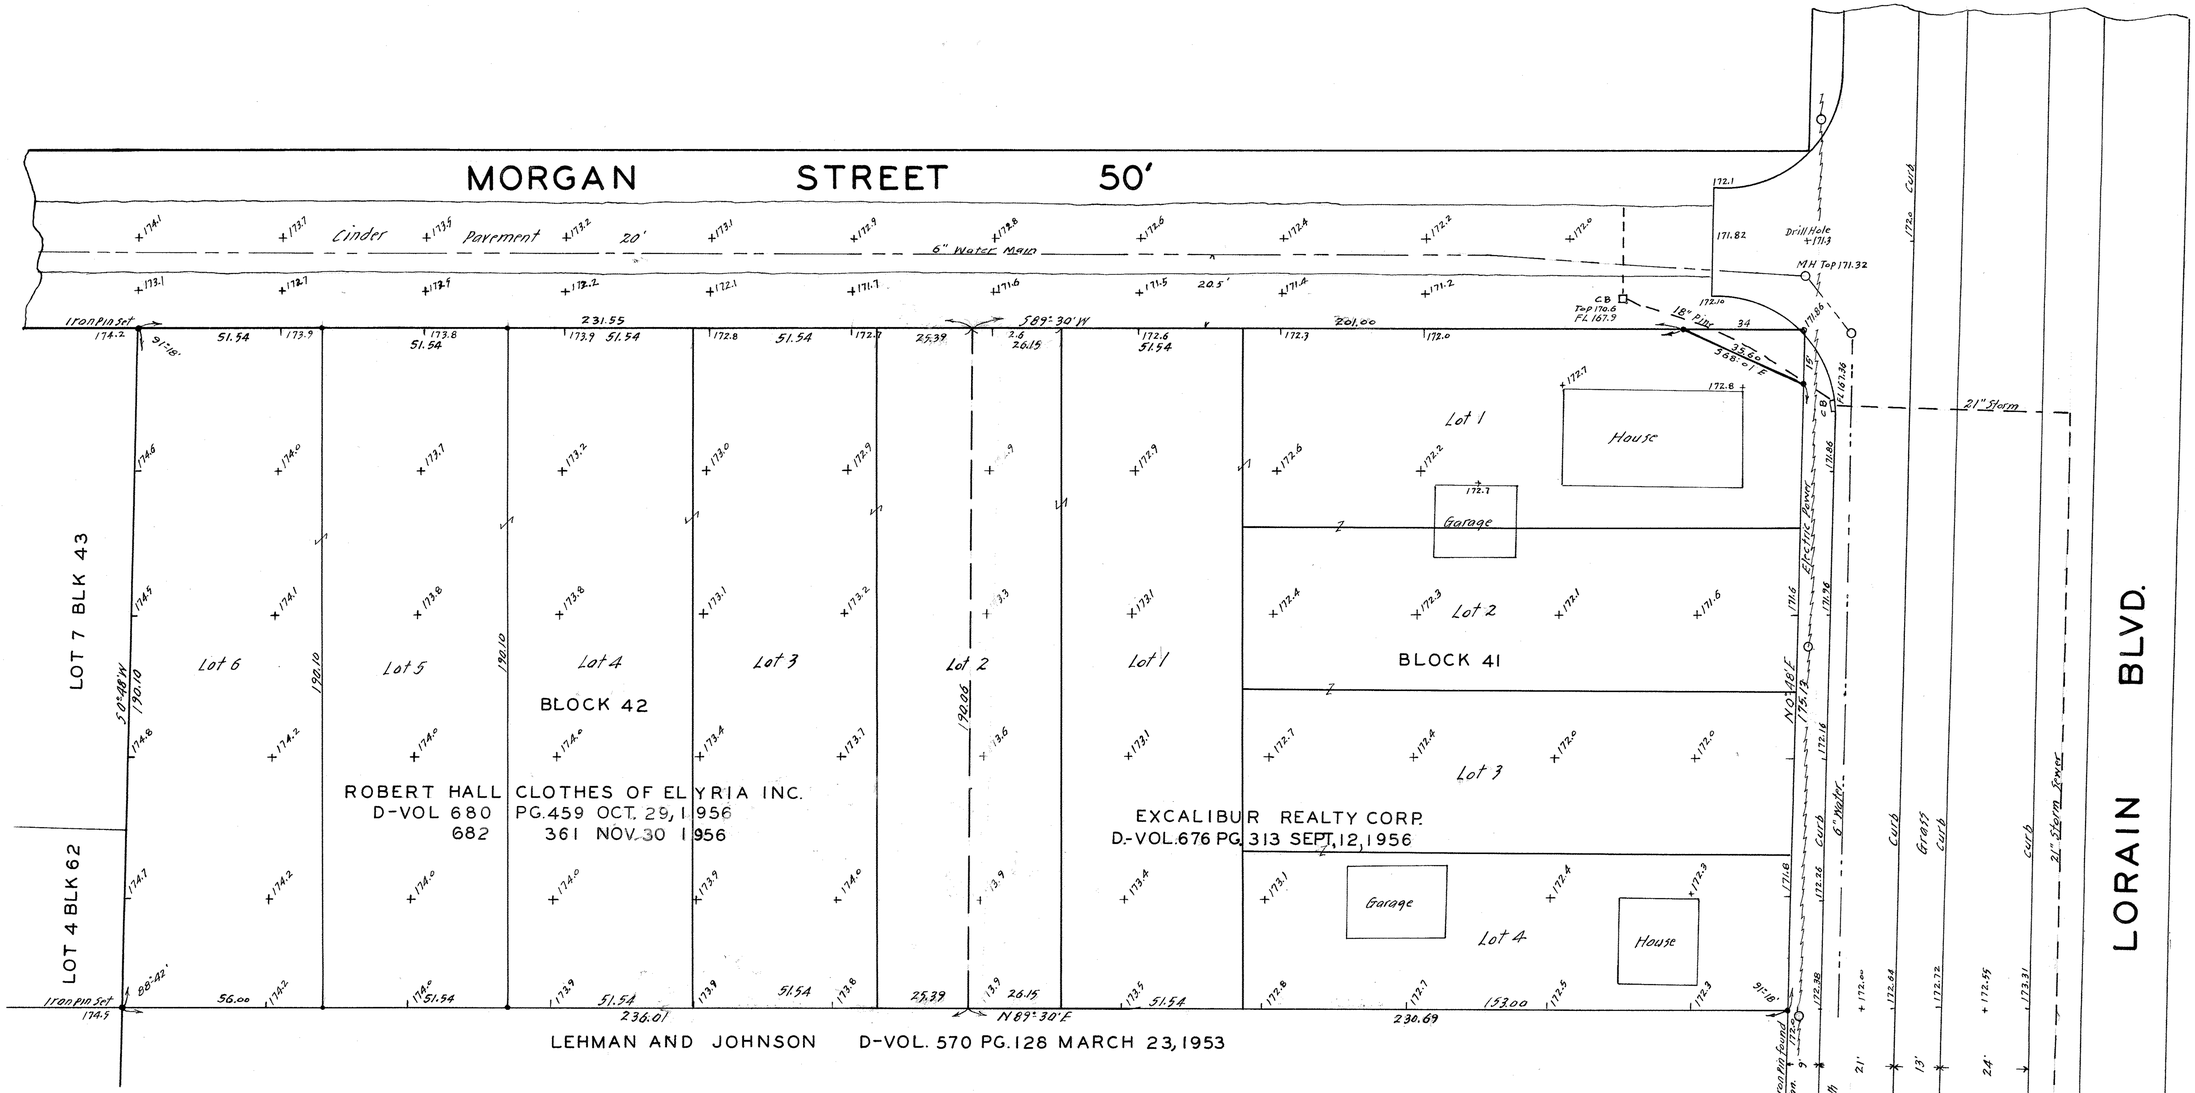

ROBERT HALL CLOTHES

BLOCK 41 LOTS 1-2-3-4 BLOCK 42 LOTS 1-2-3-4-5-6
ACRE FARMS ALLOTMENT NO. 2
LOT 34 ELYRIA TWP. WEST OF BLACK RIVER
ELYRIA CITY, LORAIN COUNTY OHIO
SCALE 1" = 20' JULY 13, 1956
J. W. WARDEN AND ASSOCIATES REG. SURVEYORS
Revised Oct. 26. 1956. Feb. 13. 1957

PPN 06-24-034-105-015-7020

SCAN 41354
MAP Pg 6-62