


FRANK & ANNA BOHAC D-VOL. 246 PG. 154 MAY 18, 1929

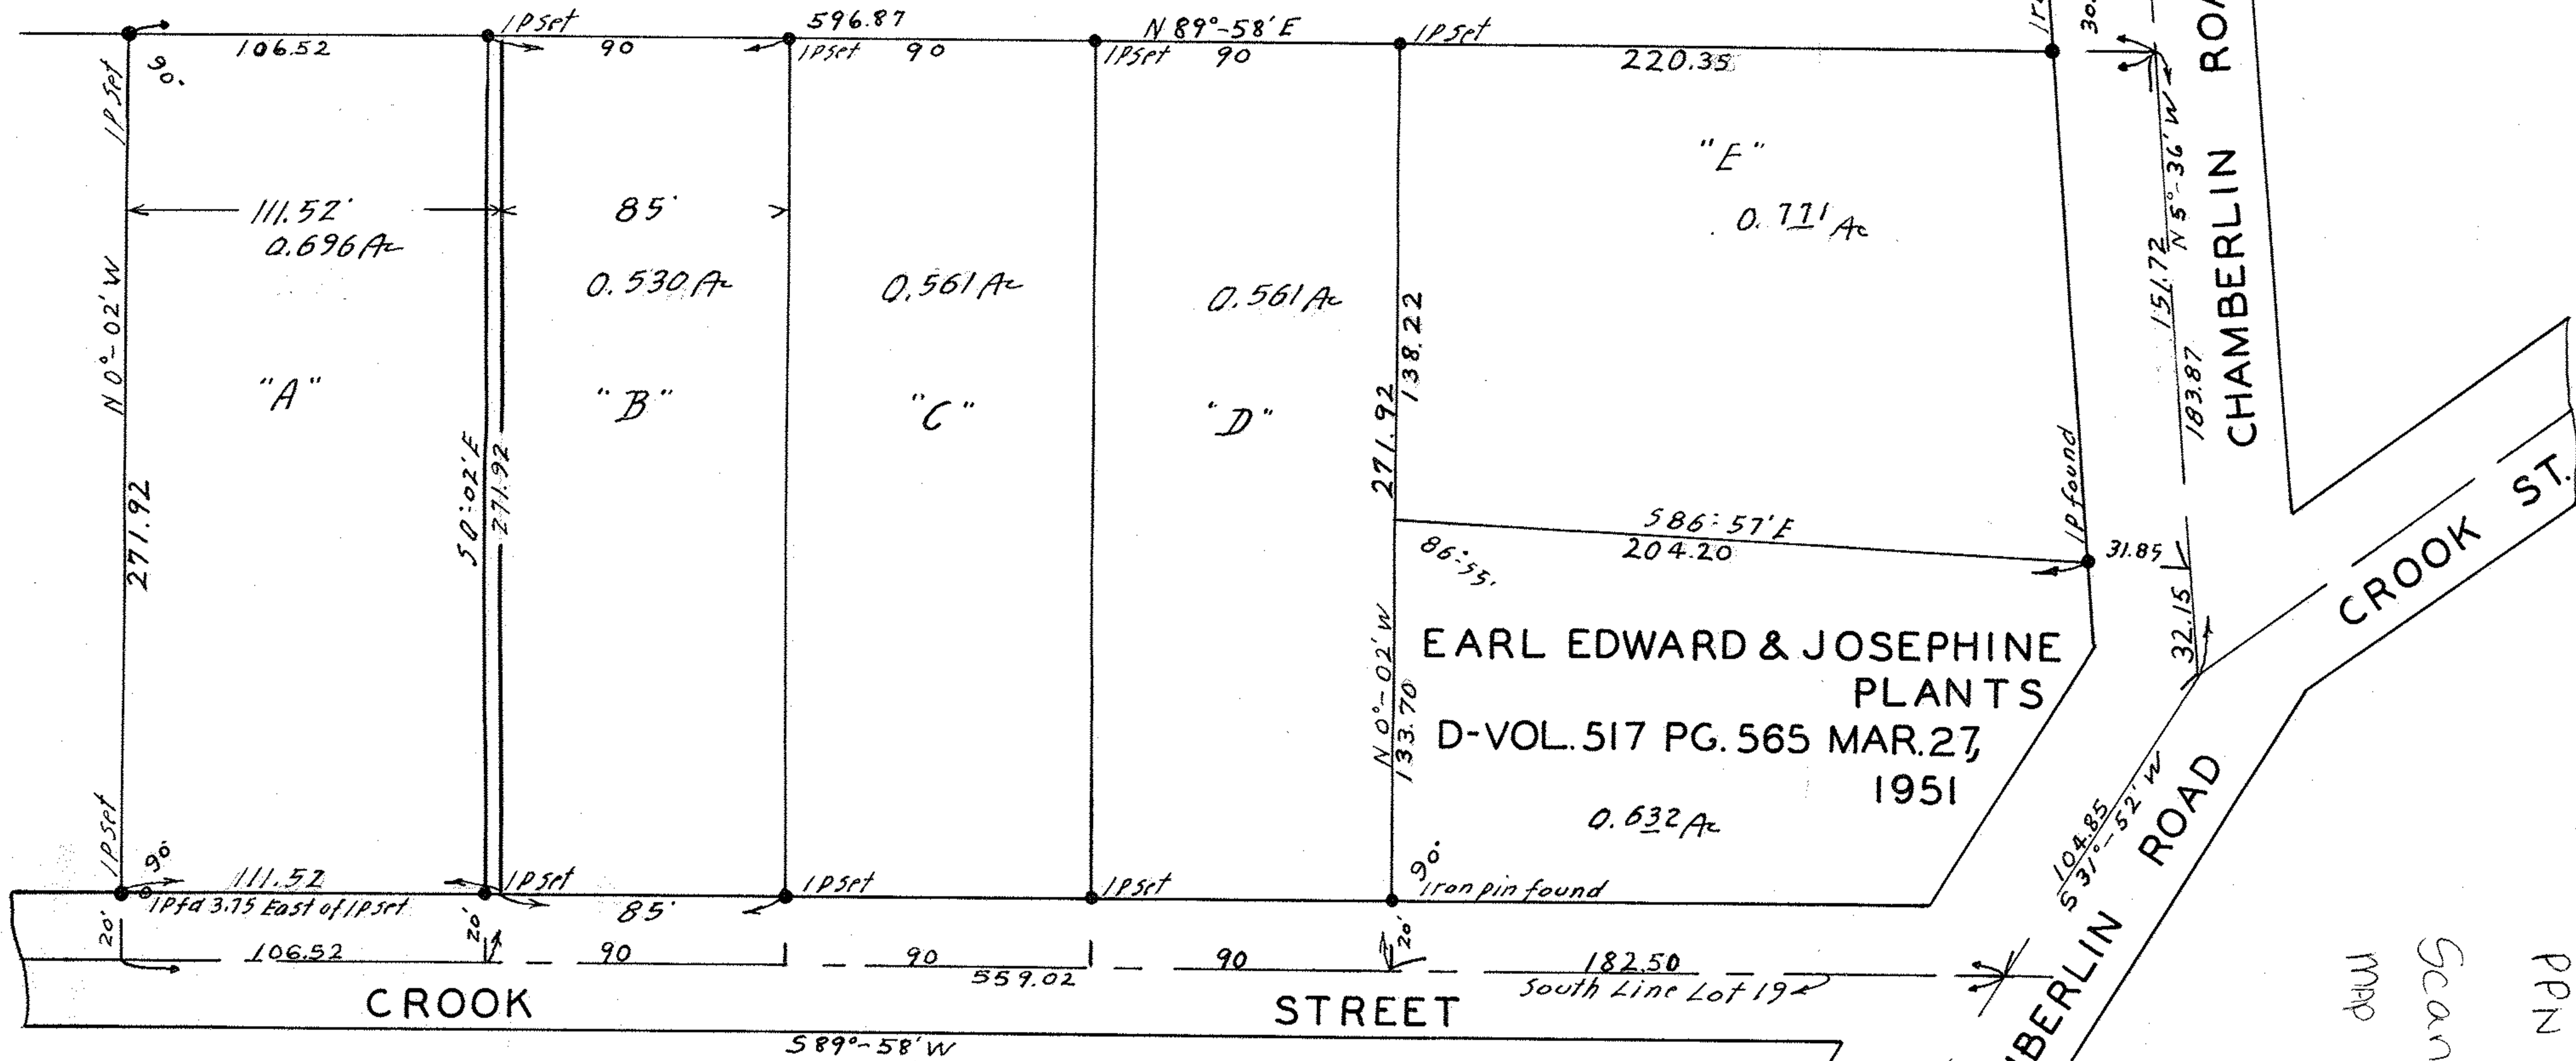

SURVEY FOR  
**FRANK A. AND MOLLY C. GIDLIN**  
 D-VOL. 334 PG. 74 OCT. 20 1943  
 LOT 19 GRAFTON TOWNSHIP  
 LORAIN COUNTY, OHIO  
 SCALE 1"=50' SEPT. 20, 1951  
 J. W. WARDEN & ASSOCIATES - REGISTERED SURVEYOR'S  
 TOTAL ACREAGE, A-B-C-D & E 3.119 Revised Sept. 25, 1952.

951-25  
6211-98

PPN 16-00-019-102 020,021,  
 025-027  
 Scan 41361  
 MRP PG 16-00-019-C

