


PPN 06-25 064000-005-006
 06-25-065-000-006
 Scan 41363
 map pg 6-103

A. J. Curren Pl. #2-D. Vol-237-Pg-265

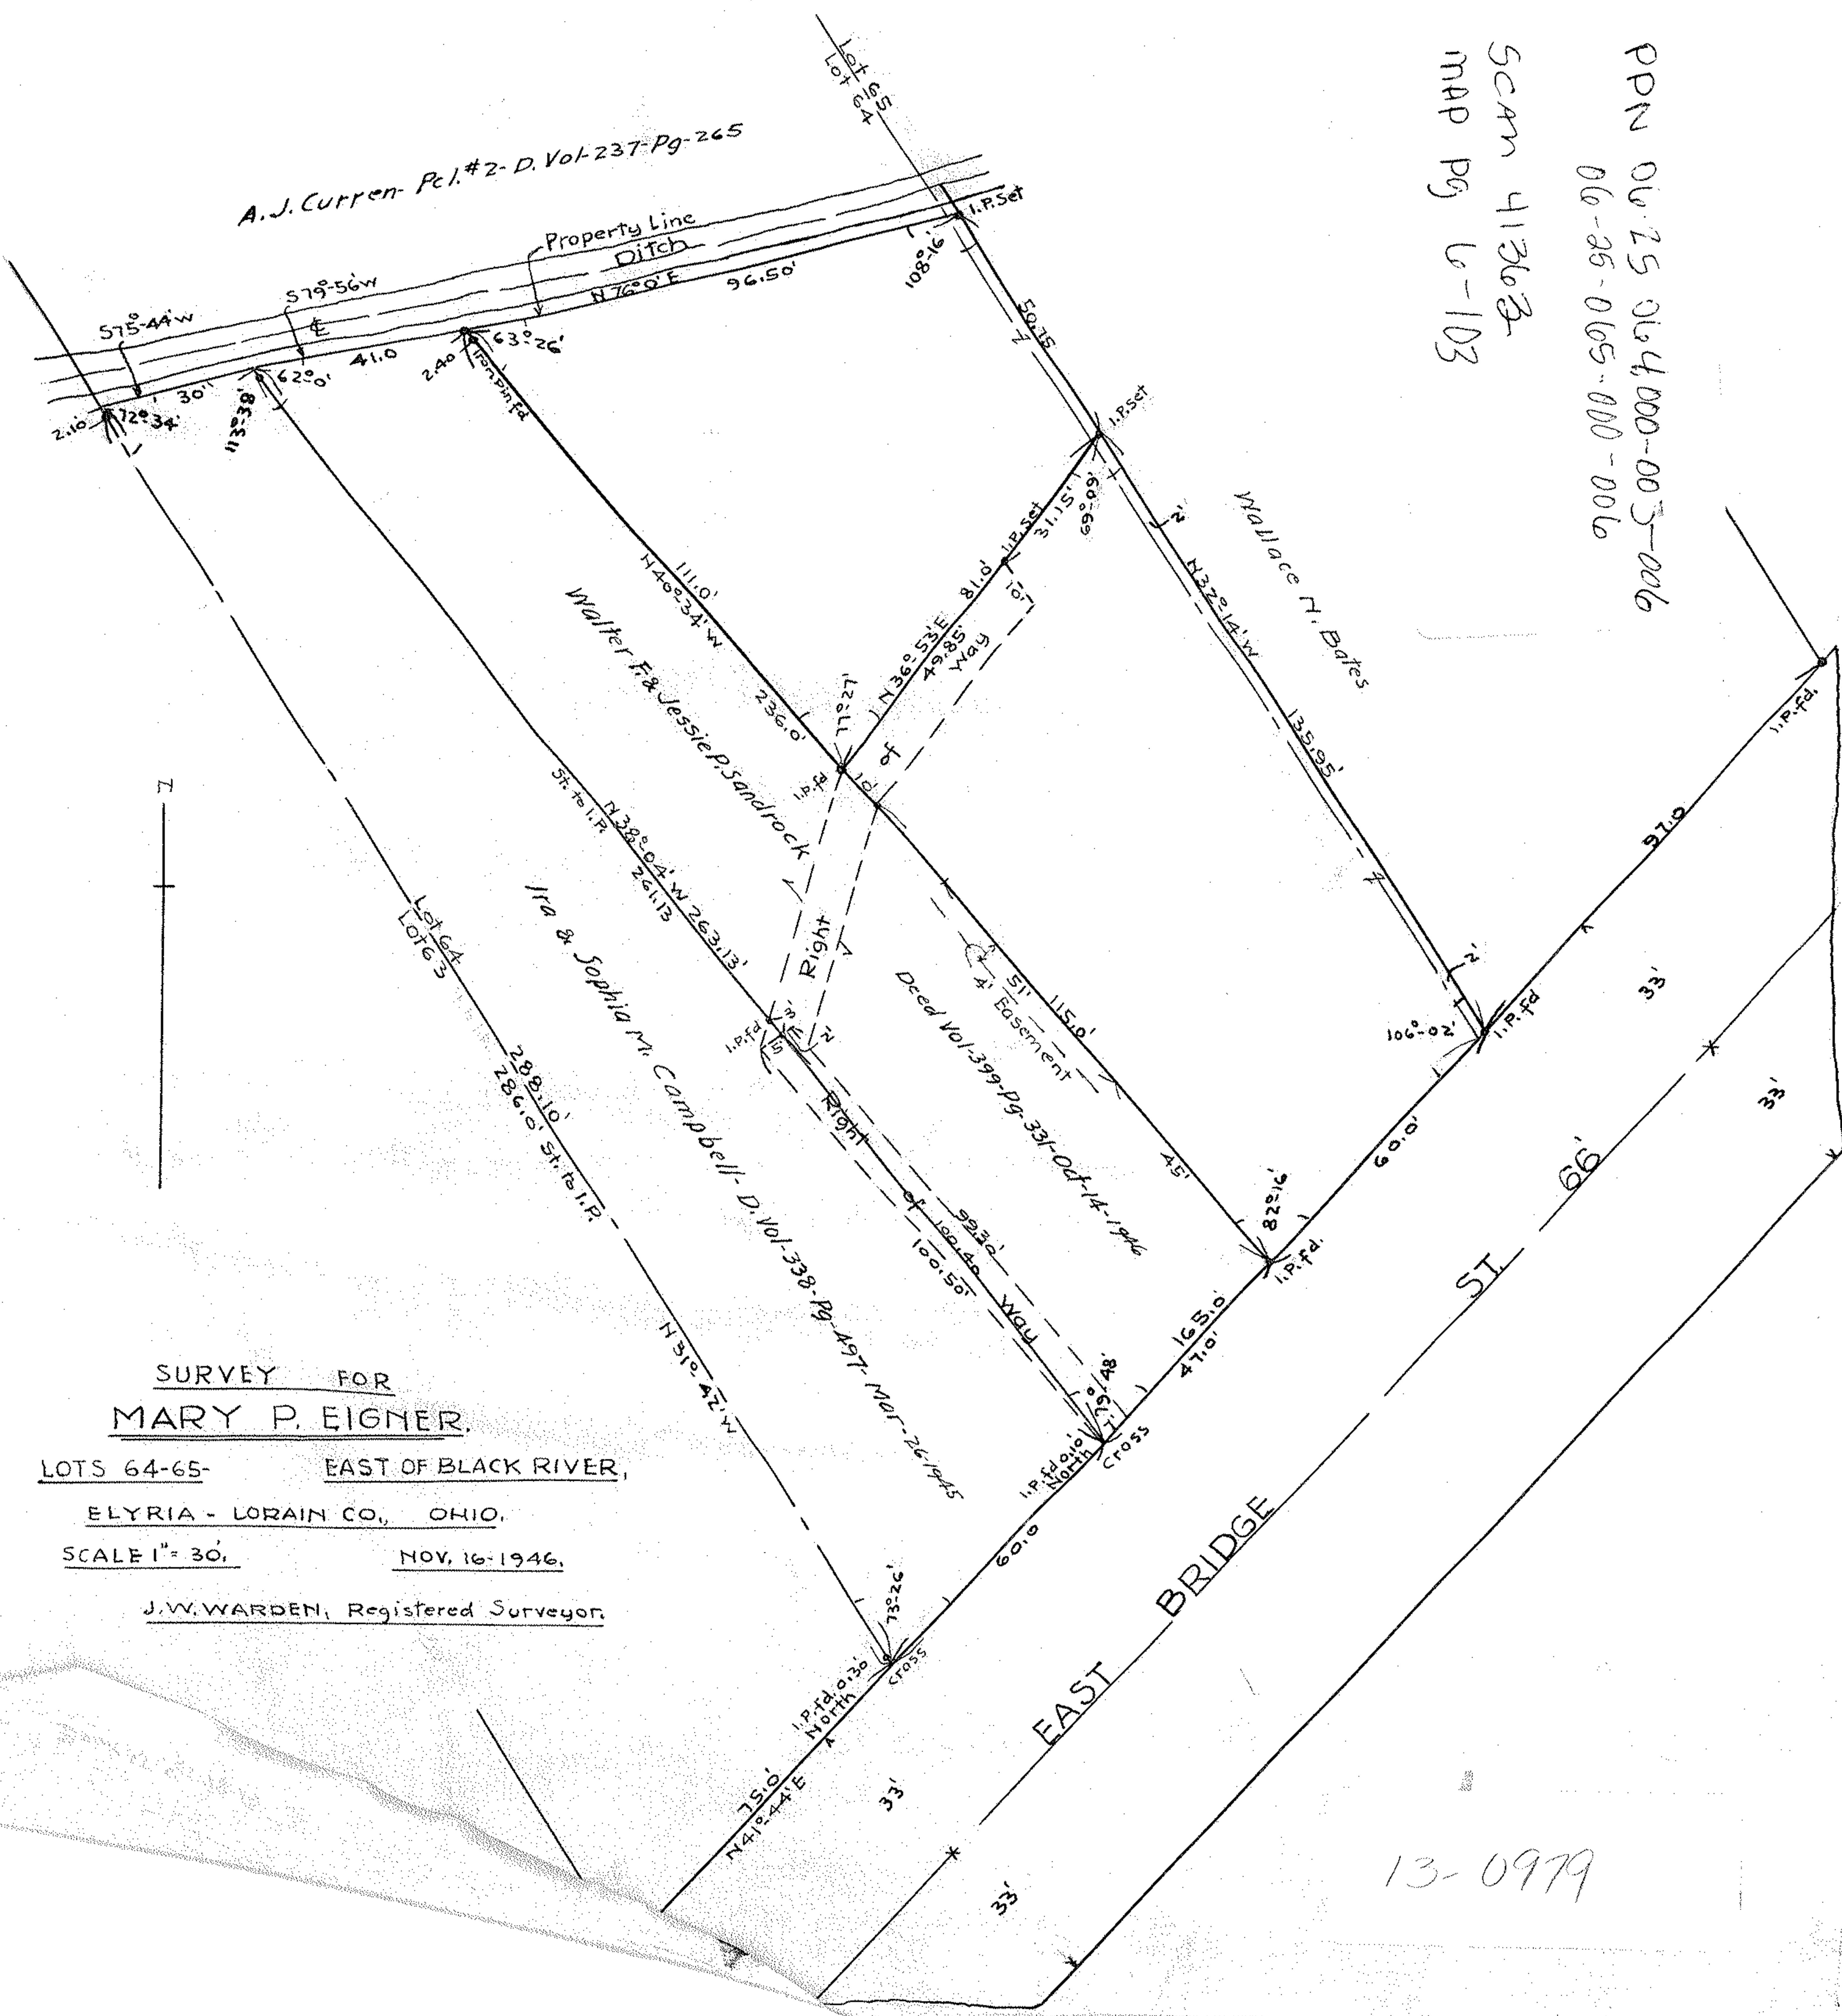

SURVEY FOR
MARY P. EIGNER.

LOTS 64-65- EAST OF BLACK RIVER,

ELYRIA - LORAIN CO., OHIO.

SCALE 1" = 30'

NOV. 16-1946.

J. W. WARDEN, Registered Surveyor.

13-0979