EXACTAOHIO
LAND SURVEYING
2132 E. 9TH STREET, SUITE 203
CLEVELAND, OHIO 44115
(216) 751-9000

BOUNDARY SURVEY

SITUATED IN THE CITY OF OBERLIN
COUNTY OF LORAIN, STATE OF OHIO
PART OF SUBLOT 60 OF ELIPHALET FOLLET'S ADDITION
IN ORIGINAL RUSSIA TOWNSHIP LOT 95
PLAT VOLUME 2 PAGE 1

ADDRESS
26 LINCOLN STREET
OBERLIN, OHIO 44074

RECORD
PARCEL NO. 09-00-095-106-029
SECRETARY OF HOUSING & URBAN DEVELOPMENT
DOCUMENT NO. 2008-0257809

BASIS OF BEARINGS
ASSUMED N90°00'00"W FOR LINCOLN STREET

30 0 15 30
GRAPHIC SCALE (In Feet)
1 inch = 30 ft.

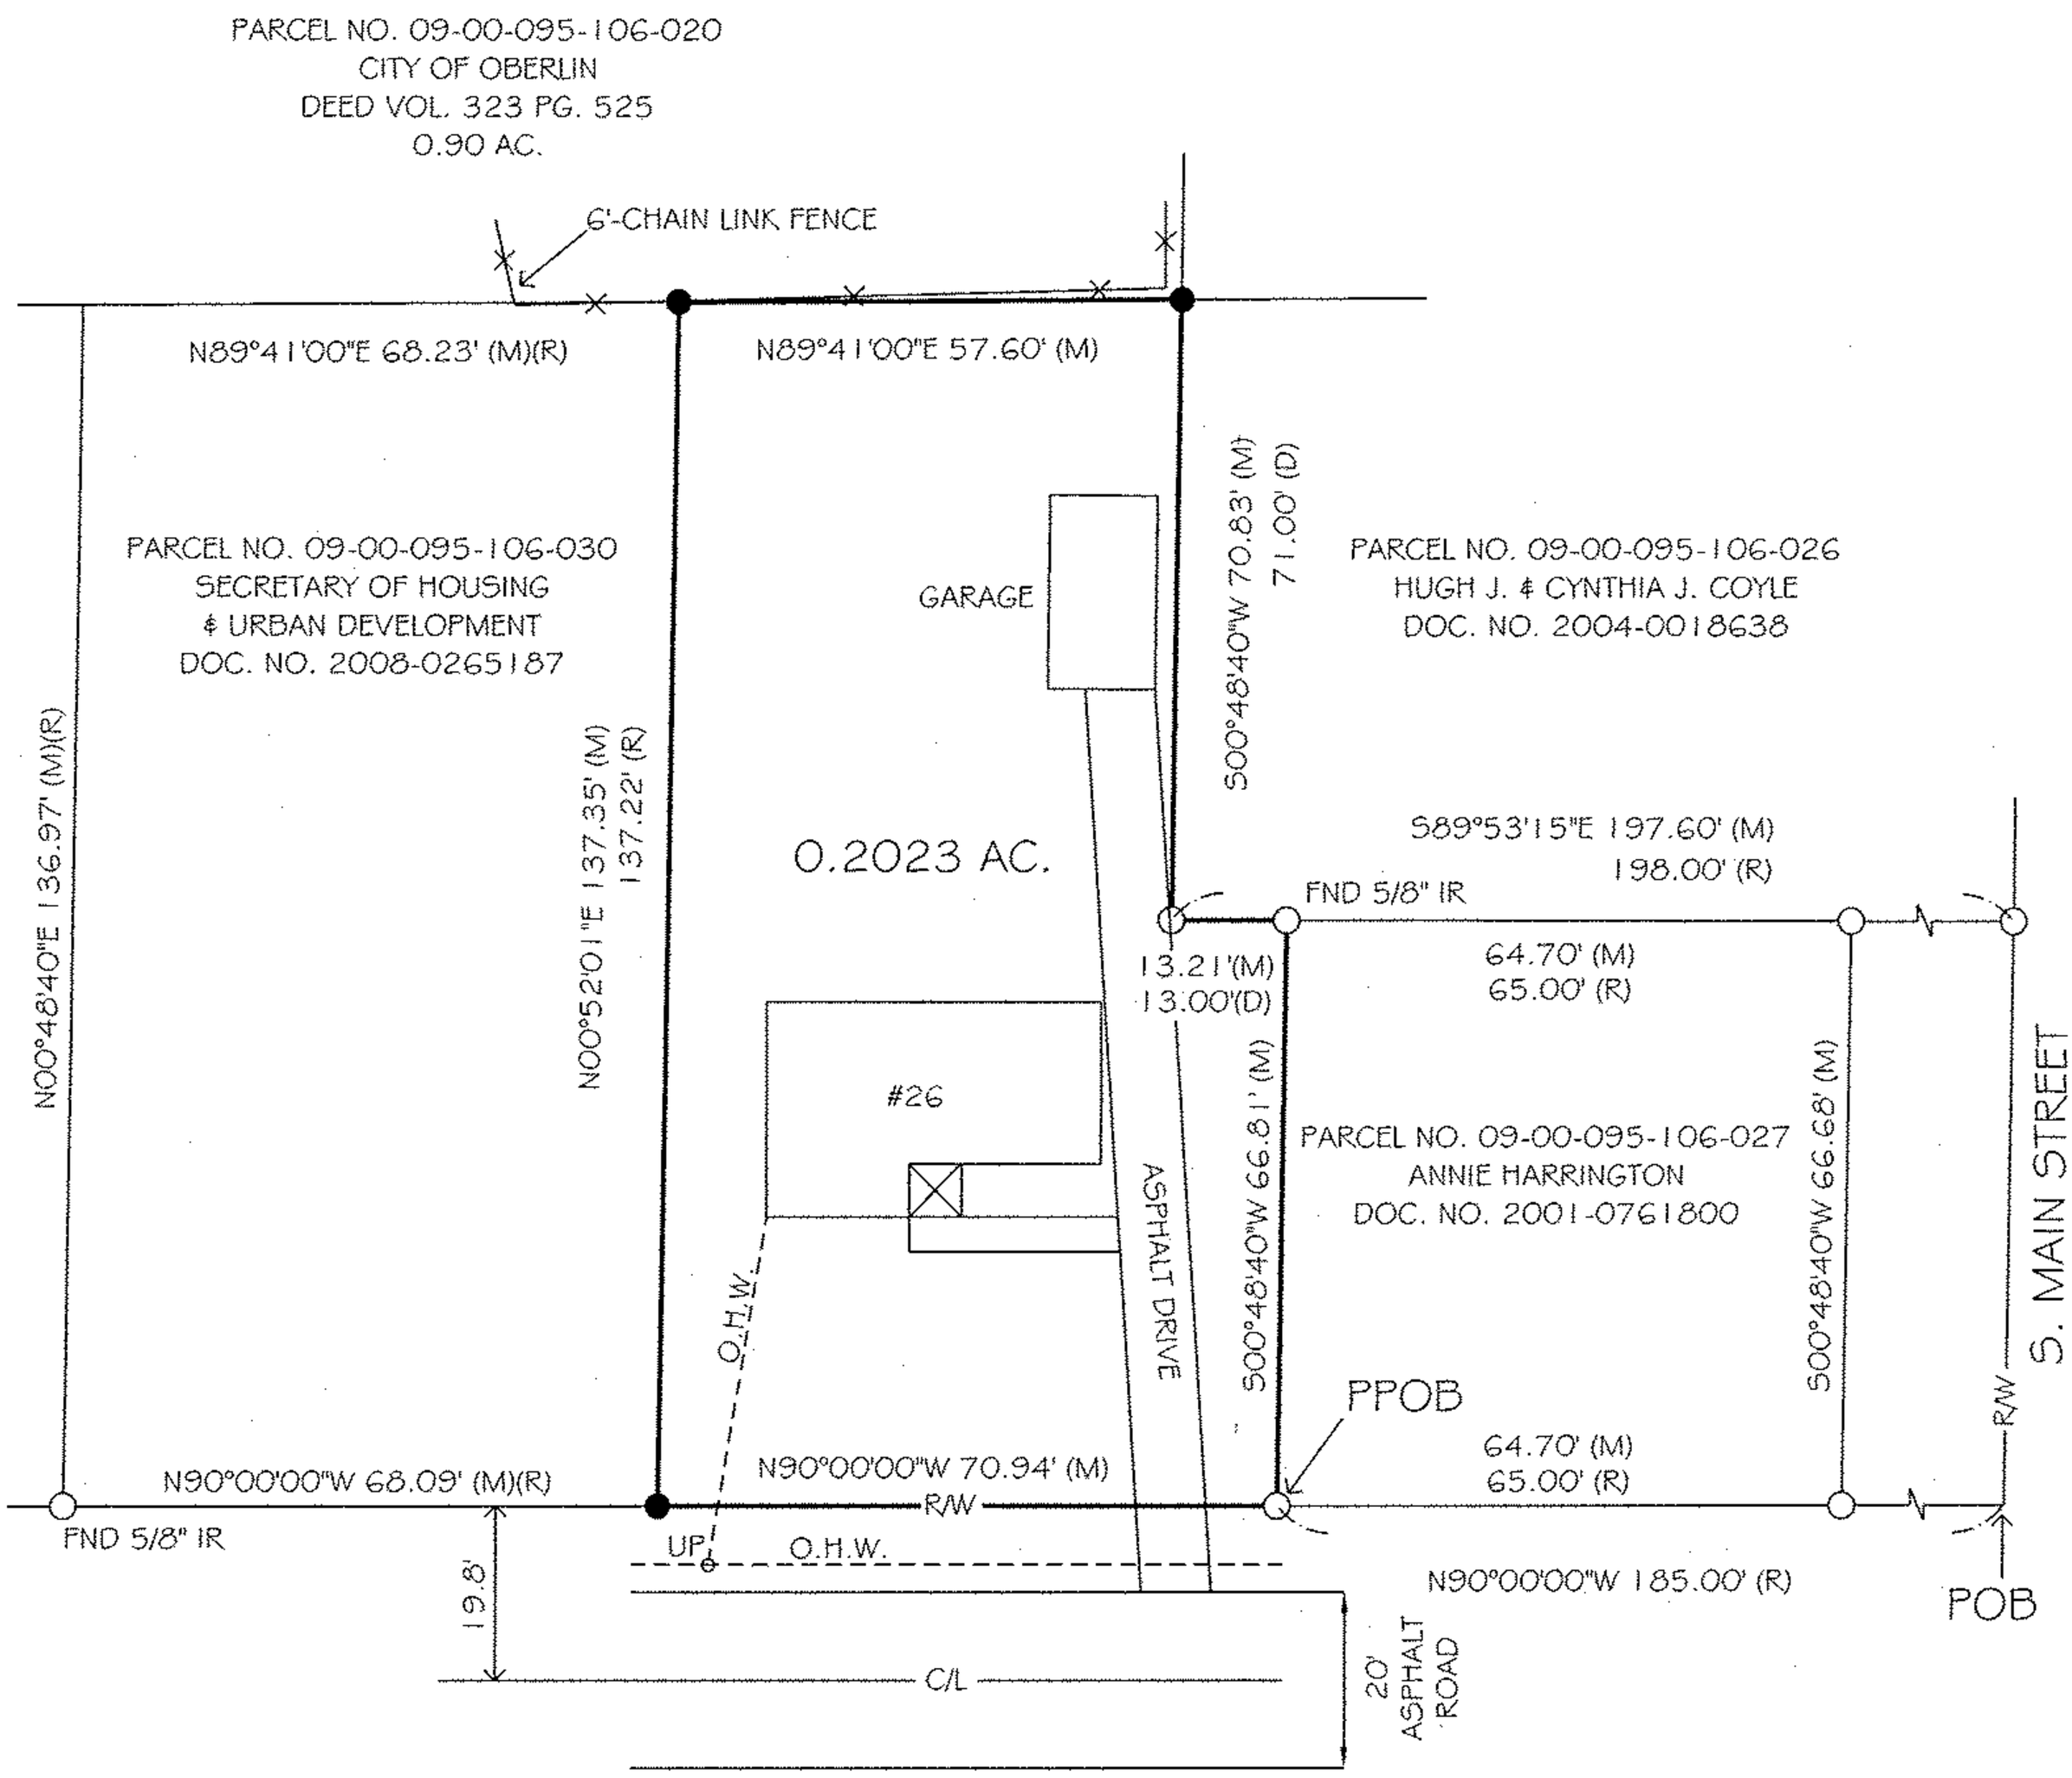

LEGEND
○ 1/2" IRON PIPE FOUND (UNLESS NOTED OTHERWISE)
● CAPPED 5/8", 30" LONG REBAR SET
POB PLACE OF BEGINNING
PPOB PRINCIPAL PLACE OF BEGINNING
(D) DEED
(R) RECORDED
(M) MEASURED
O.H.W. OVER HEAD WIRES
FENCE
○ UP UTILITY POLE

09-01785-D
APPROVED
LORAIN CO.
MAP DEPT
DATE 3/16/09
09-00-095-106-029
PAGE 09-00-095-B
BY D Holland
09-01785-D

NOTES
OCCUPATION IS CONSISTENT WITH TITLE LINES

DOCUMENTS USED ARE CITED ON THE PLAT

THE INTENT OF THIS SURVEY IS TO UPDATE THE DESCRIPTION OF AN EXISTING PARCEL

STATE OF OHIO
DALE R. HAYWOOD
S-8284
REGISTERED PROFESSIONAL SURVEYOR

DATE
FIELD: FEBRUARY 18, 2009
DRAWING: FEBRUARY 20, 2009

Dale Haywood
DALE HAYWOOD, P.S.
OHIO REG. S-8284

09-690