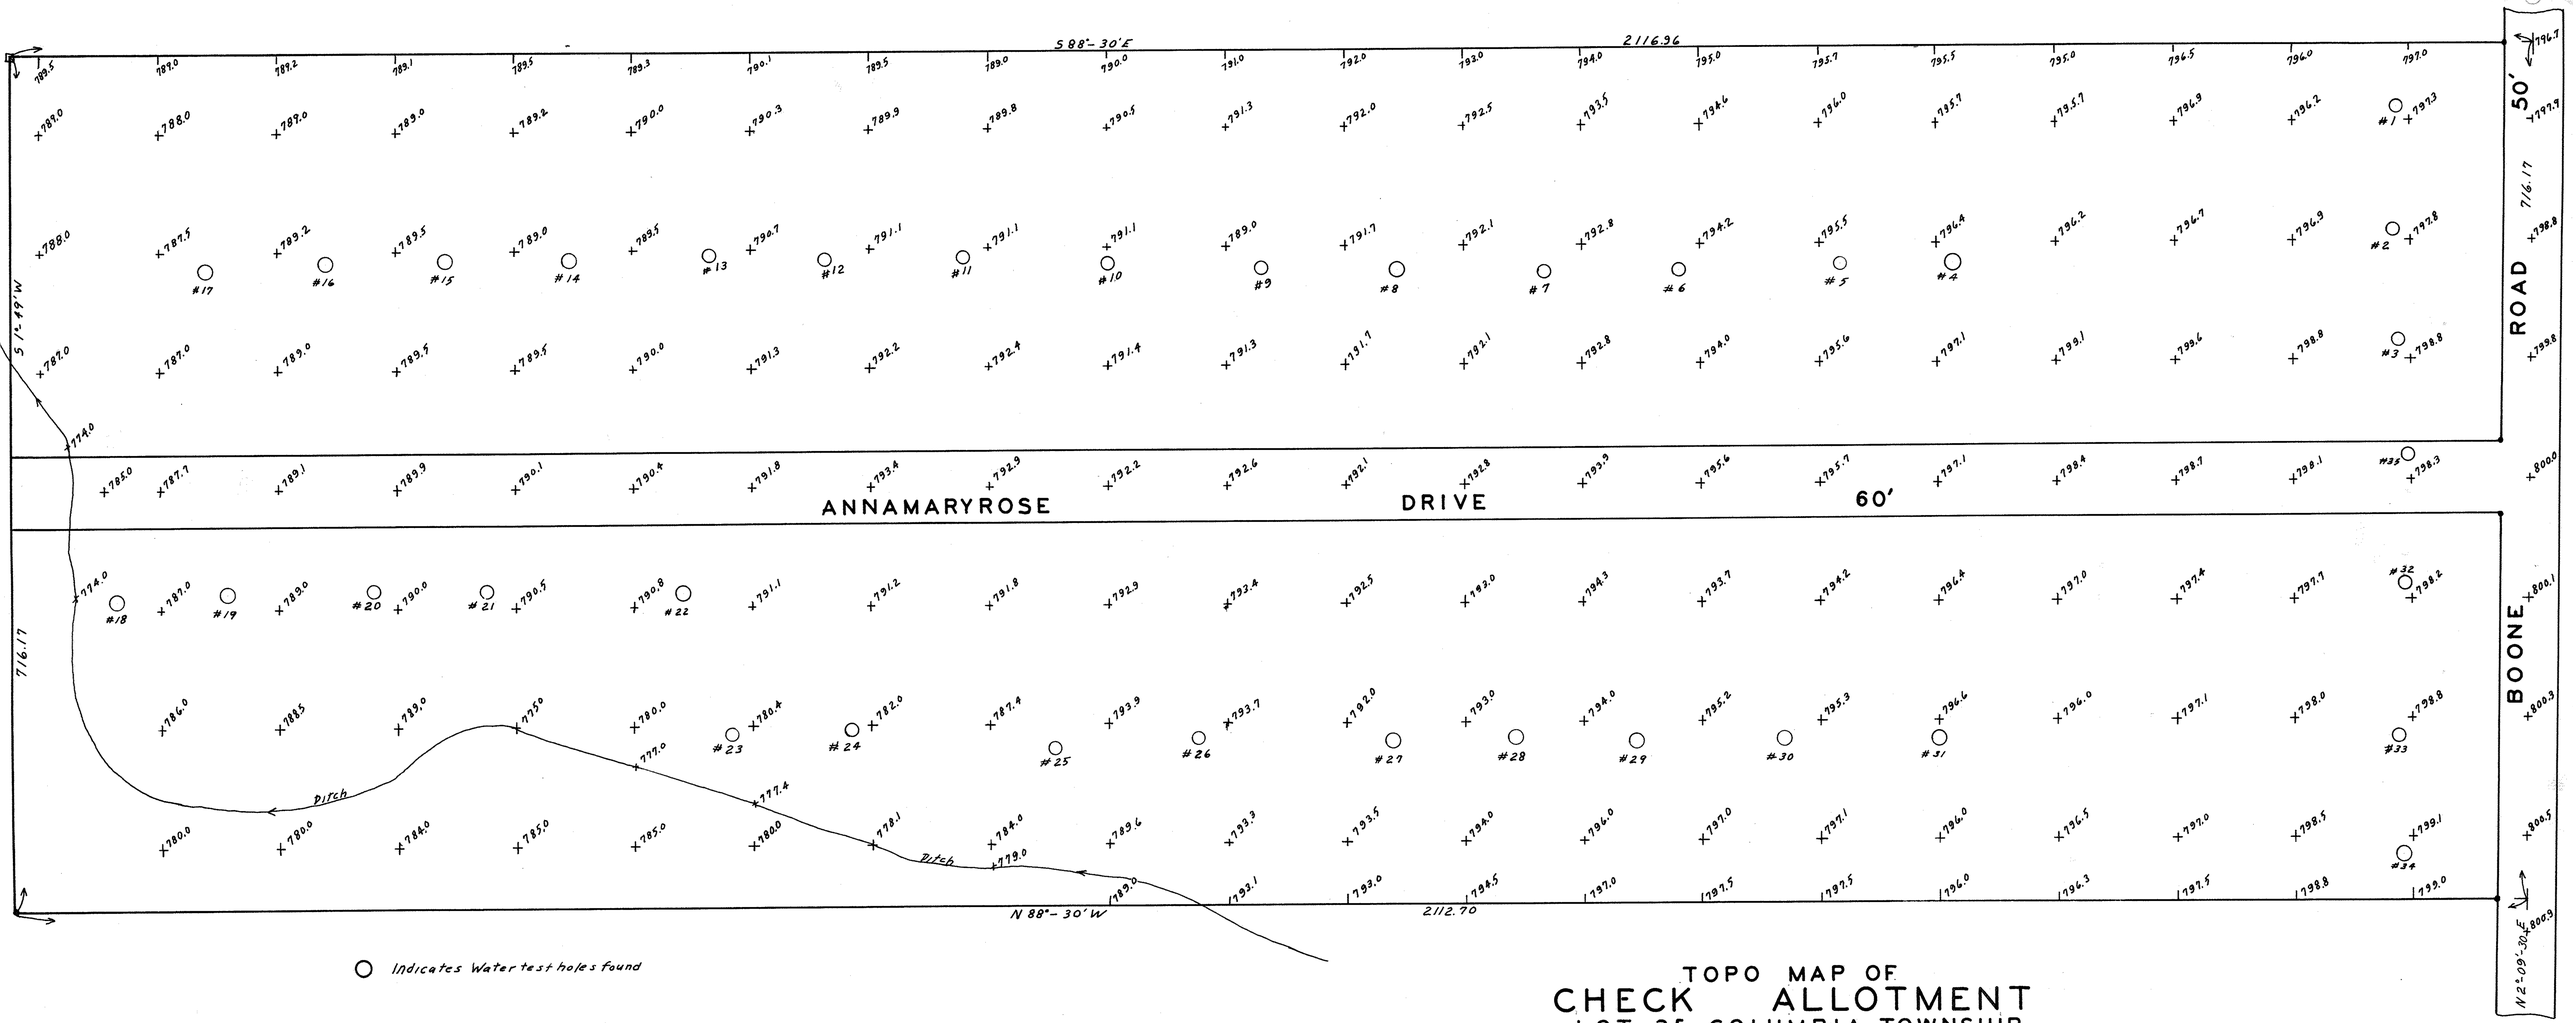

TOPO MAP OF
CHECK ALLOTMENT
LOT 25 COLUMBIA TOWNSHIP
LORAIN COUNTY OHIO
SCALE 1" = 60' JULY 29, 1954
J. W. WARDEN AND ASSOCIATES, REG. SURVEYOR'S

PPN 12-00-025-000-???
009-041

map pg 12-00-025-A