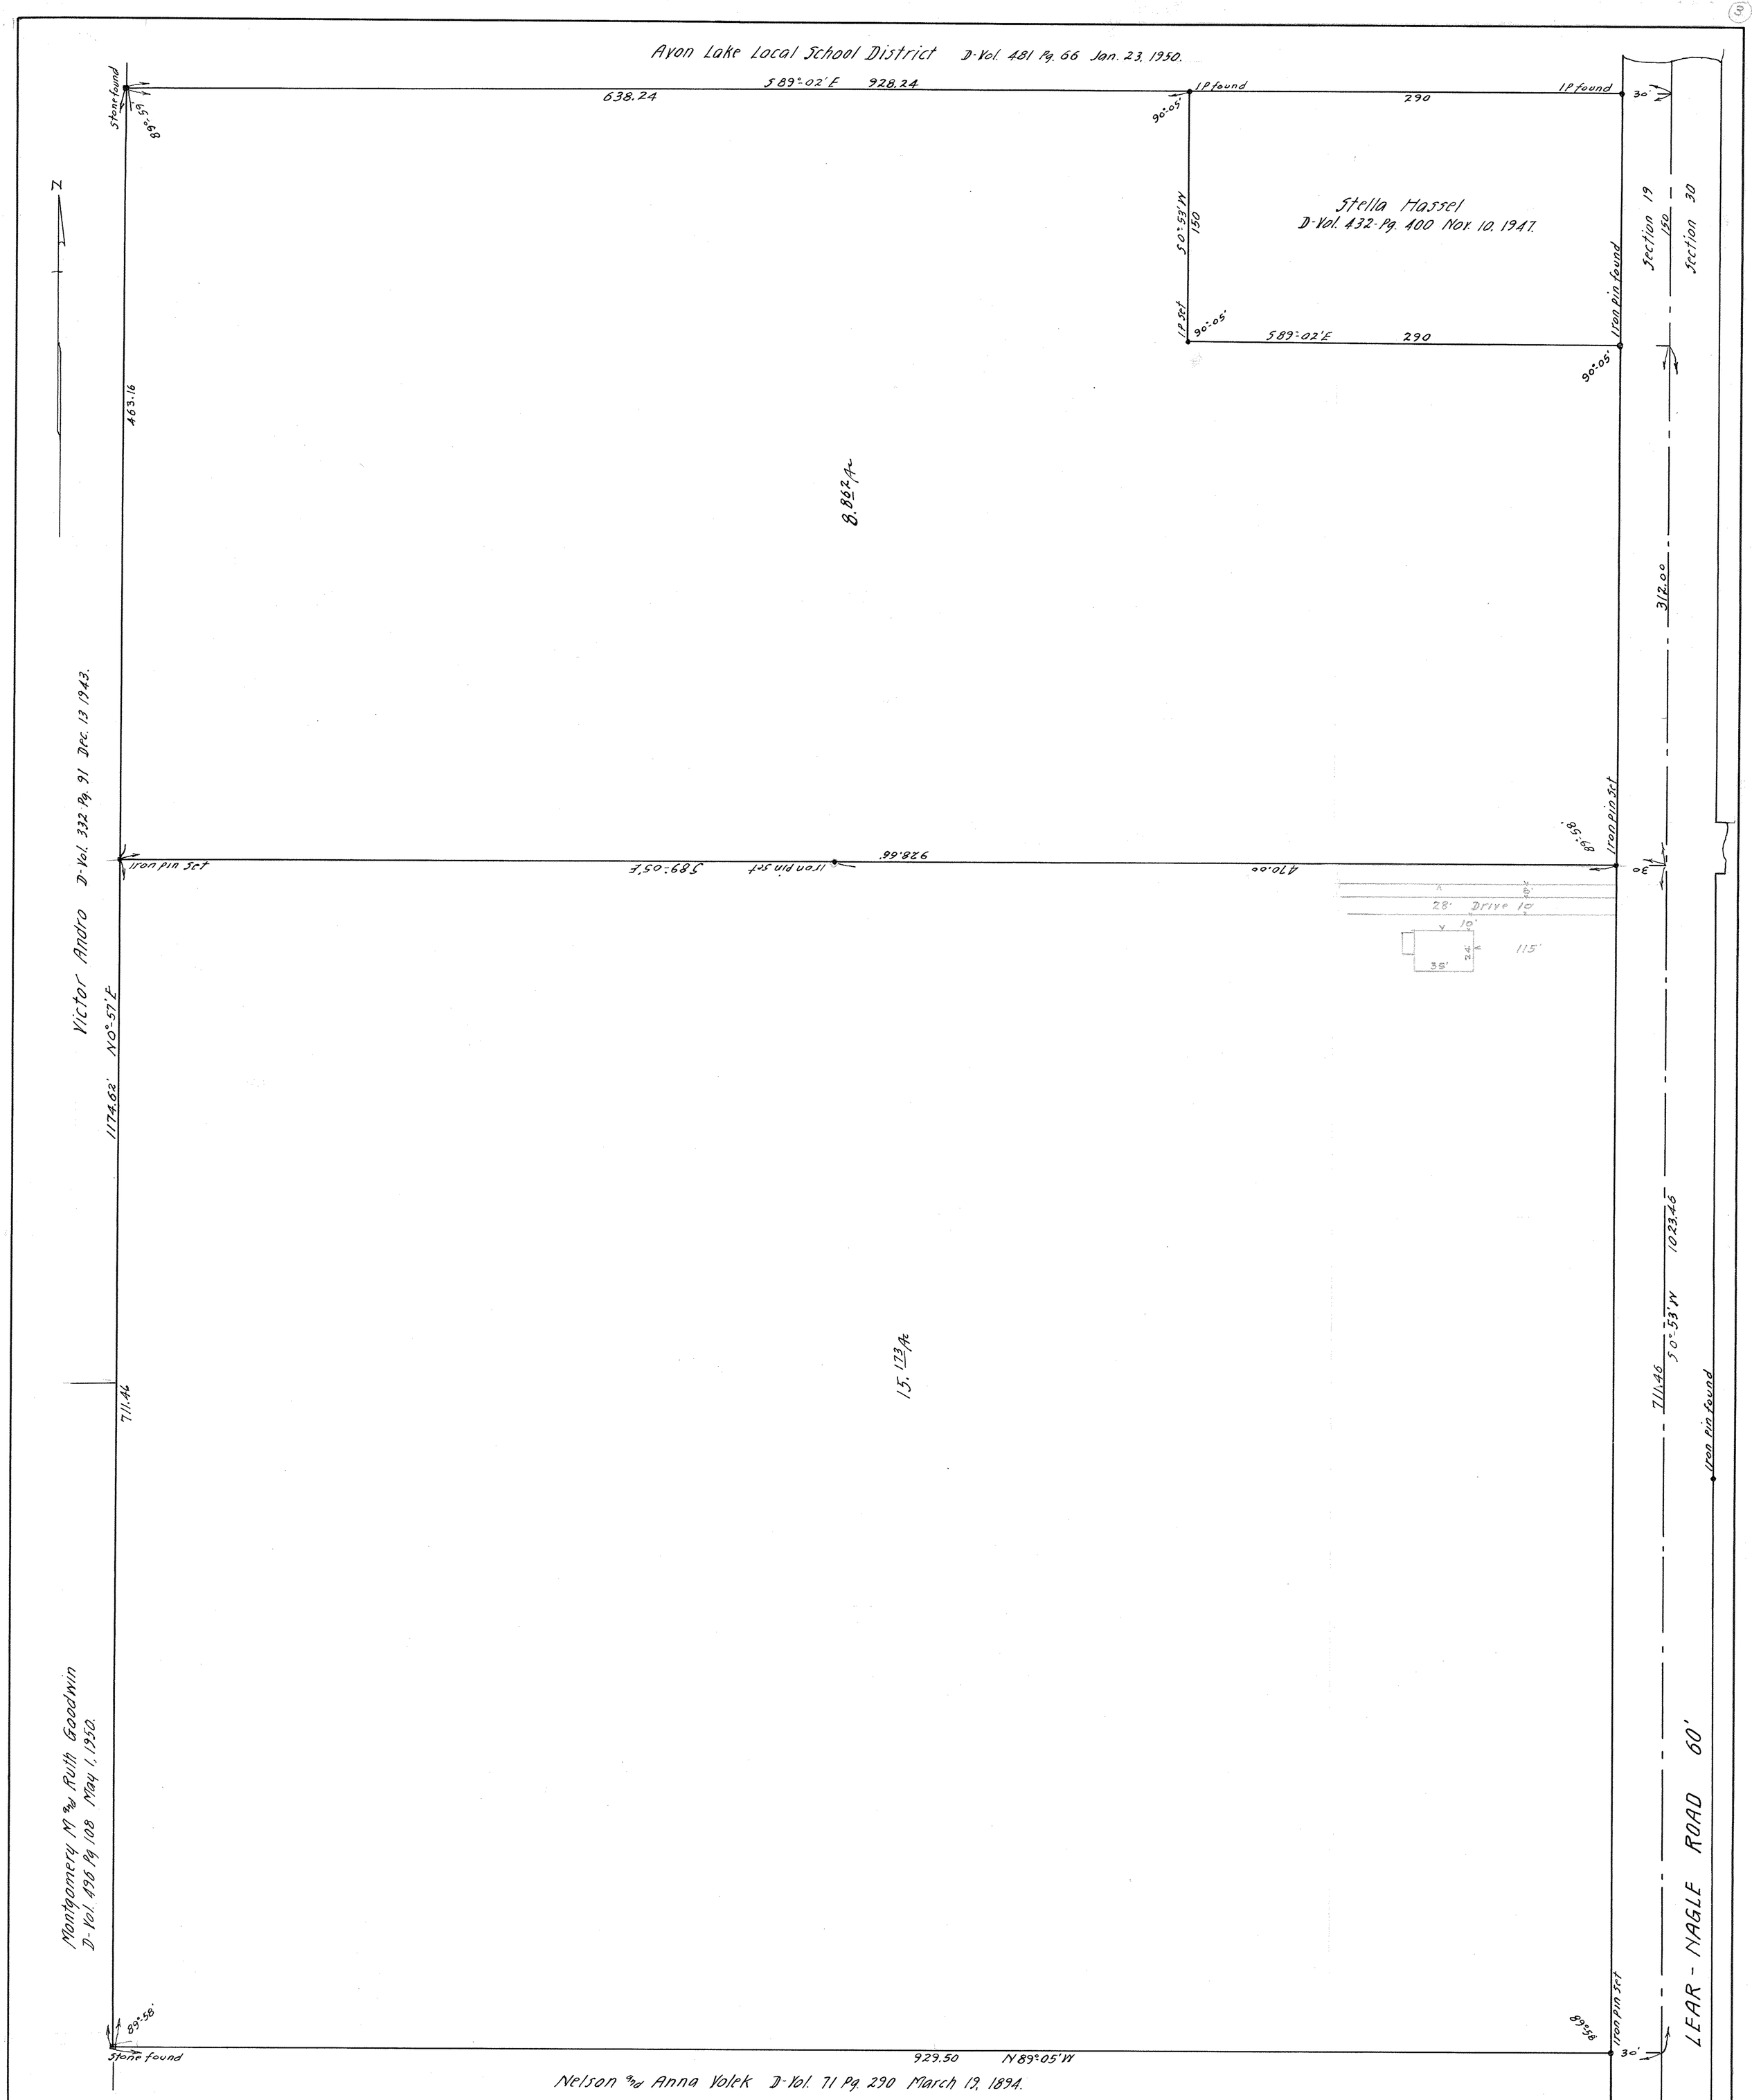

Survey for
BEN and JENNIE FREY
D-Vol. 256 Pg 166 July 19 1930 24.035 Ac
Section 19 Avon Lake Village
Scale 1" = 40' June 18, 1951.
J. W. Warden and Associates Surveyors.
Revised Sept. 17, 1952.

PPN 04-00-019 ~~000-000~~ 114-025
Vonhanes Subdivision
MAP pg 4-00-019-H

Pell-134