12 10 30 A

Survey for
EDWARD and MARY GROBOSKE
D-Vol. 134 Pg. 481 Apr. 22. 1915.
Lot 20 Fowler Addn. to Grafton Village
Map. Vol. 1-Pg 24
Original Lot 81 Eaton Township
Lorain County Ohio.
Scale 1" = 40' July 28 1947
J. W. Warden. Registered Surveyor.

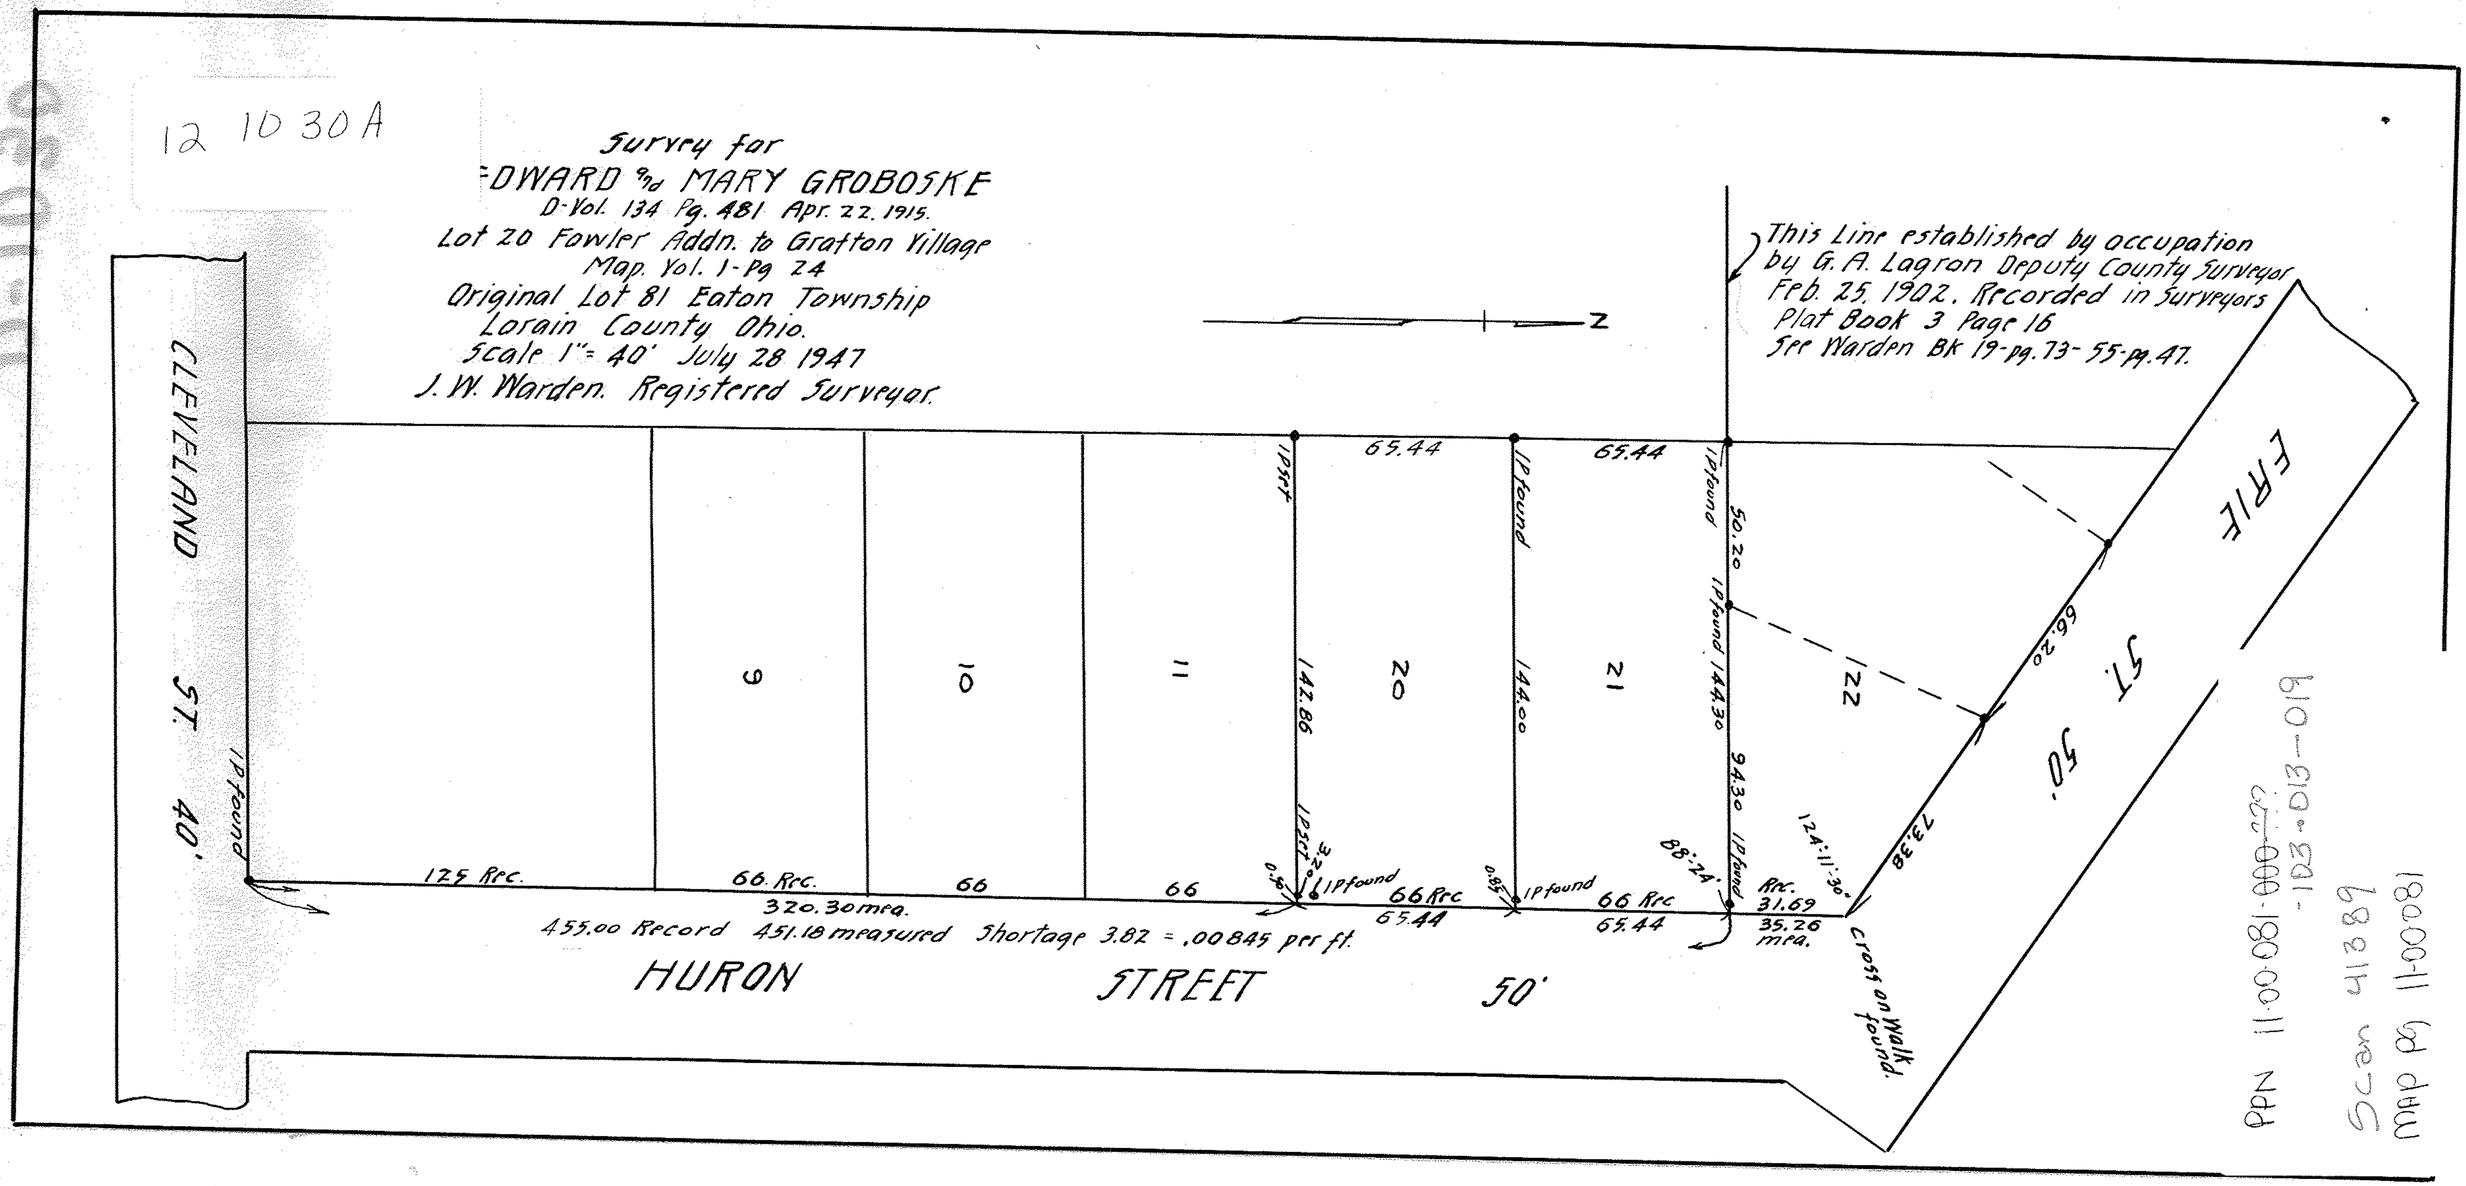

PPN 11-00-081-~~000-222~~
-103-013-019
Scan 41389
Map Pg 11-00081