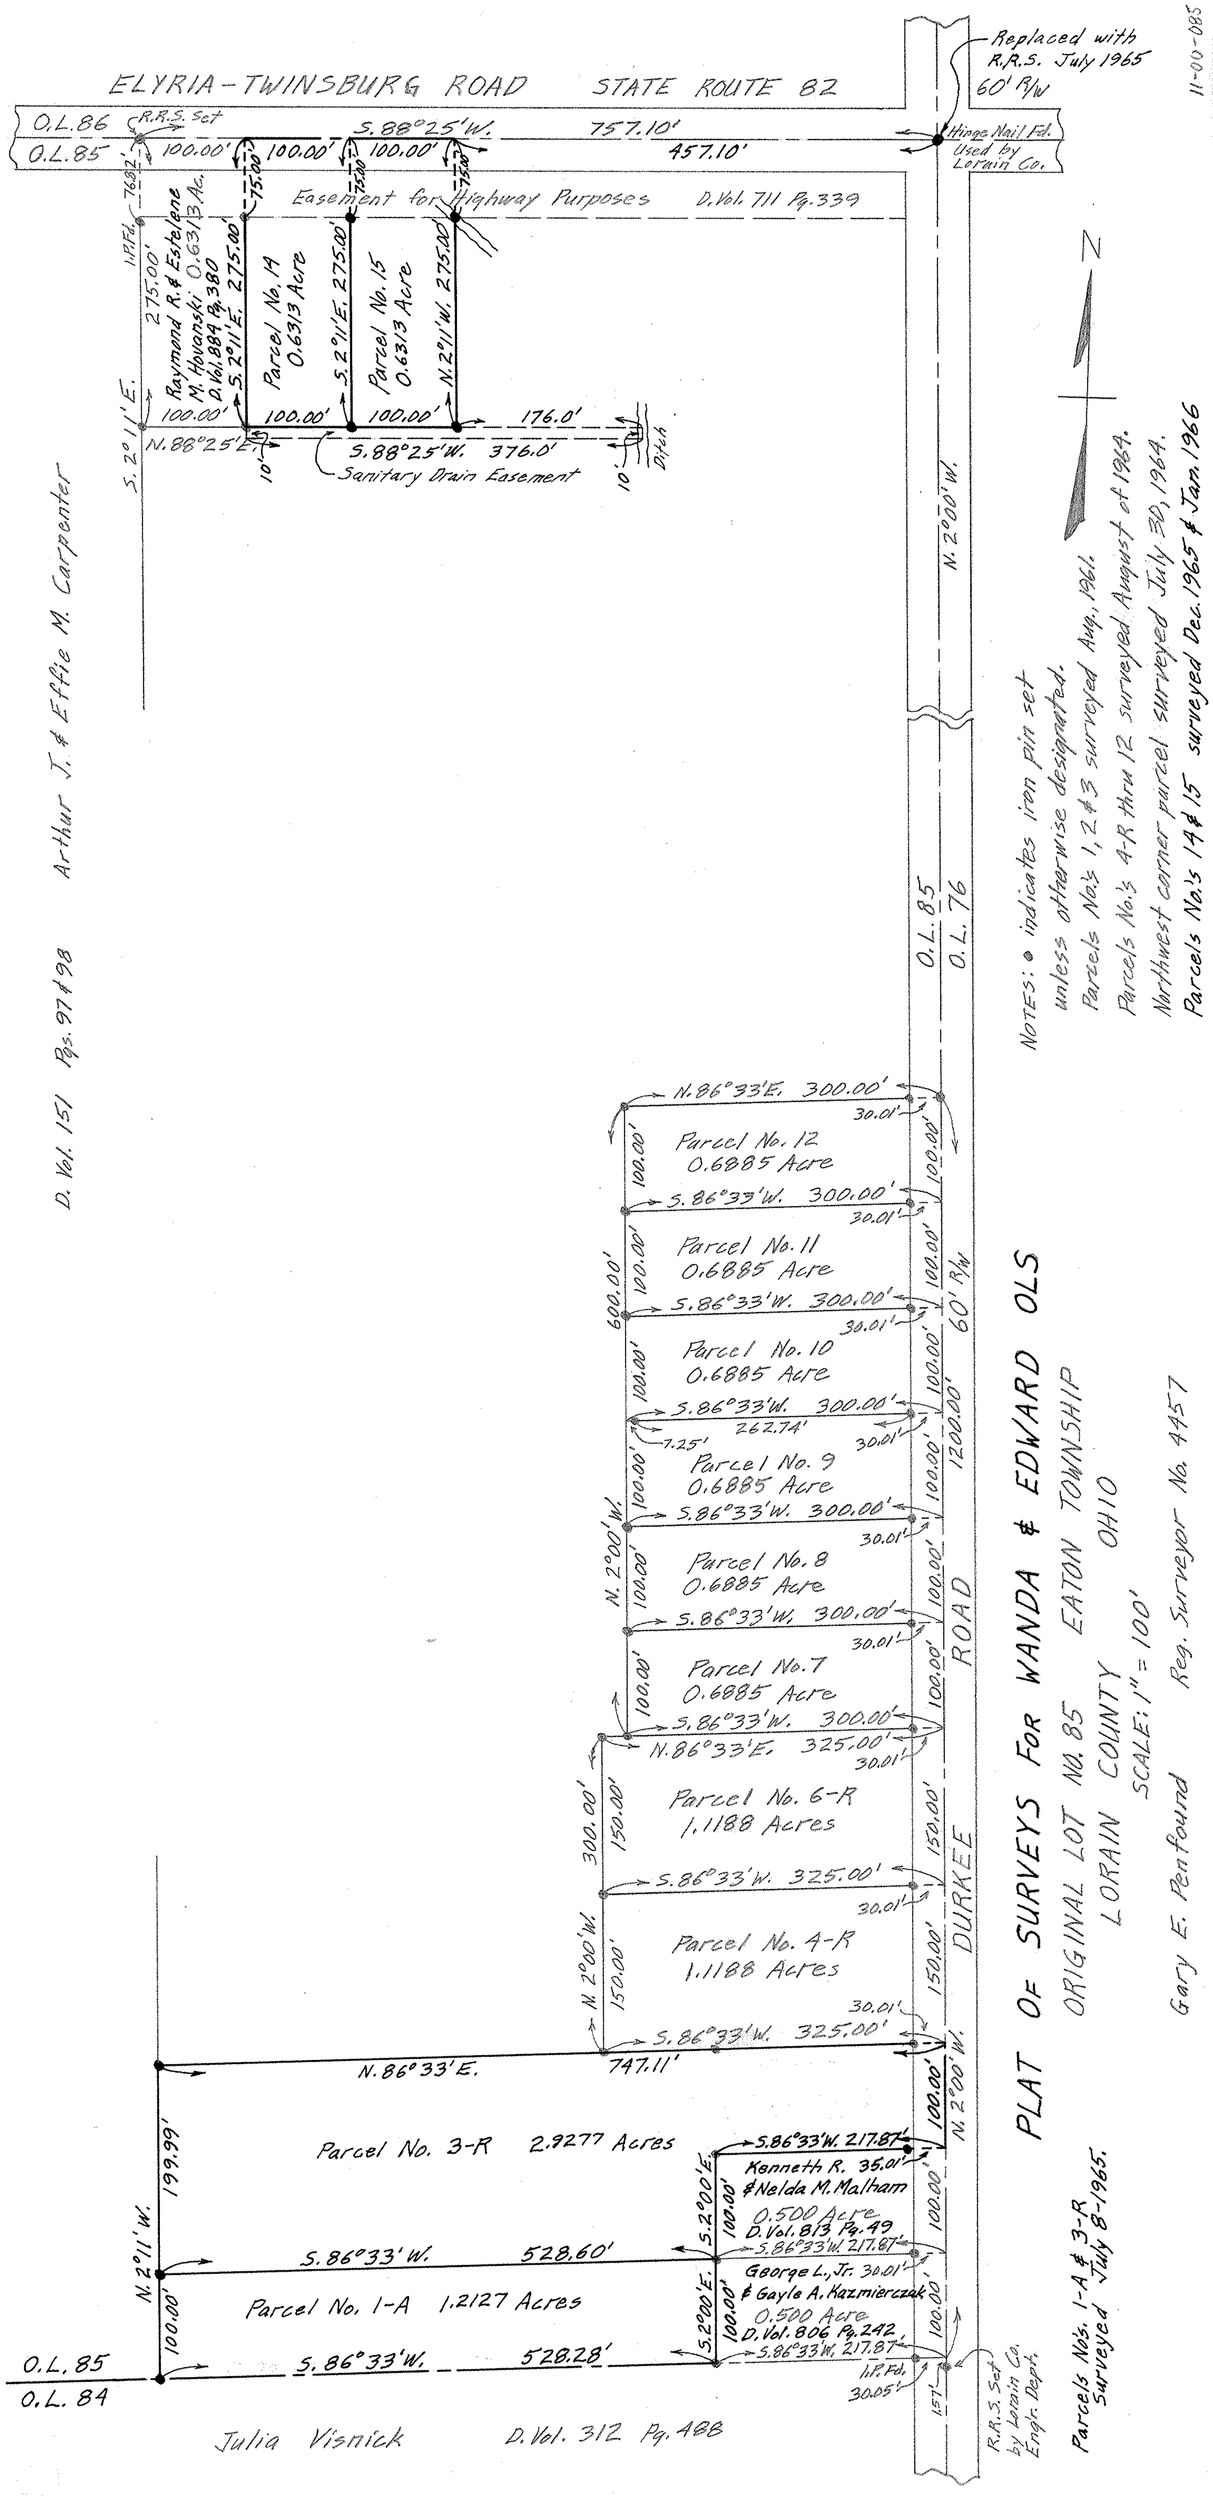
ELYRIA-TWINSBURG ROAD STATE ROUTE 82
Replaced with R.R.S. July 1965
60' R/W
O.L. 86
O.L. 85
R.R.S. Set
S. 88°25'W. 757.10'
457.10'
Hinge Nail Fd. Used By Lorain Co.
100.00'
Easement for Highway Purposes D. Vol. 711 Pg. 339
Raymond R. & Estelene M. Hovanski 0.63/3 Ac. D. Vol. 884 Pg. 380
Parcel No. 14 0.63/3 Acre
Parcel No. 15 0.63/3 Acre
S. 2°11'E. 275.00'
N. 2°11'W. 275.00'
176.0'
N. 88°25'E.
S. 88°25'W. 376.0'
Sanitary Drain Easement
Ditch
Arthur J. & Effie M. Carpenter
D. Vol. 151 Pgs. 97 & 98
N. 2°00'W.
O.L. 85
O.L. 76
N. 86°33'E. 300.00'
Parcel No. 12 0.6885 Acre
S. 86°33'W. 300.00'
Parcel No. 11 0.6885 Acre
Parcel No. 10 0.6885 Acre
262.74'
7.25'
Parcel No. 9 0.6885 Acre
Parcel No. 8 0.6885 Acre
Parcel No. 7 0.6885 Acre
600.00'
1200.00'
60' R/W
ROAD
DURKEE
N. 86°33'E. 325.00'
Parcel No. 6-R 1.1188 Acres
Parcel No. 4-R 1.1188 Acres
300.00'
150.00'
747.11'
Parcel No. 3-R 2.9277 Acres
199.99'
N. 2°11'W.
S. 86°33'W. 528.60'
Parcel No. 1-A 1.2127 Acres
528.28'
O.L. 85
O.L. 84
Julia Visnick D. Vol. 312 Pg. 488
S. 86°33'W. 217.87'
Kenneth R. & Nelda M. Malham 0.500 Acre D. Vol. 813 Pg. 49
George L., Jr. & Gayle A. Kazmierczak 0.500 Acre D. Vol. 806 Pg. 242
I.P. Fd.
R.R.S. Set by Lorain Co. Engr. Dept.
N
NOTES: ● indicates iron pin set unless otherwise designated.
Parcels No's 1, 2 & 3 surveyed Aug. 1961.
Parcels No's 4-R thru 12 surveyed August of 1964.
Northwest corner parcel surveyed July 30, 1964.
Parcels No's 14 & 15 surveyed Dec. 1965 & Jan 1966
PLAT OF SURVEYS FOR WANDA & EDWARD OLS
ORIGINAL LOT NO. 85 EATON TOWNSHIP
LORAIN COUNTY OHIO
SCALE: 1" = 100'
Gary E. Penfound Reg. Surveyor No. 4457
Parcels No's. 1-A & 3-R Surveyed July 8-1965.
11-00-085