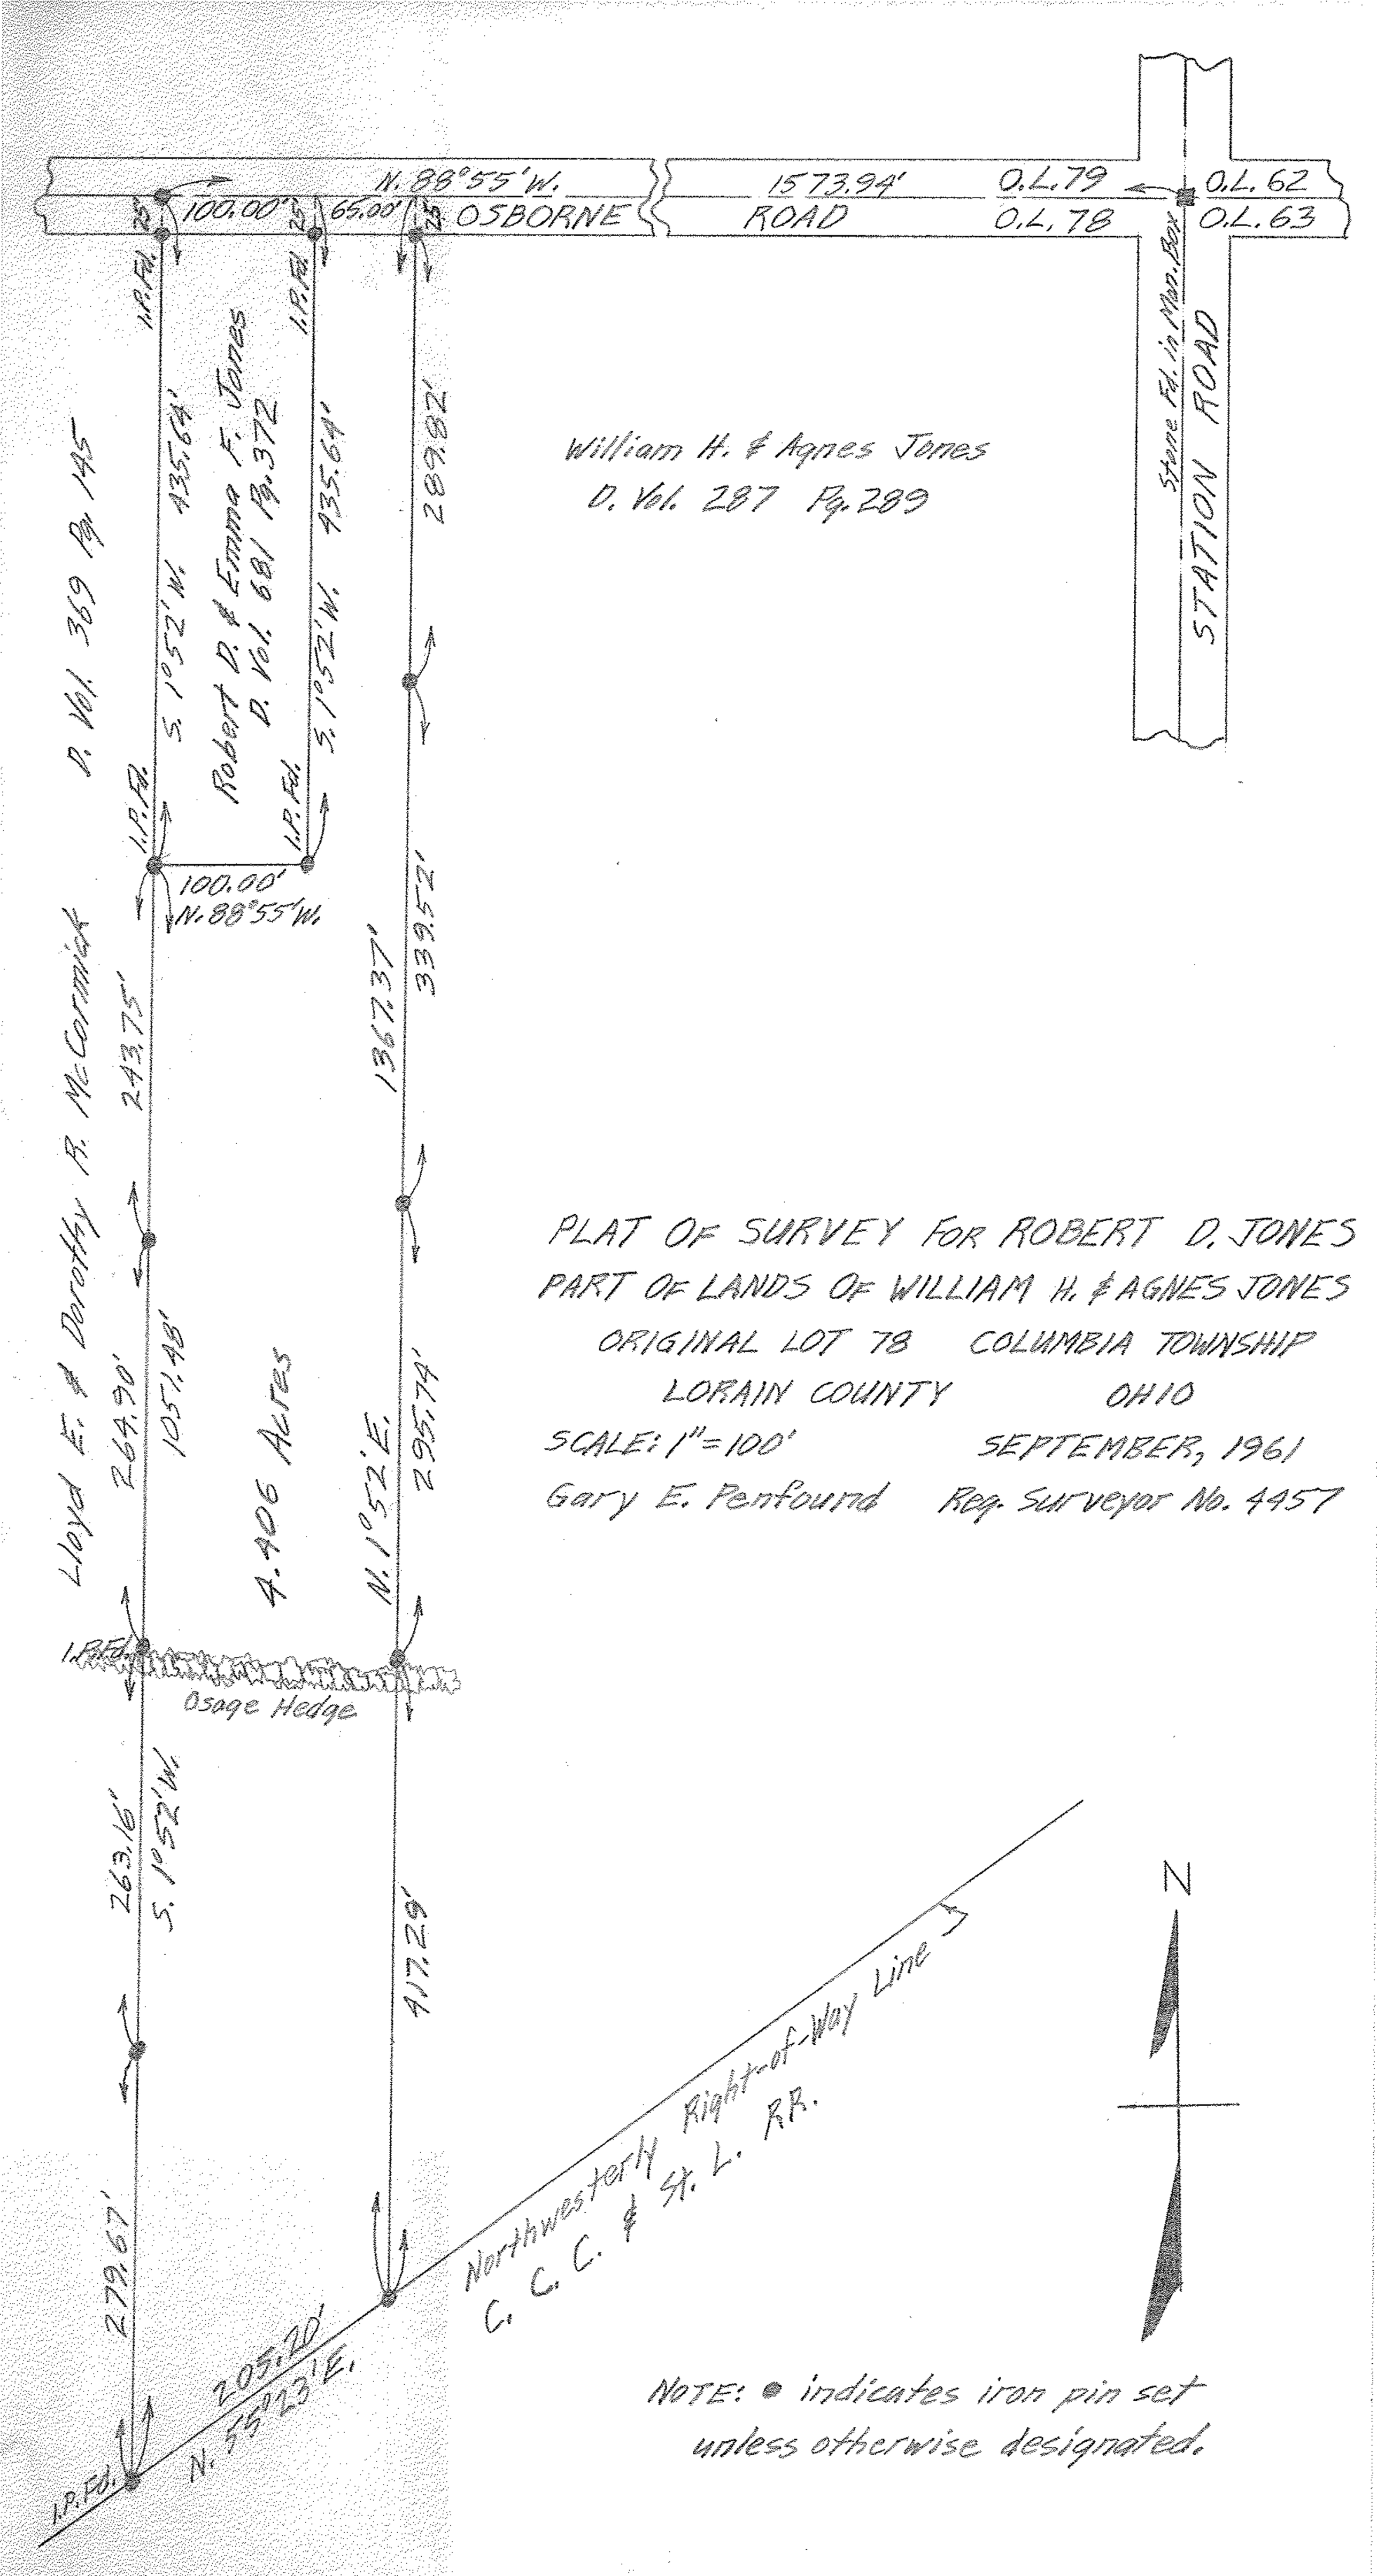

PLAT OF SURVEY FOR ROBERT D. JONES
PART OF LANDS OF WILLIAM H. & AGNES JONES
ORIGINAL LOT 78 COLUMBIA TOWNSHIP
LORAIN COUNTY OHIO
SCALE: 1" = 100' SEPTEMBER, 1961
Gary E. Penfound Reg. Surveyor No. 4457

NOTE: ● indicates iron pin set unless otherwise designated.