PLAT OF SURVEYS FOR
RUDOLPH & IRIS POGACSNIK

ORIGINAL LOT NO. 65 LAGRANGE TOWNSHIP
LORAIN COUNTY OHIO
SCALE: 1" = 100' FEBRUARY – MARCH 1976
Gary E. Penfound Reg. Surveyor No. 4457
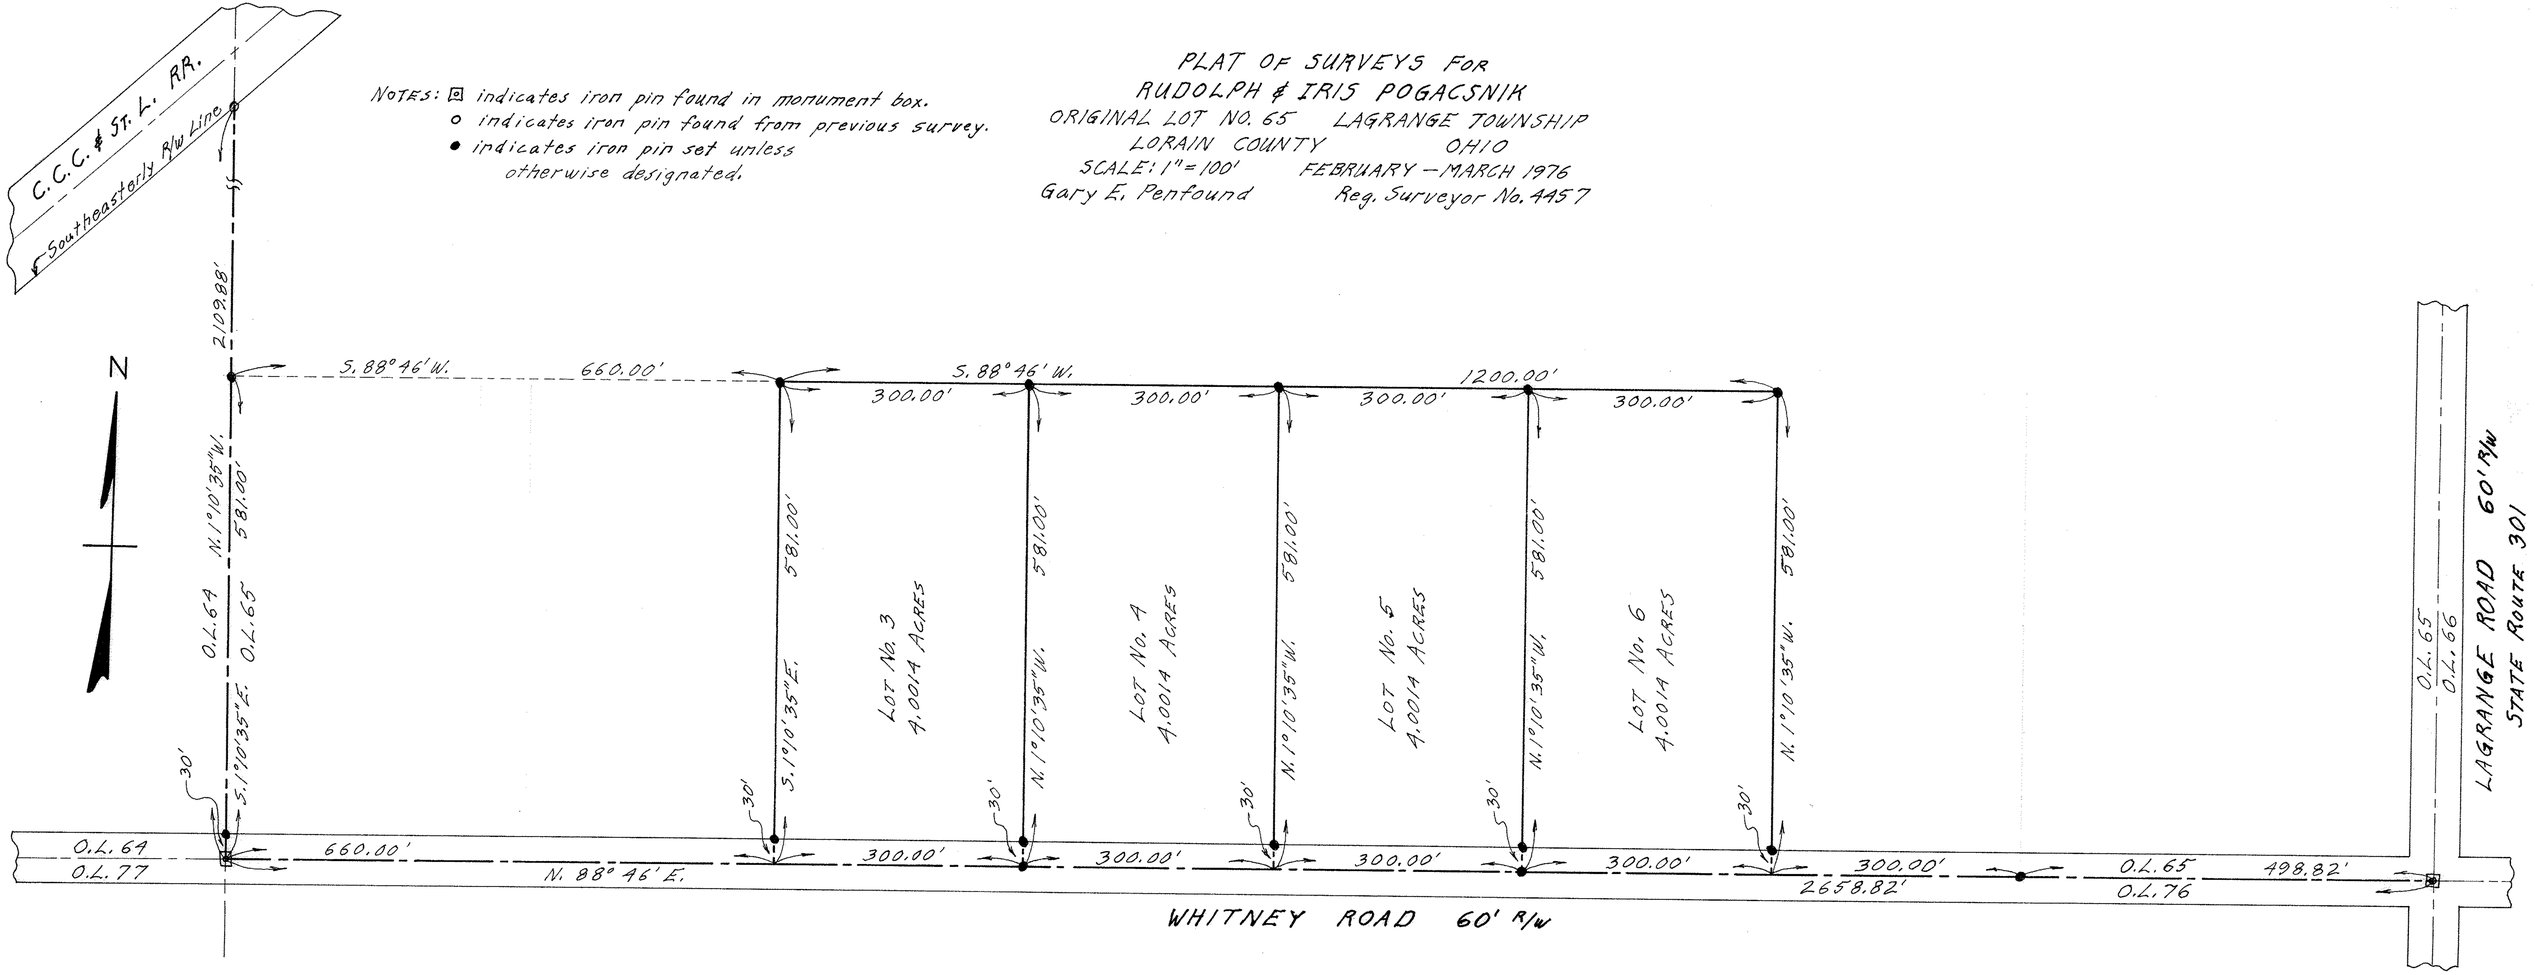
NOTES: ⊡ indicates iron pin found in monument box.
o indicates iron pin found from previous survey.
● indicates iron pin set unless otherwise designated.