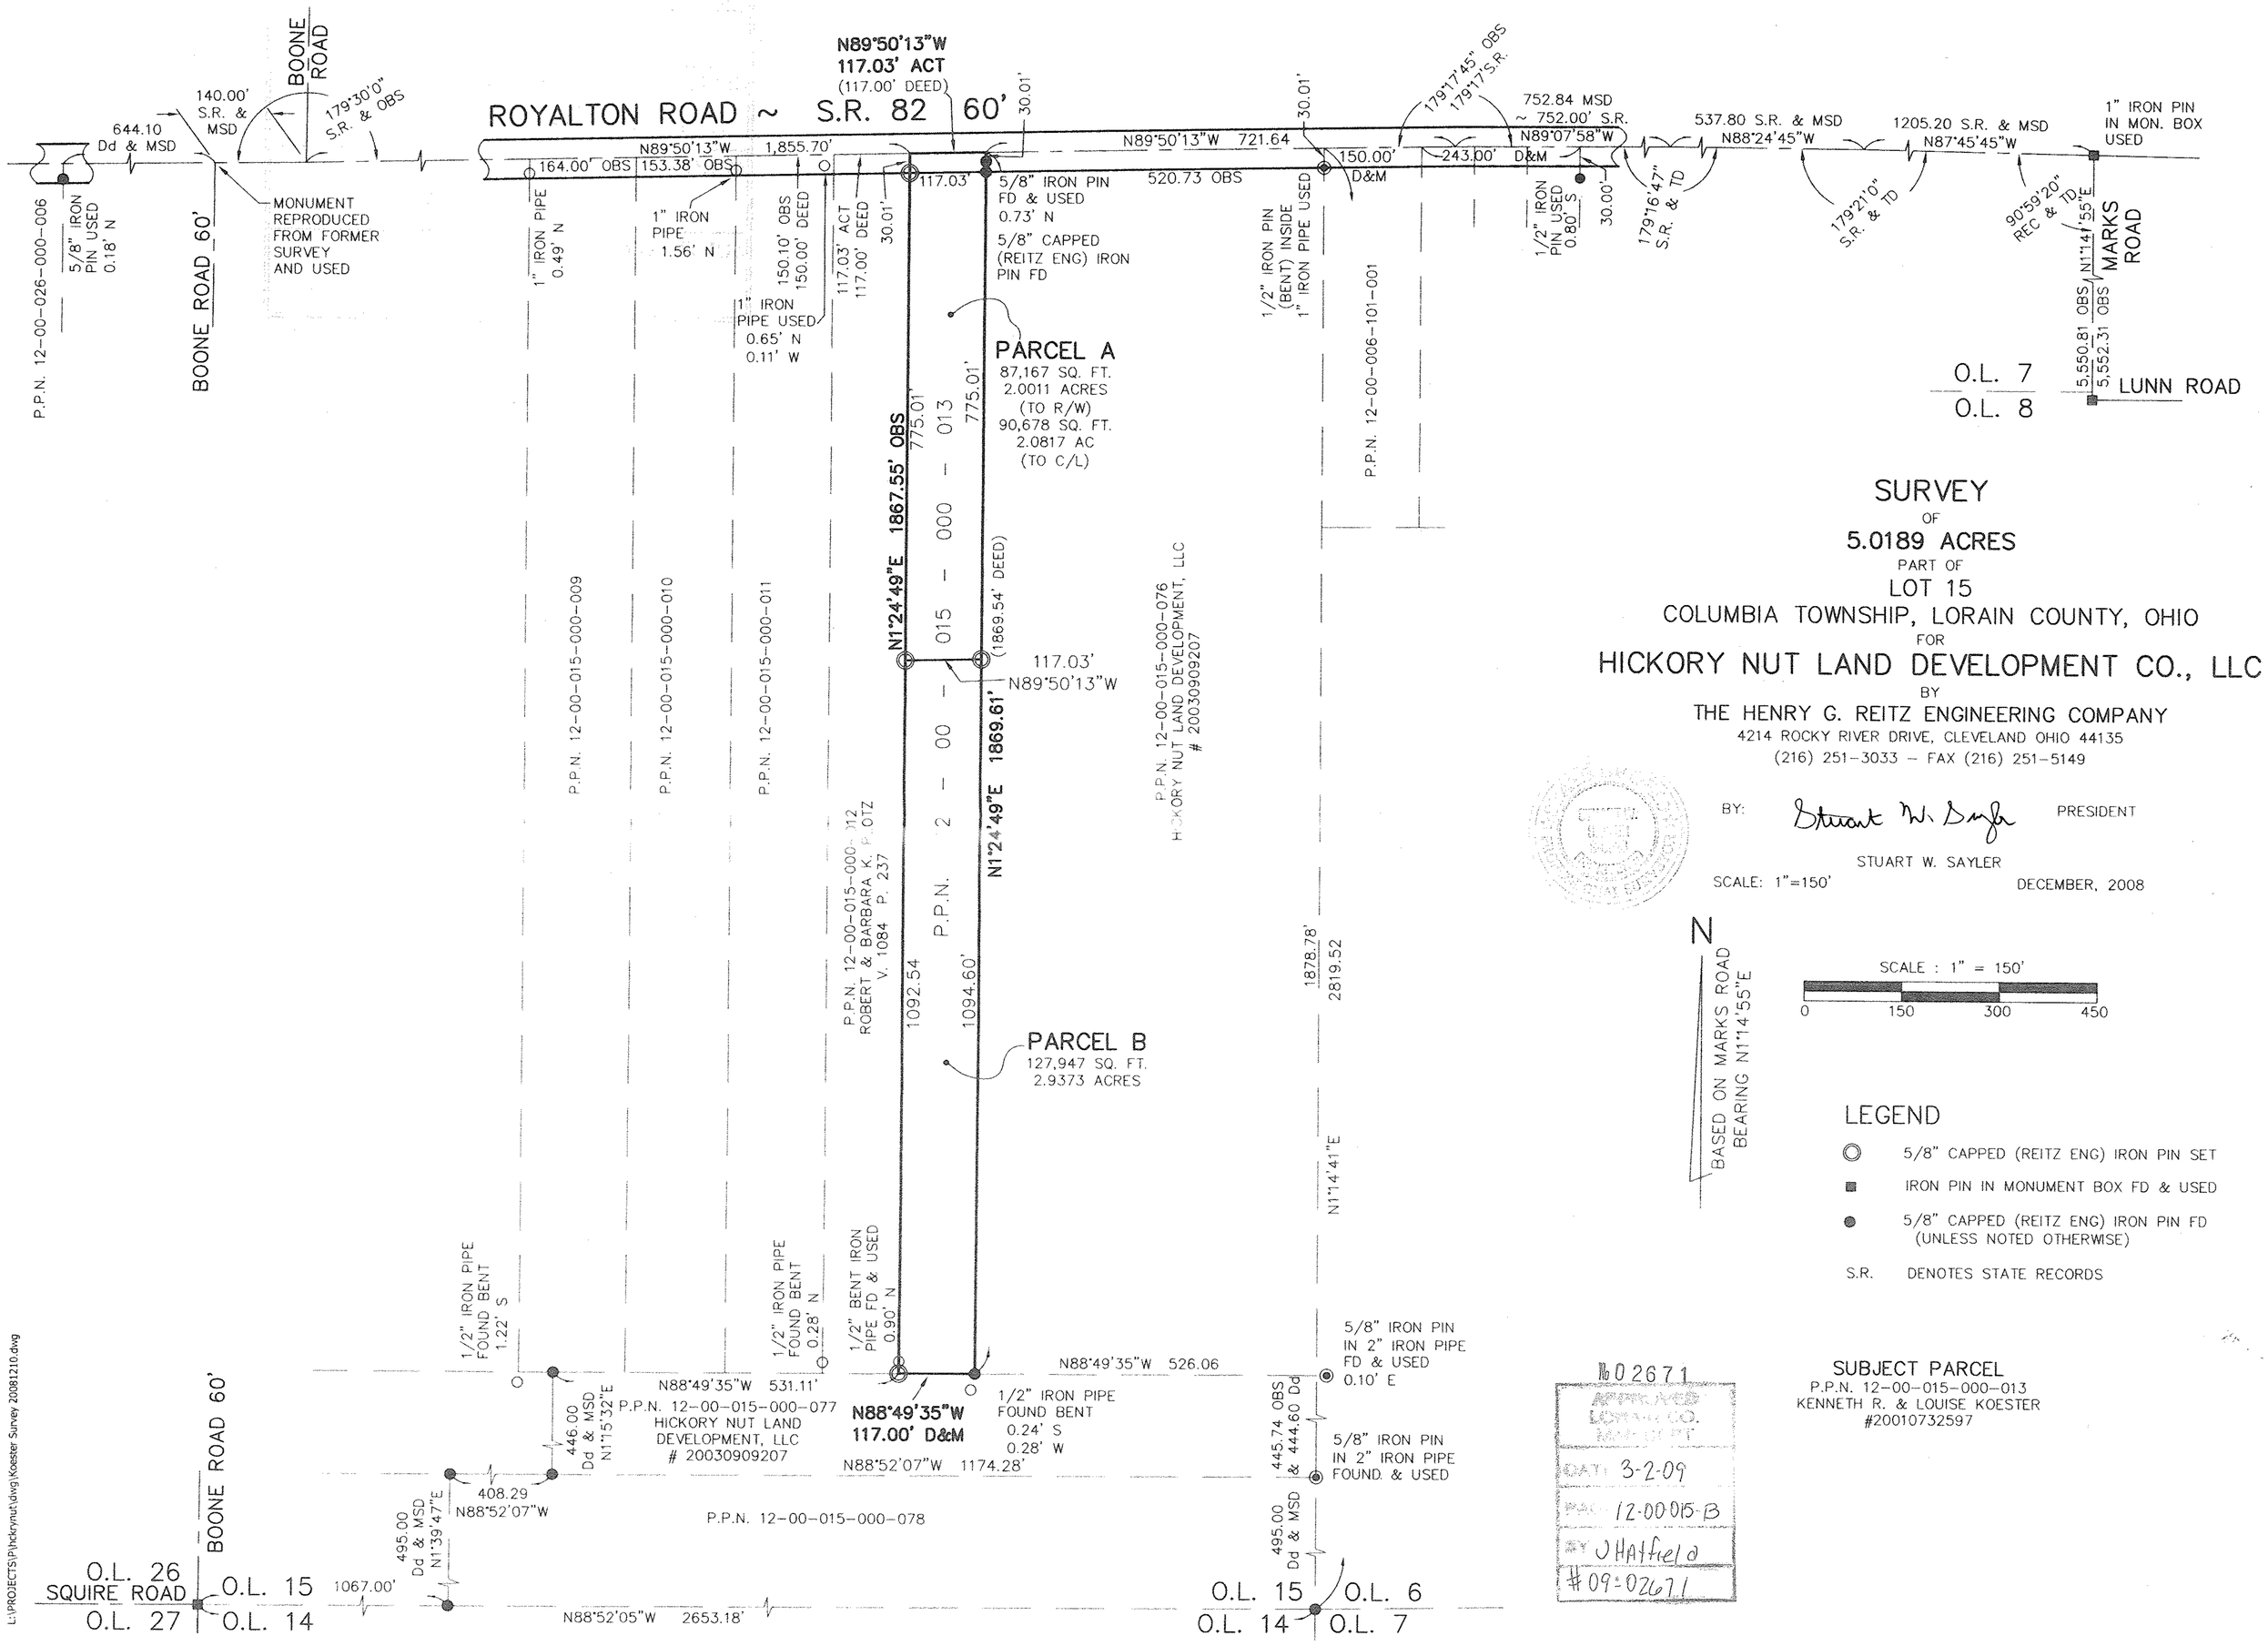

SURVEY
OF
5.0189 ACRES
PART OF
LOT 15
COLUMBIA TOWNSHIP, LORAIN COUNTY, OHIO
FOR
HICKORY NUT LAND DEVELOPMENT CO., LLC

BY
THE HENRY G. REITZ ENGINEERING COMPANY
4214 ROCKY RIVER DRIVE, CLEVELAND OHIO 44135
(216) 251-3033 – FAX (216) 251-5149

BY: Stuart W. Sayler PRESIDENT

STUART W. SAYLER

SCALE: 1"=150'

DECEMBER, 2008

N

BASED ON MARKS ROAD BEARING N1°14'55"E

SCALE : 1" = 150'

0 150 300 450

LEGEND

- ◎ 5/8" CAPPED (REITZ ENG) IRON PIN SET
- ■ IRON PIN IN MONUMENT BOX FD & USED
- ● 5/8" CAPPED (REITZ ENG) IRON PIN FD (UNLESS NOTED OTHERWISE)
- S.R. DENOTES STATE RECORDS

SUBJECT PARCEL
P.P.N. 12-00-015-000-013
KENNETH R. & LOUISE KOESTER
#20010732597

02671
APPROVED
LORAIN CO.
DATE 3-2-09
P.P.N. 12-00-015-B
BY JHatfield
#09-02671

L:\PROJECTS\P\hickrynut\dwg\Koester Survey 20081210.dwg