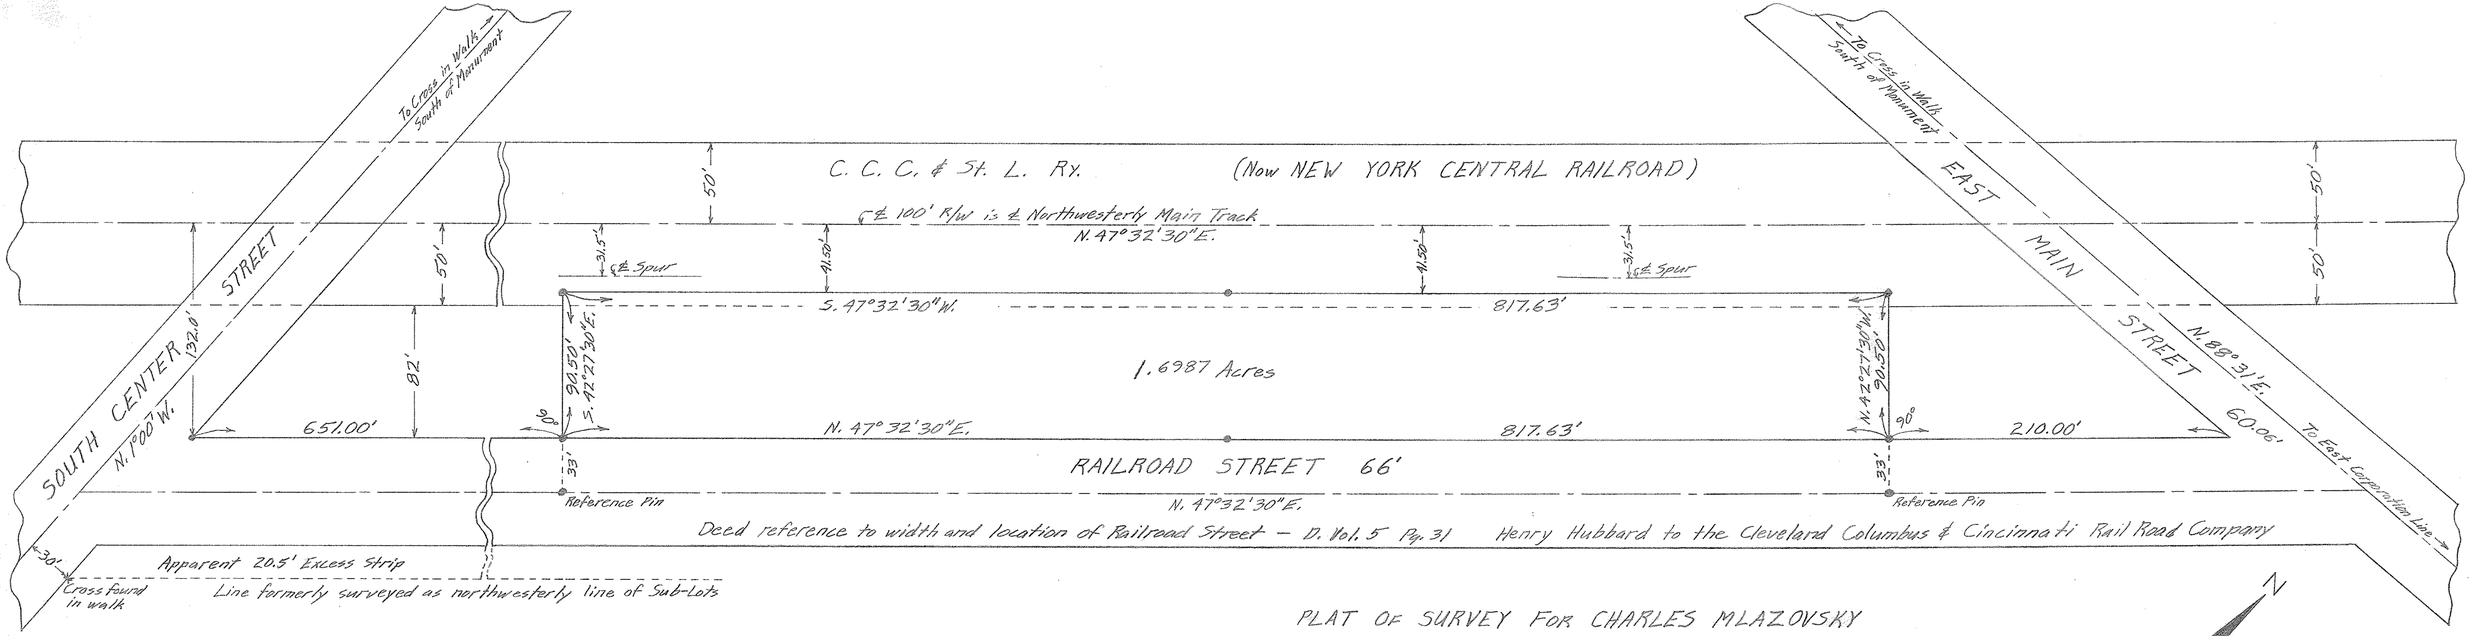

NOTE: ● indicates iron pin set

PLAT OF SURVEY FOR CHARLES MLAZOVSKY
PART OF RIGHT-OF-WAY OF NEW YORK CENTRAL RR. CO.
ORIGINAL LOT 55 LAGRANGE TOWNSHIP
LAGRANGE VILLAGE LORAIN COUNTY OHIO
SCALE: 1"=50' MARCH 1963
GARY E. PENFOUND REGISTERED SURVEYOR NO. 4457

15-00-055