PLAT OF SURVEYS FOR
EMERY J. HORVATH

ORIGINAL LOT 90 - LAGRANGE TWP.
LORAIN COUNTY - OHIO
SCALE: 1" = 100' JANUARY - 1980
Gary E. Penfound - Reg. Surveyor No. 4957

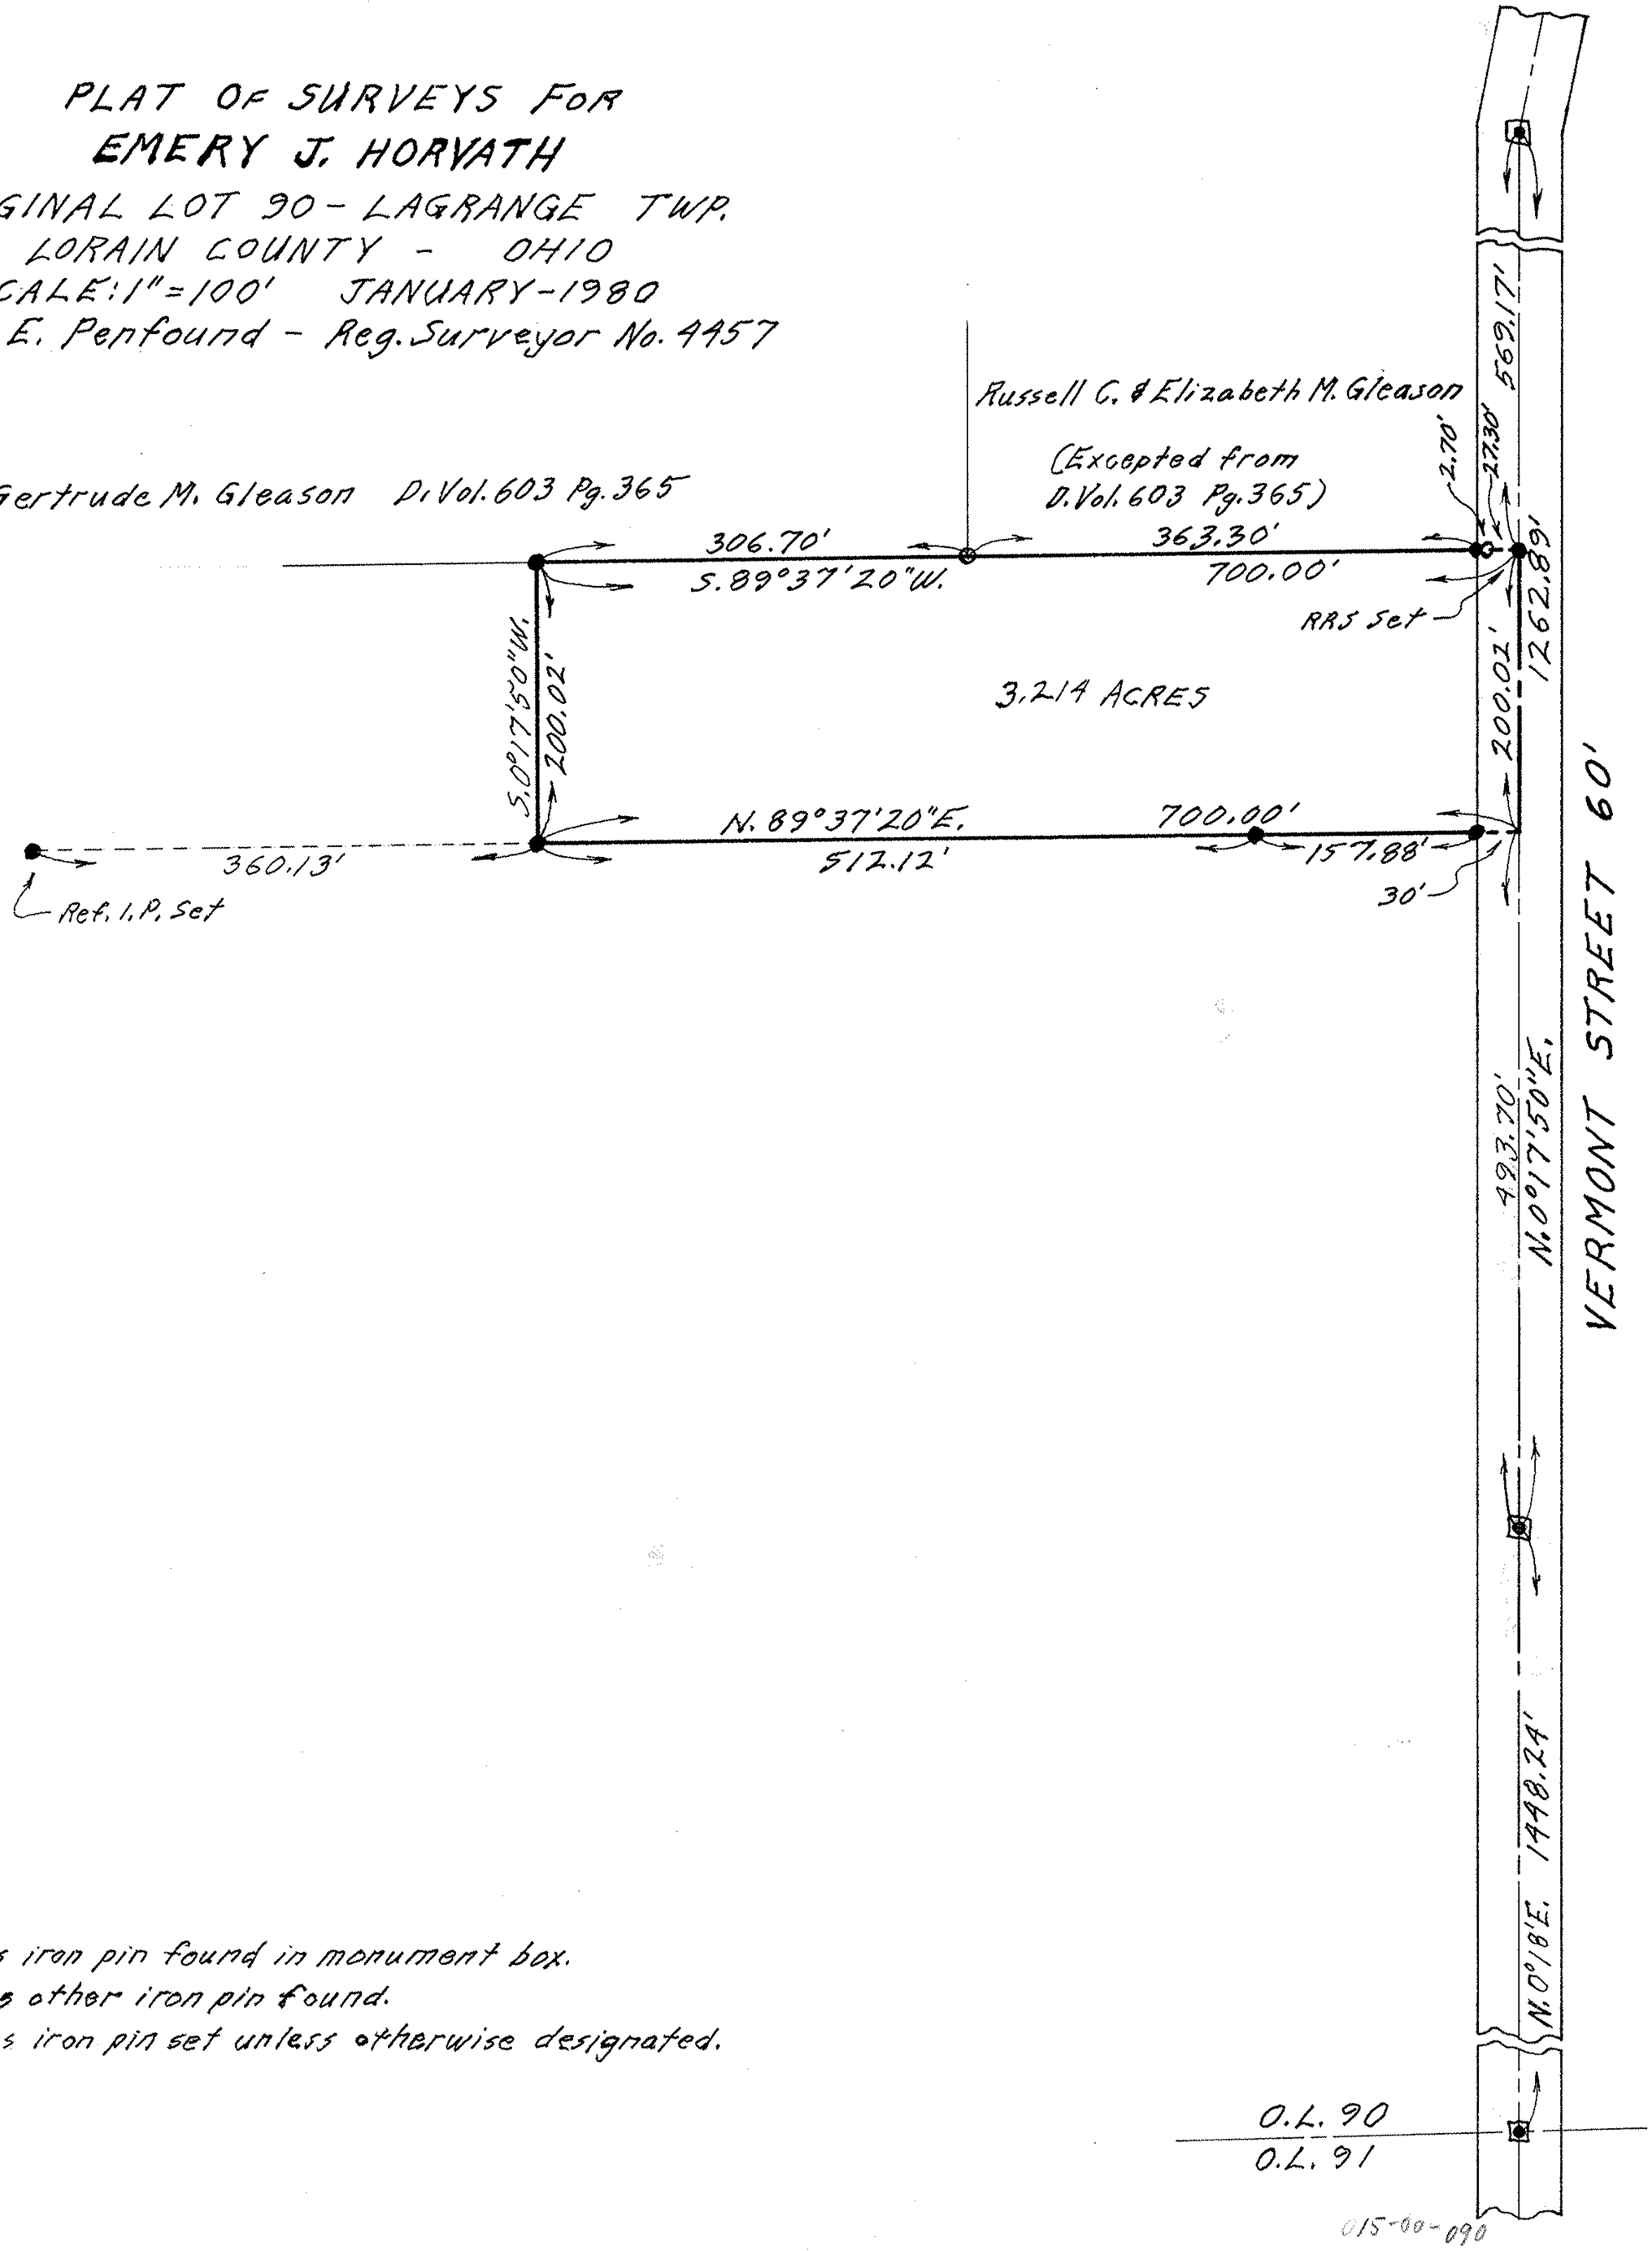

NOTES: ⊡ indicates iron pin found in monument box.
○ indicates other iron pin found.
● indicates iron pin set unless otherwise designated.

015-00-090