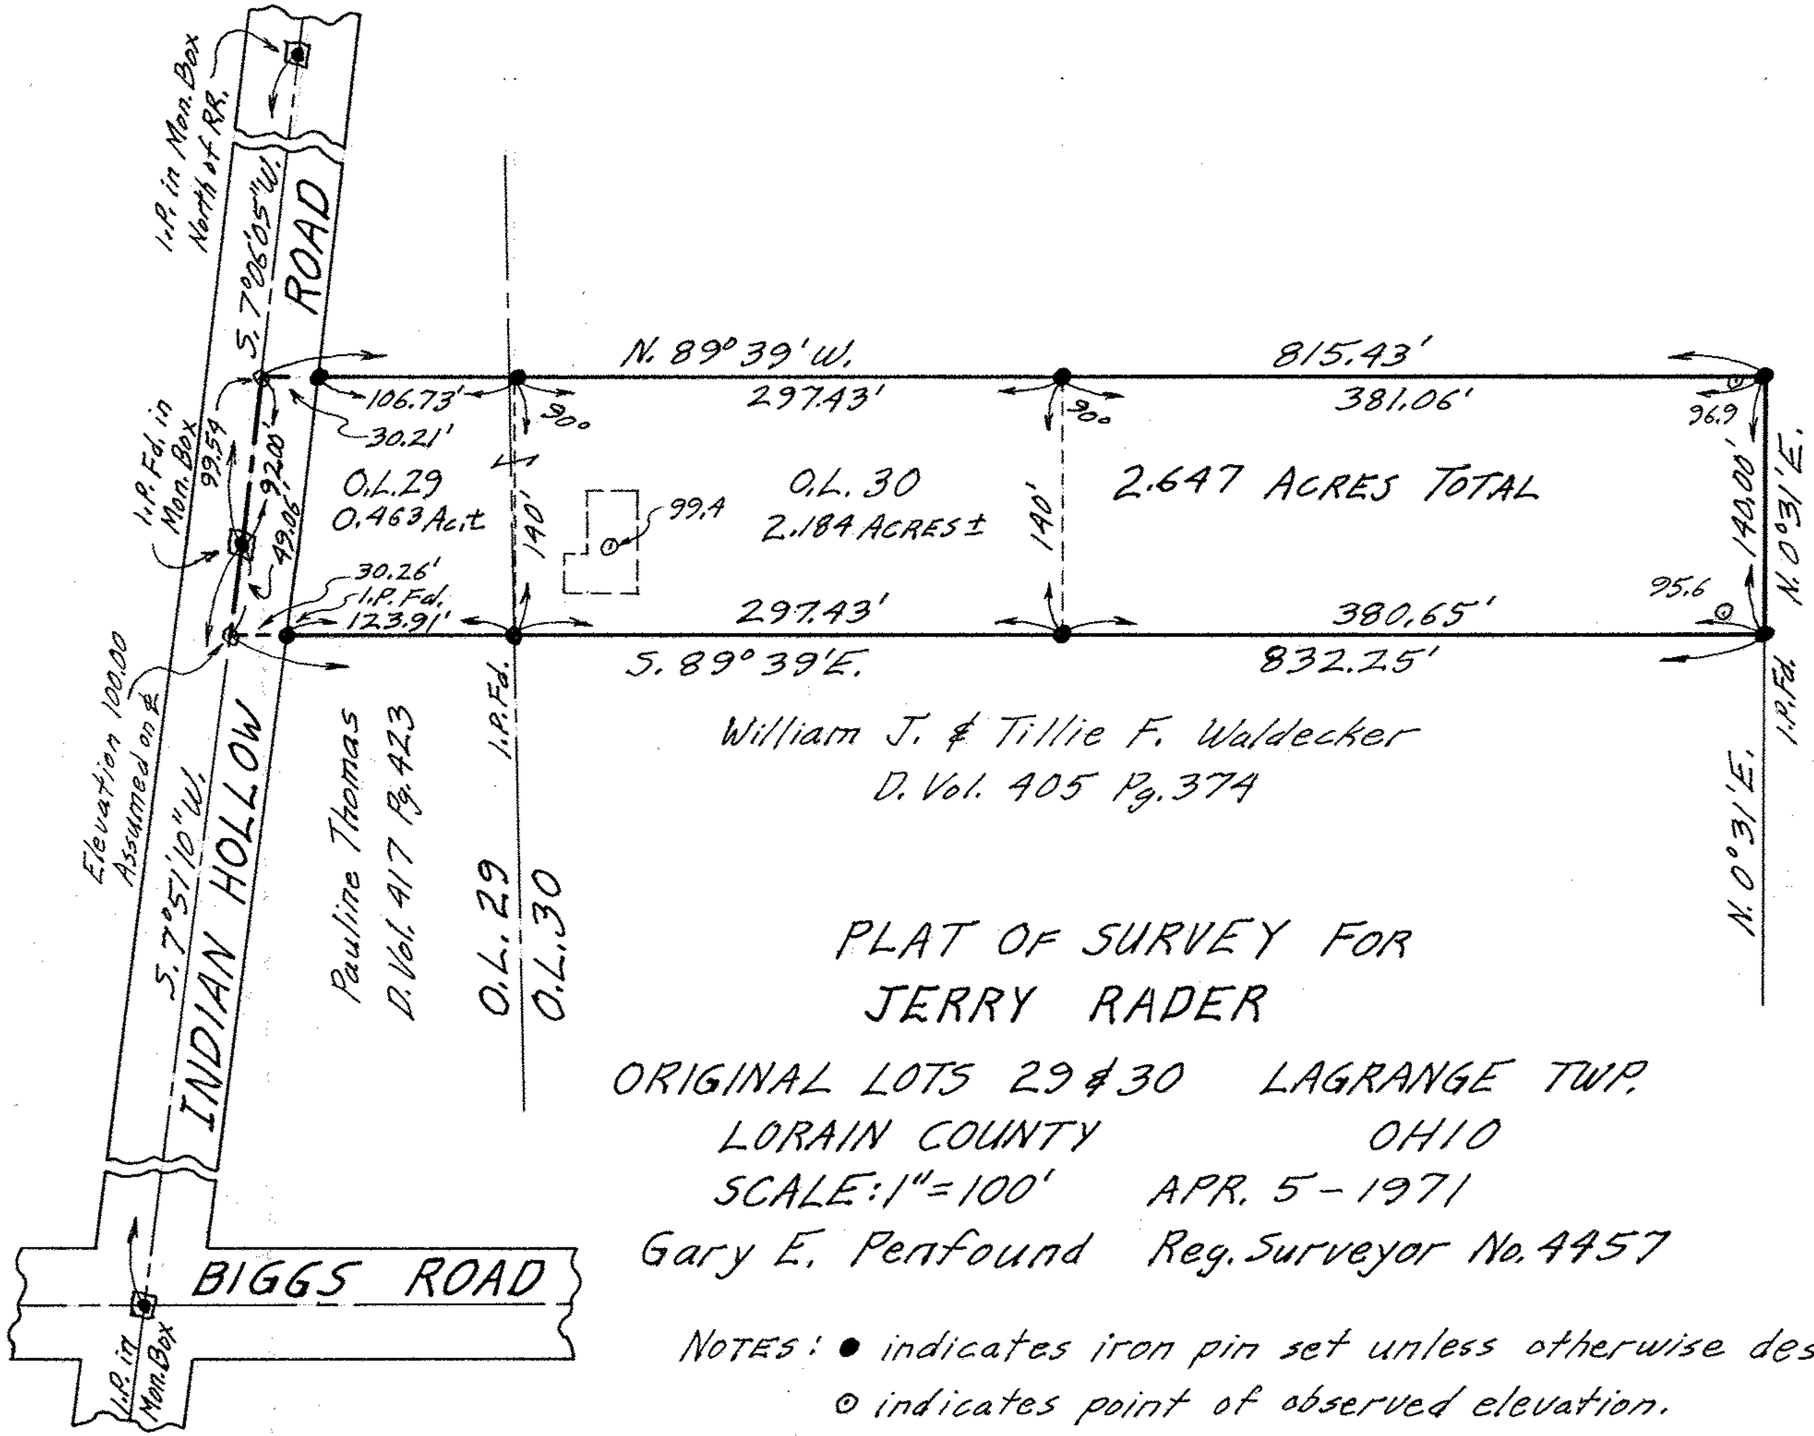

PLAT OF SURVEY FOR
JERRY RADER

ORIGINAL LOTS 29 & 30 LAGRANGE TWP.
LORAIN COUNTY OHIO
SCALE: 1" = 100' APR. 5 - 1971
Gary E. Penfound Reg. Surveyor No. 4457

NOTES: ● indicates iron pin set unless otherwise designated.
⊙ indicates point of observed elevation.

15-00-029,030