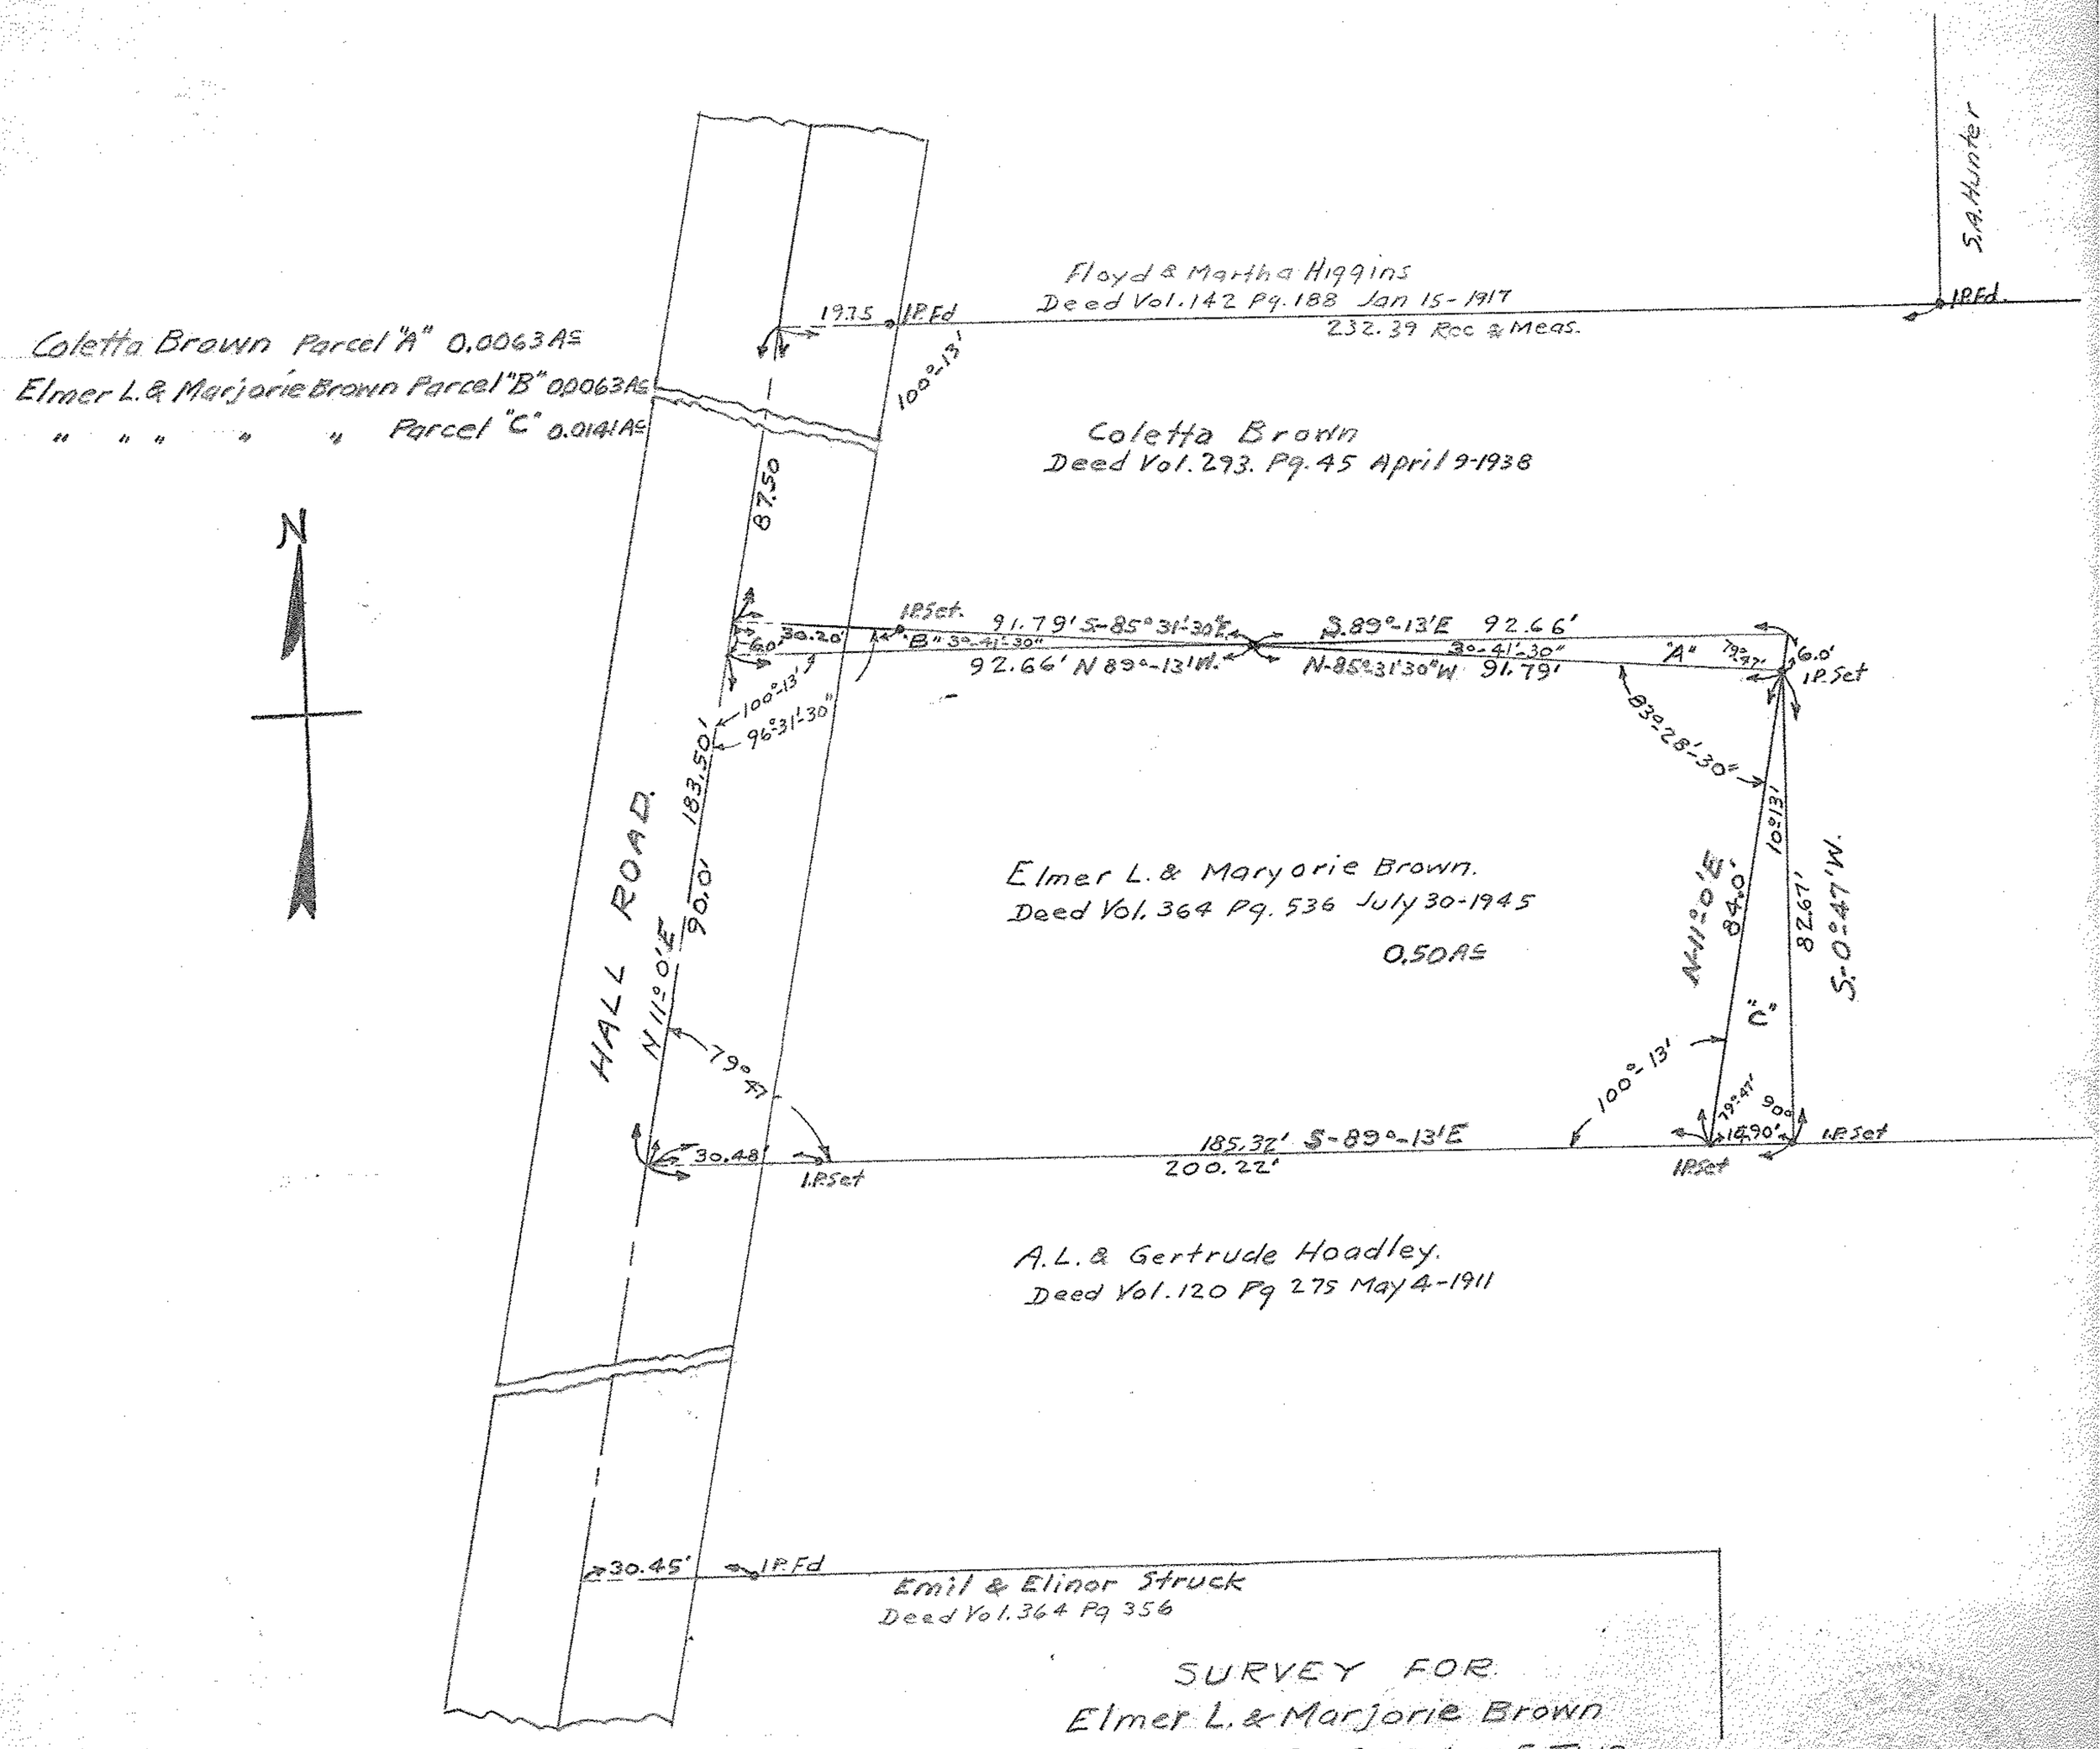

SURVEY FOR
Elmer L. & Marjorie Brown
SECTION 3 CARLISLE TWP.
LORAIN COUNTY OHIO
Scale 1" = 30 Feet May 6-1947
C.E. Penfound Registered Surveyor

10-00-003