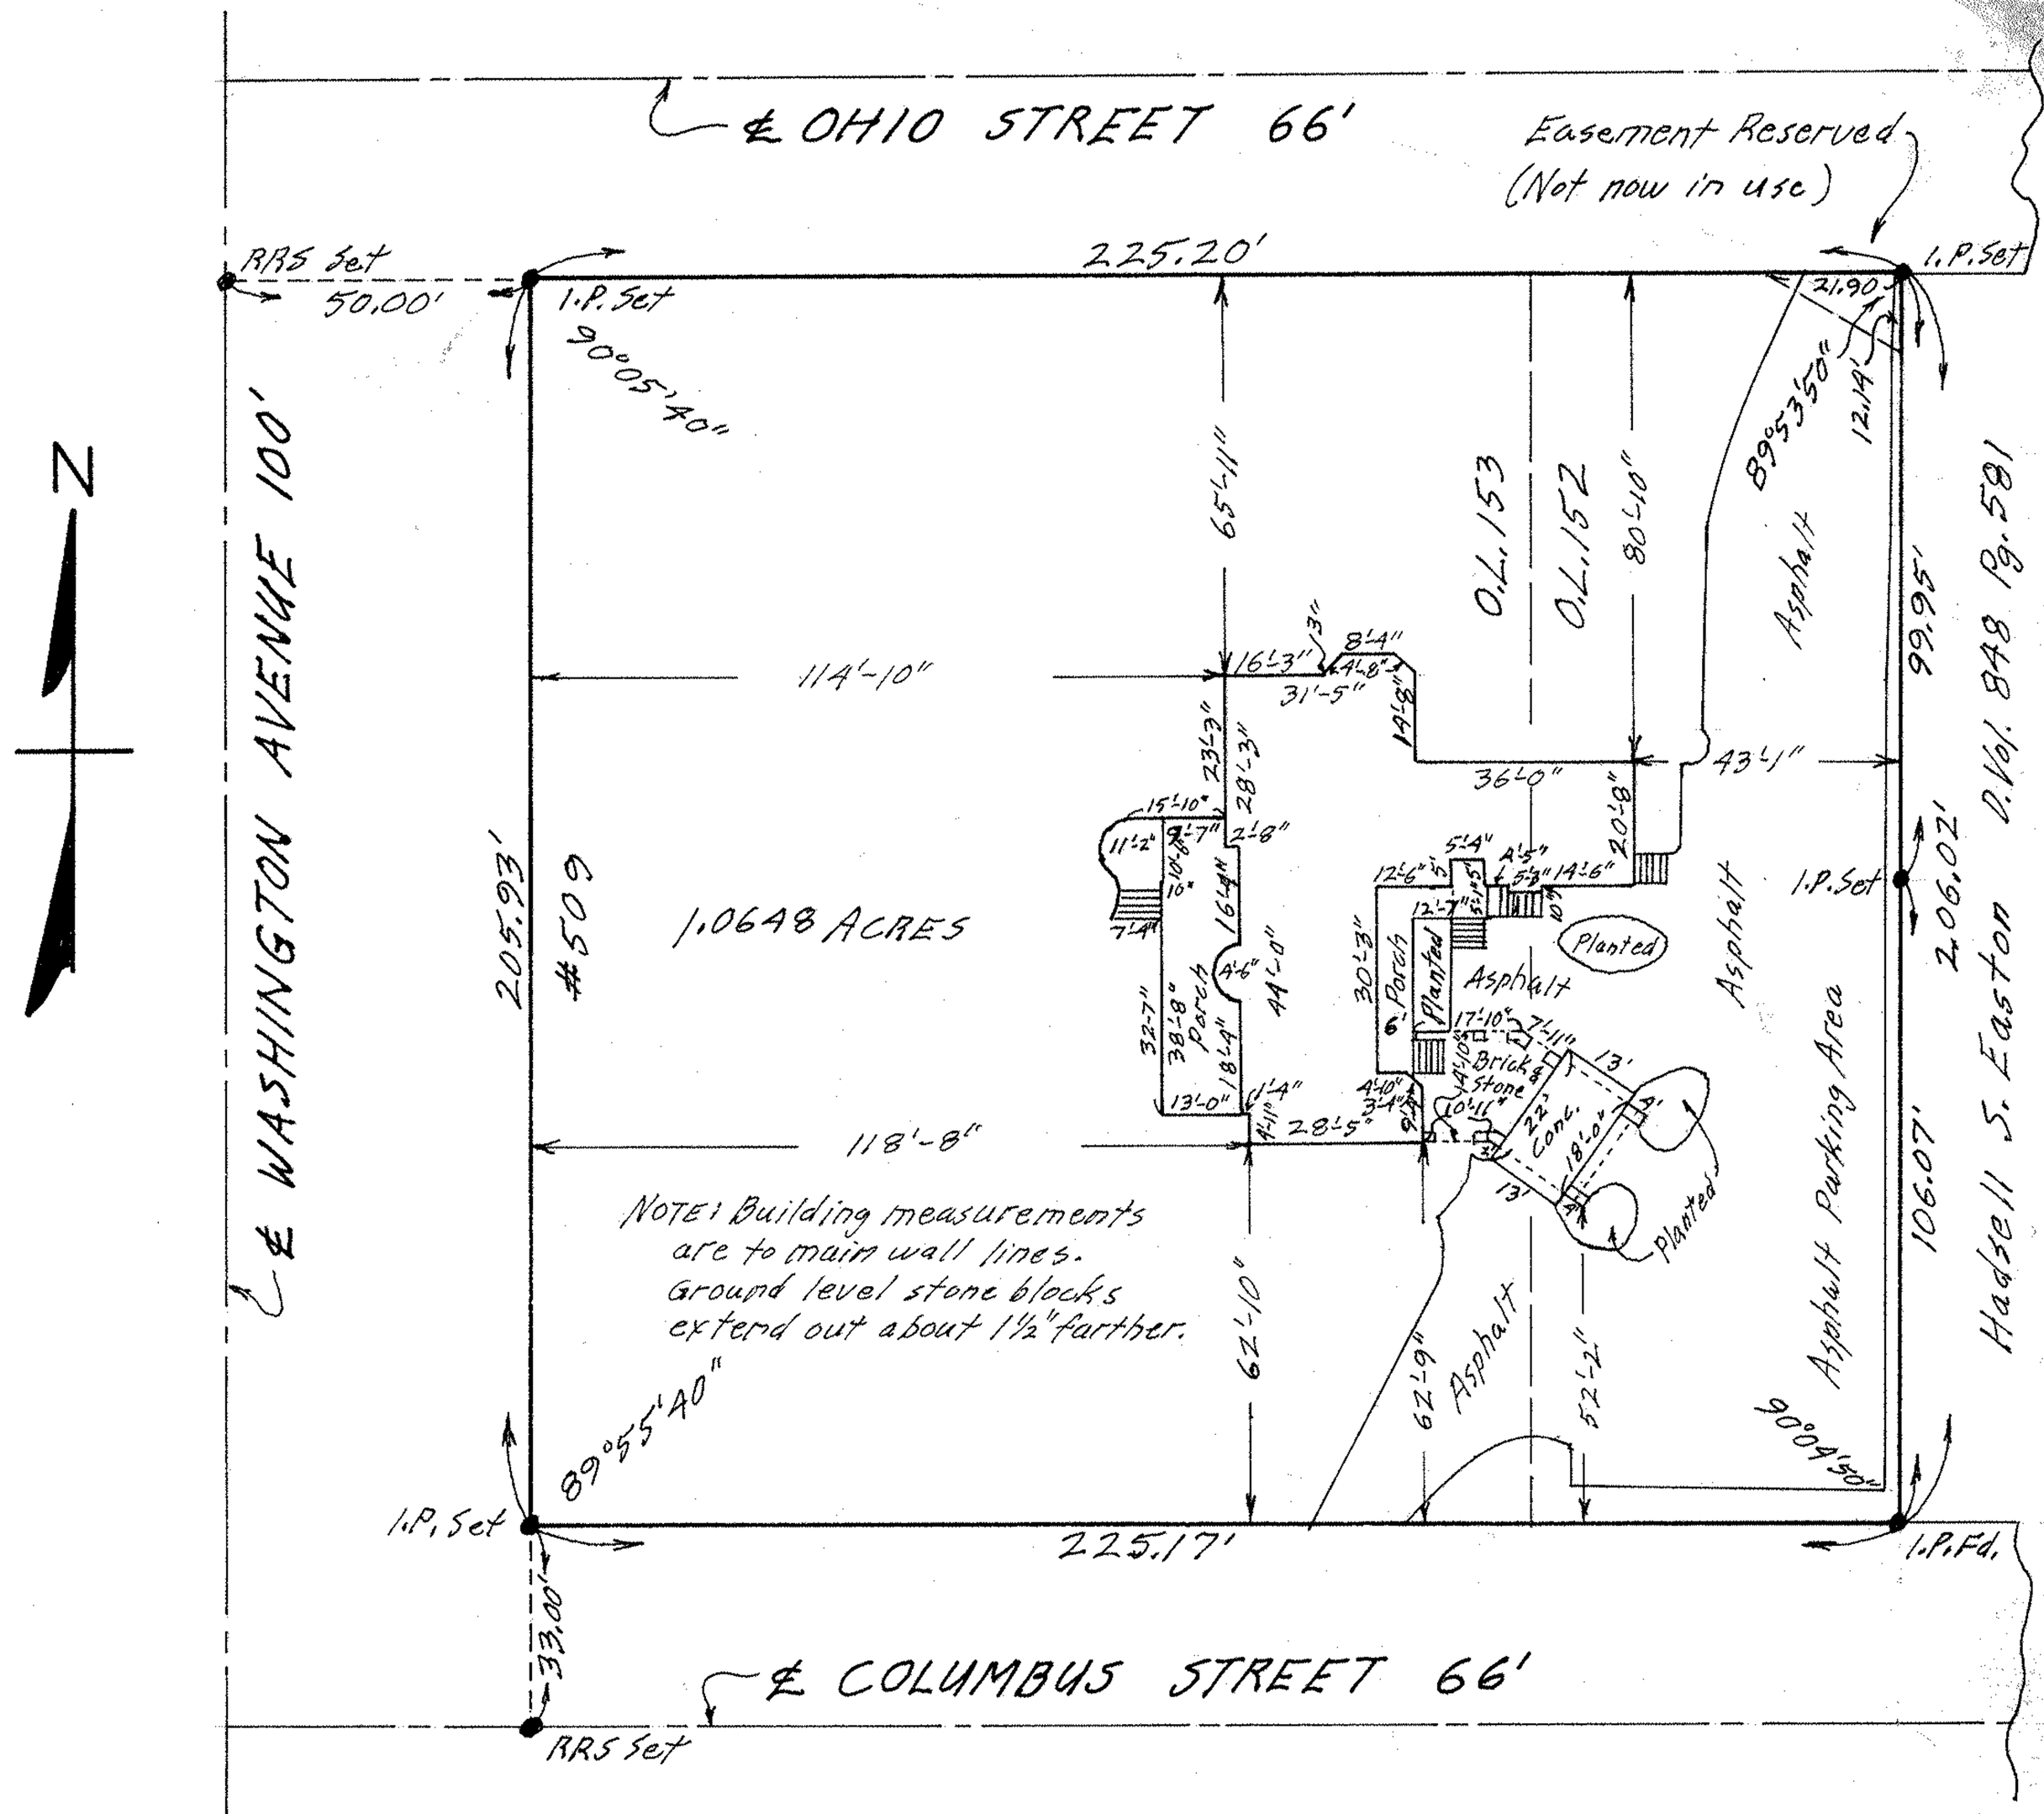

PLAT OF SURVEY FOR
THE LORAIN COUNTY HISTORICAL SOCIETY

PROPERTY FROM J.R. & LEONA M. HANDYSIDE
ORIGINAL LOT 153 AND PART OF ORIGINAL LOT 152
EAST OF RIVER – ELYRIA TOWNSHIP – ELYRIA CITY
LORAIN COUNTY OHIO
SCALE: 1" = 30' JULY 15-1975 3:30 P.M.
Gary E. Penfound Reg. Surveyor No. 4457
There are no encroachments on this property.

06-25-152,153